

OUTSIDE

1919

VOL. 5

O-Z

Book 5 - O. E. J. Vol 5

Assessors Map Book
of
SACRAMENTO COUNTY
(Outside City Limits)
Accompanying Assessors Roll
for
1919

I hereby certify that the following is a true and correct Map of the lands embraced within the boundaries of **SACRAMENTO COUNTY (Outside City Limits)** exclusive of Sacramento City as drawn and compiled by me from official data and surveys of record.

Sacramento March 1st 191

County Surveyor.

Mapped.



Blanks to Sacto. Suburban Fruit Lands Co.
All Lots 10 Acres unless otherwise noted.

OAKDALE

located in
Secs 33-38-47 Rancho Del Poso
Scale: 1"=500'

Black Ink-1919 Ownership
Red Ink-1920 Ownership

Center S.D.

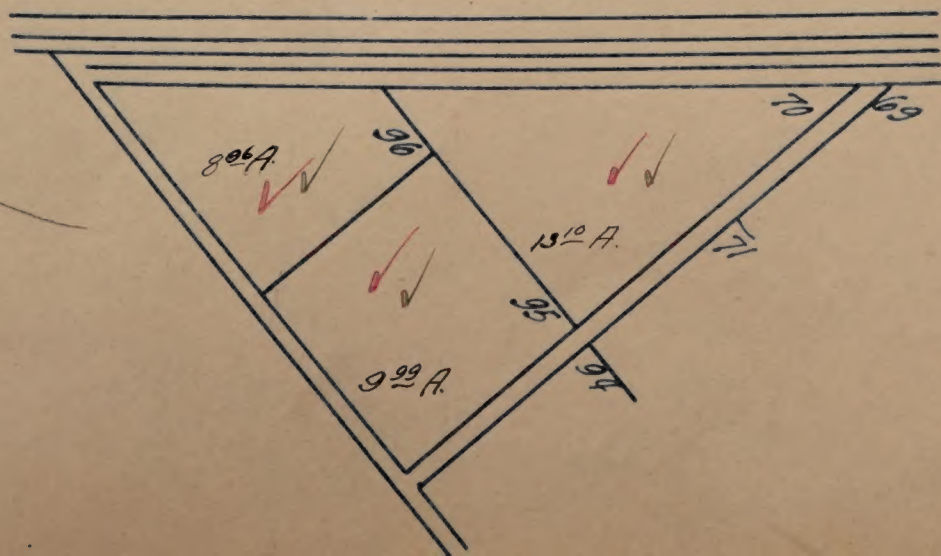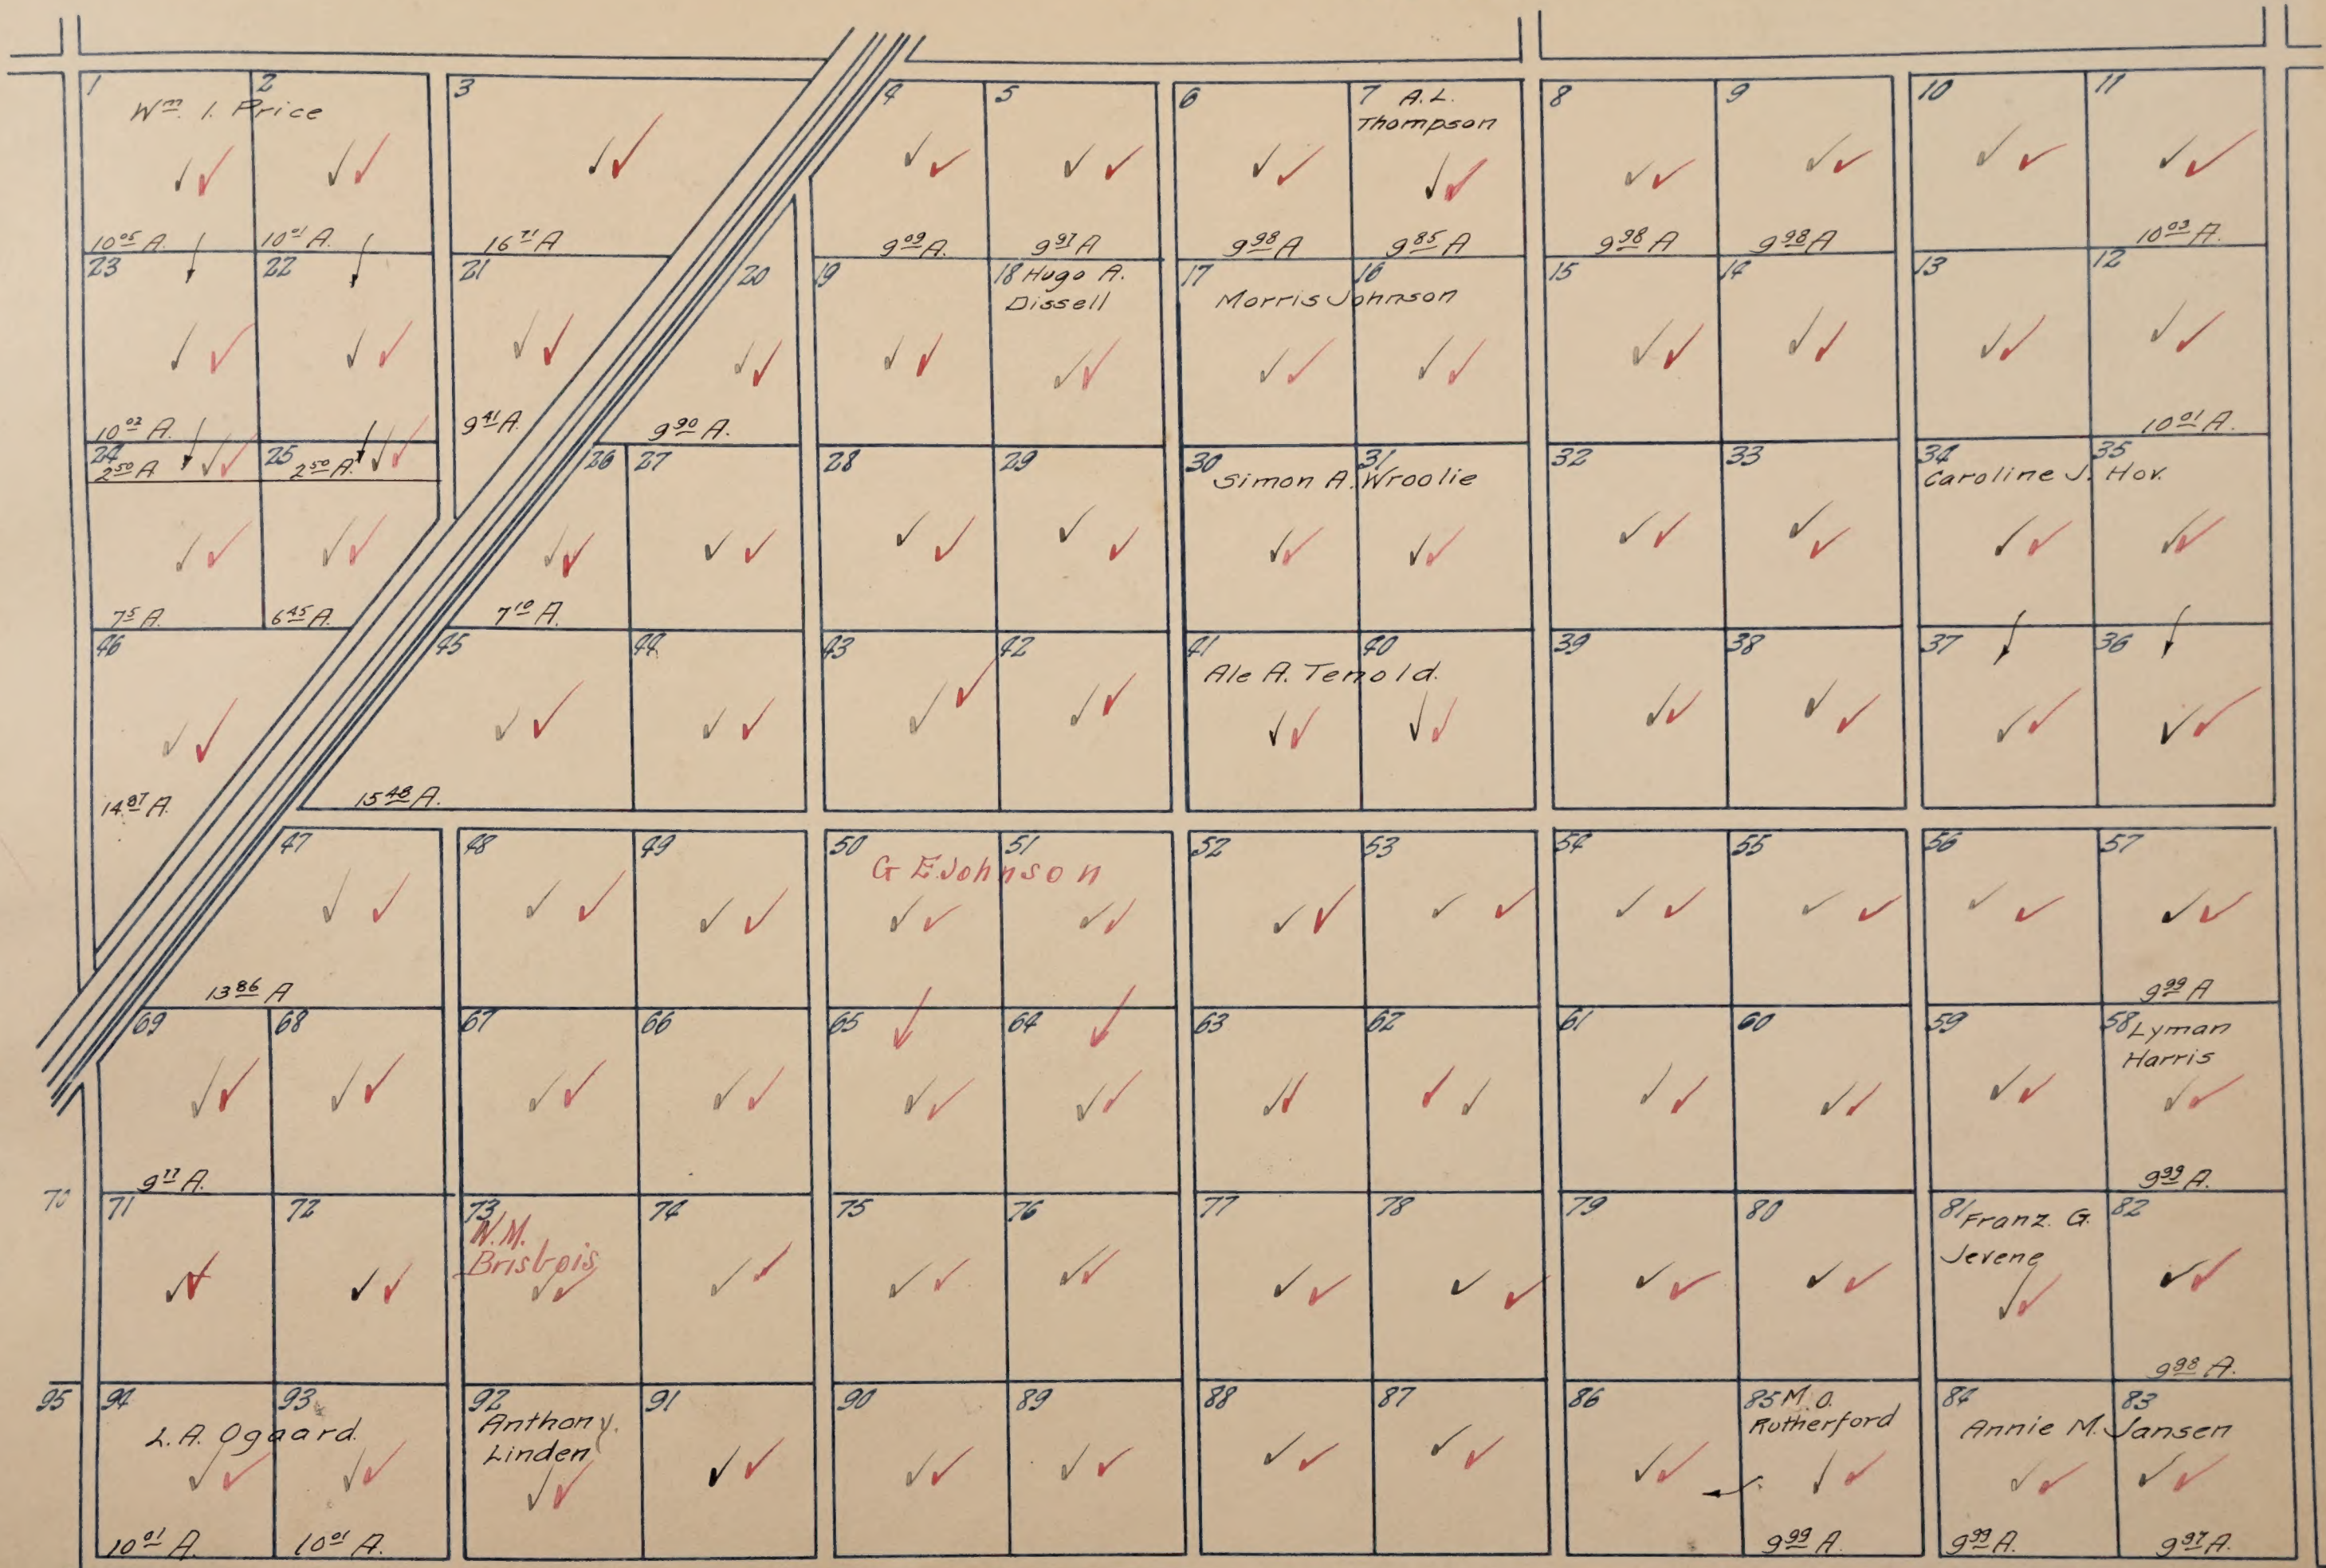

mapped.


Black Ink-1919 Ownership
Red Ink-1920 Ownership

OAK FIELD

located in
Section 63 Rancho Del Paso
Scale 1" = 5 Chains

Arden.
Arden S.D.

Blanks to Julia Eastman ✓
All Lots 10 Acres unless otherwise noted

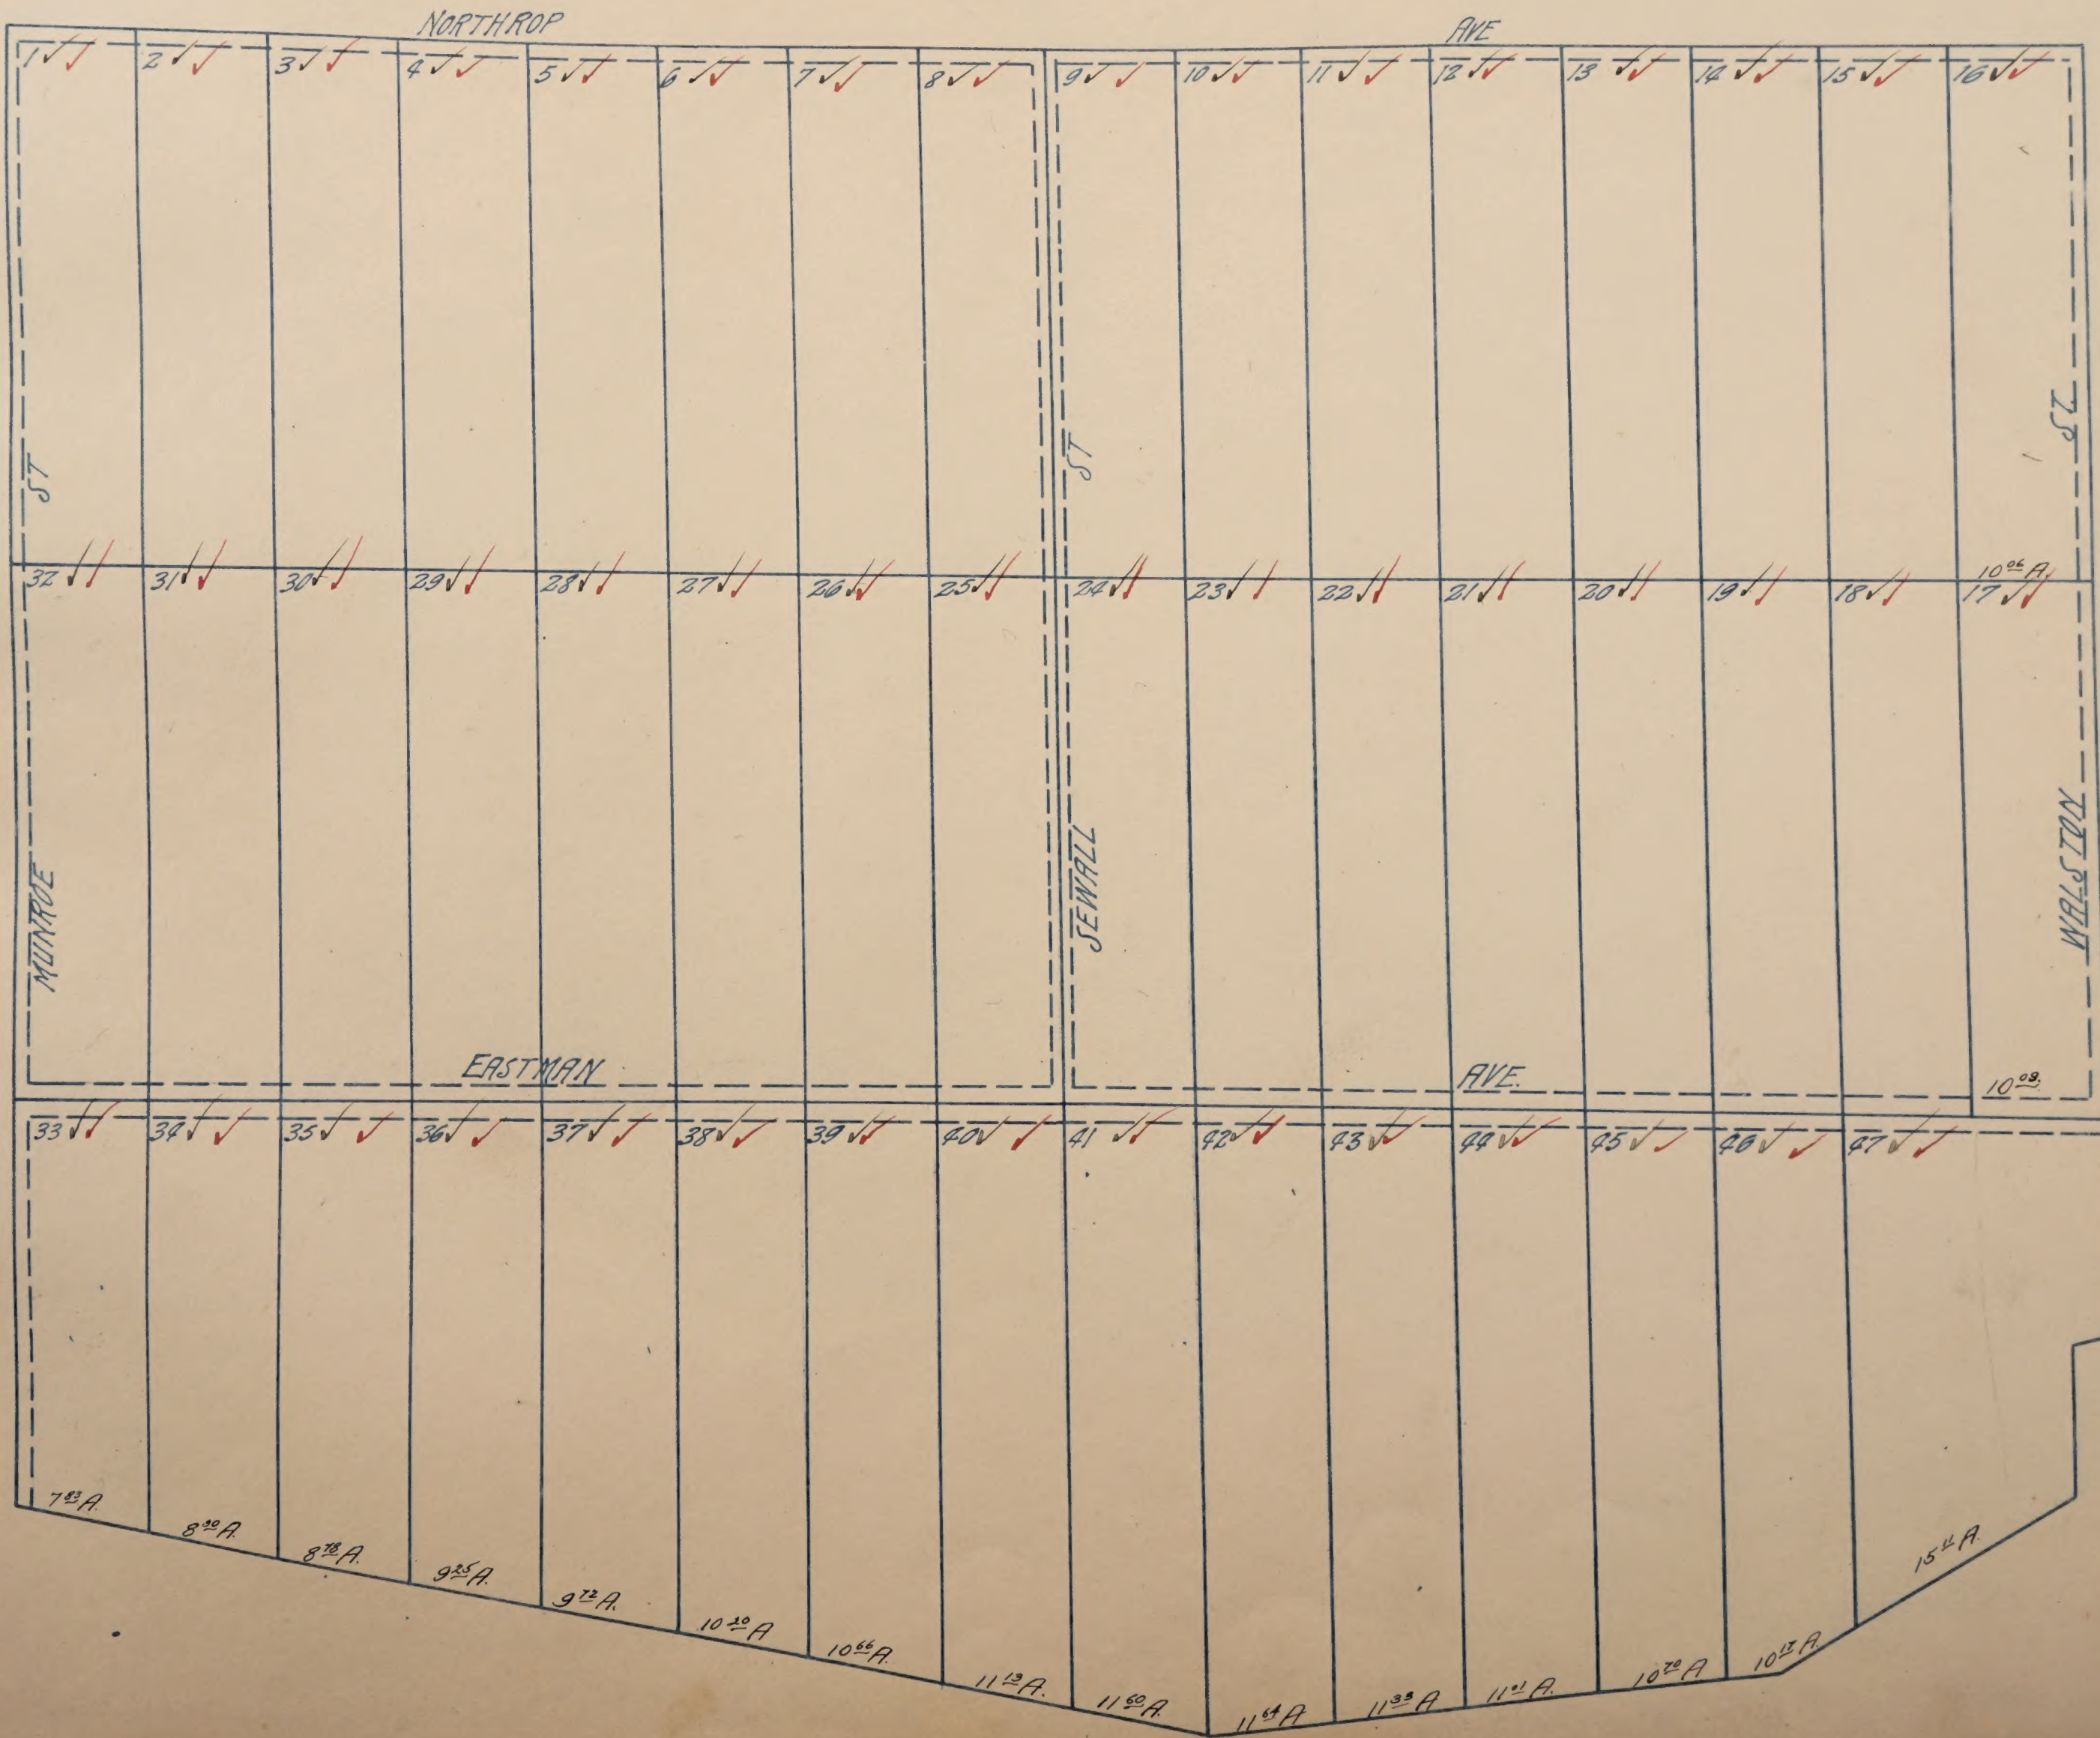

Mapped.

Black Ink-1919 Ownership
Red Ink-1920 Ownership


OAK KNOLL

LOCATED IN
N¹/₂ of Sec. 3 In Rancho Del Paso

Scale 400' = 1"

Blanks to Chas. E. Meister. ✓

Del Paso Hts. L.D.

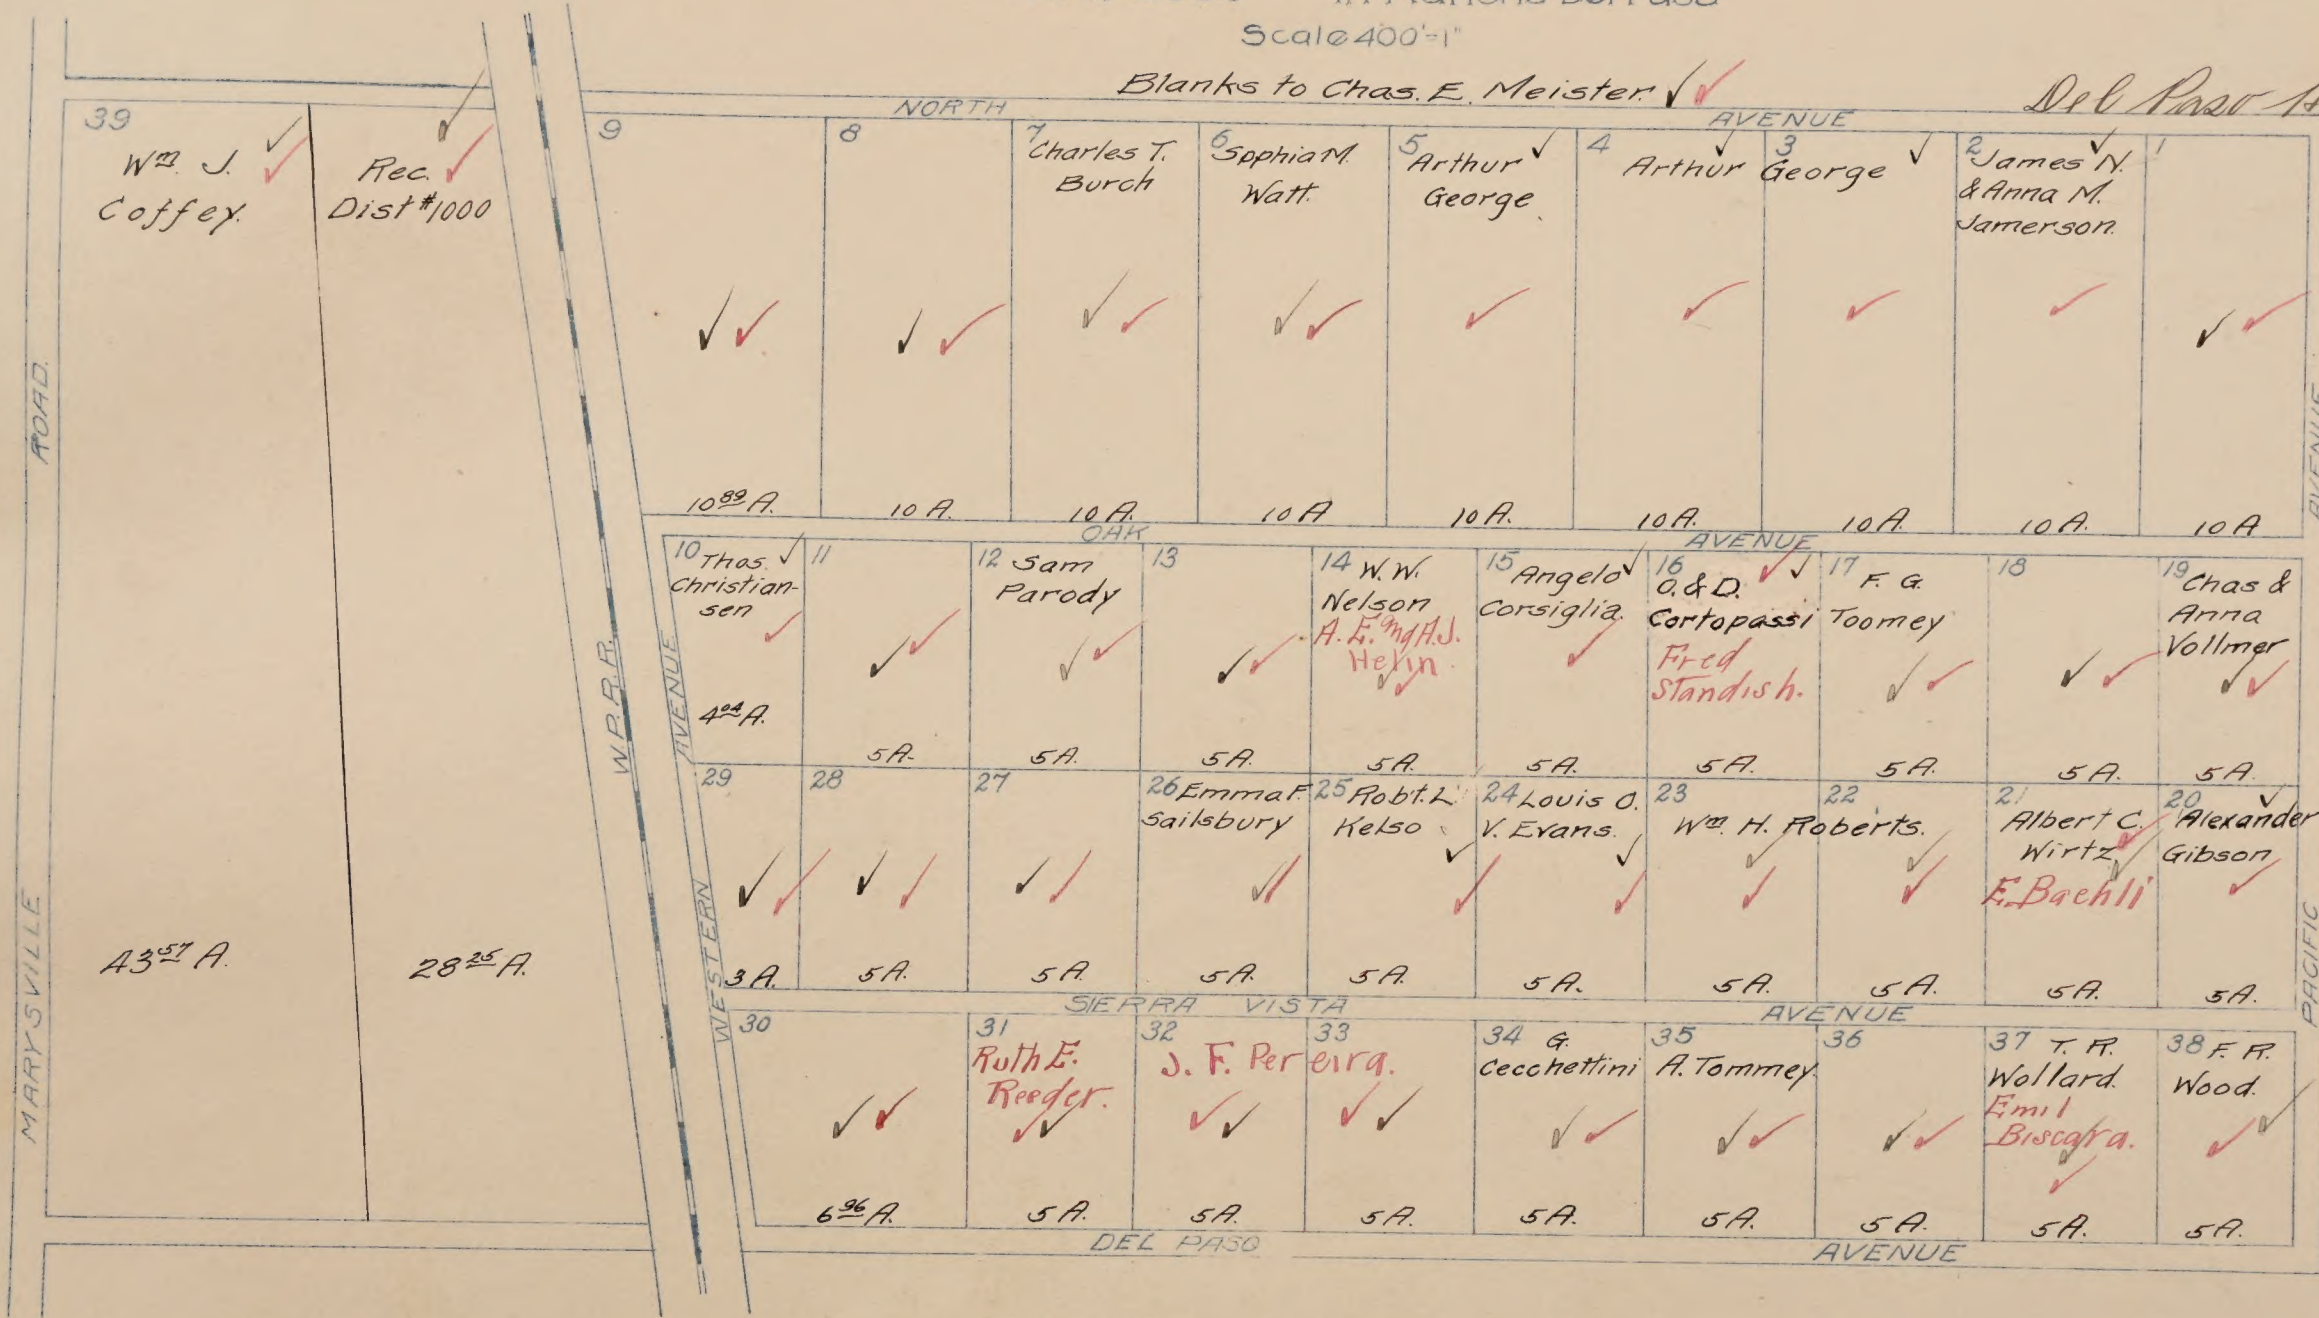

Mapped.

Black Ink-1919 Ownership
Red Ink-1920 Ownership

OAK PLAINS SUB. NO. 1


located in
S 1/2 Sec. 40 N 1/2 Sec. 41 Rancho Del Paso
Scale: 1"=400'

Aracade S.D.

Blanks to United States Farm Lands Co. ✓✓

ARCADE PARK

All Lots 10 Acres unless otherwise noted.

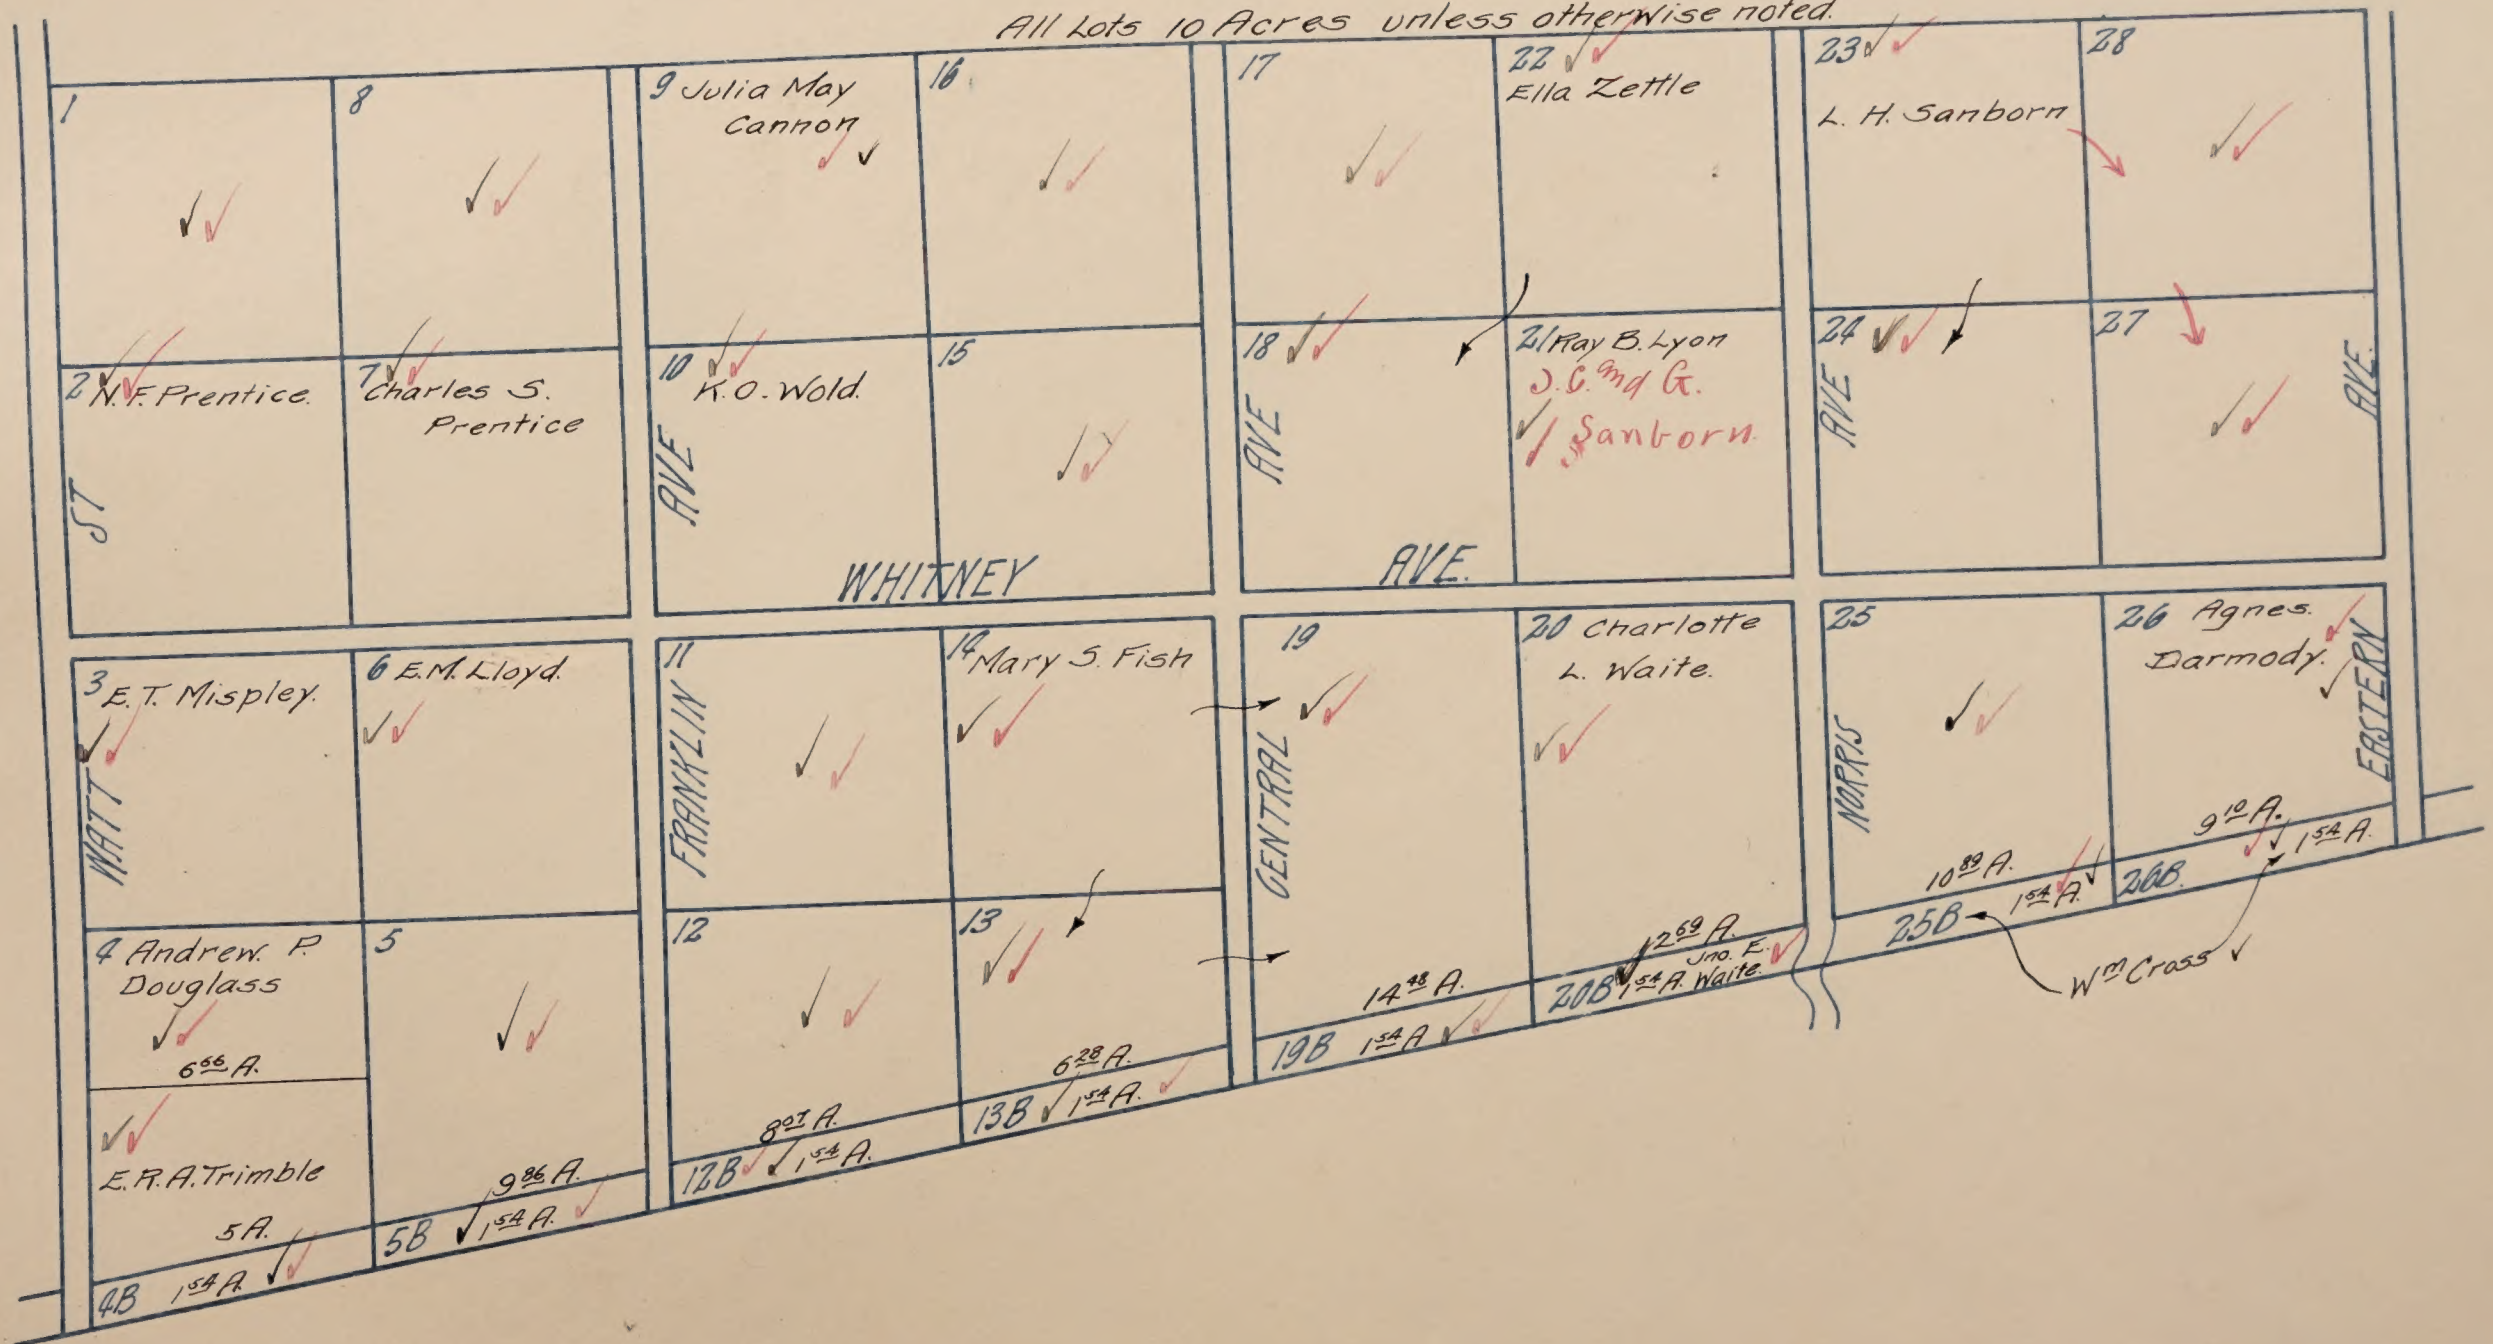

Mapped.


Black Ink-1919 Ownership
Red Ink-1920 Ownership

OAK PLAINS SUB. NO. 2

located in
S. 1/2 of Sec 40 N. 1/2 Sec 41 Rancho Del Paso
Scale: 1" = 400'

Arco de S.D.

Blanks to United States Farm Lands Co. ✓
All lots 10 Acres unless otherwise noted.

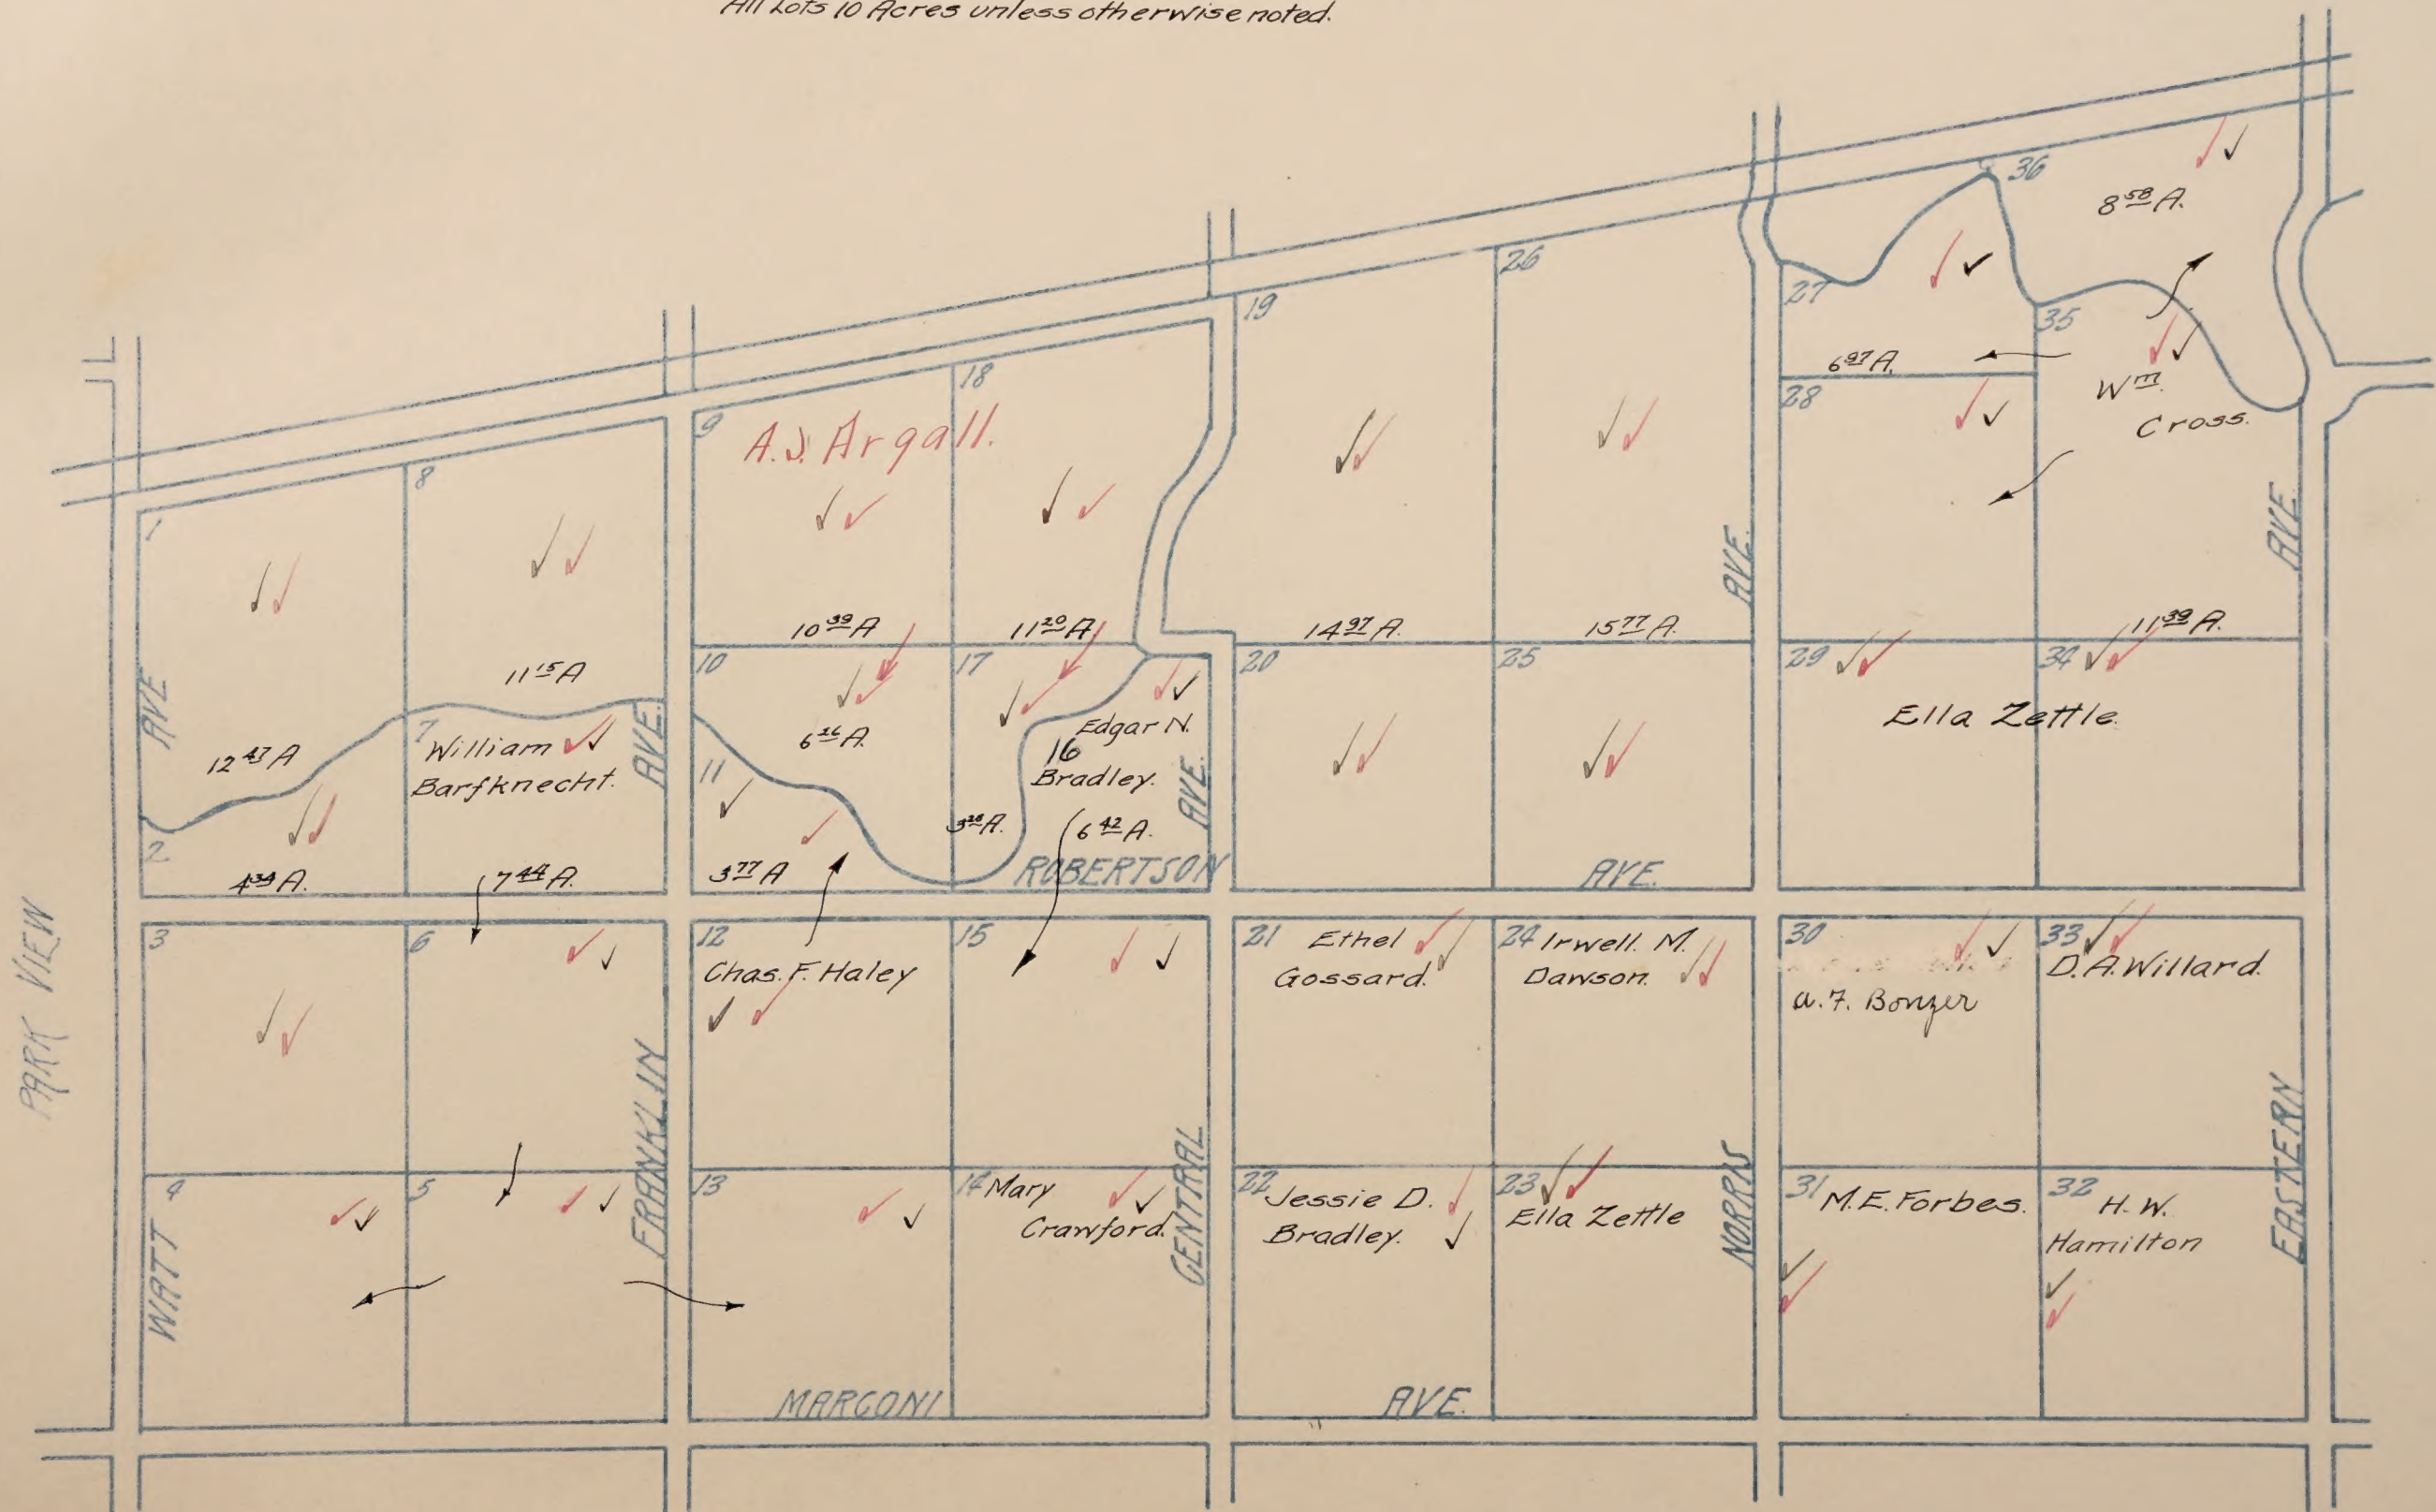


Black Ink-1970 Ownership
Red Ink-1971 Ownership

located in
Sec's 12-17 Rancho Del Paso
Scale 1"=

Blanks to N.S.L. Co. ✓
All Lots 1 Acre unless otherwise noted.

~~Acad 50~~

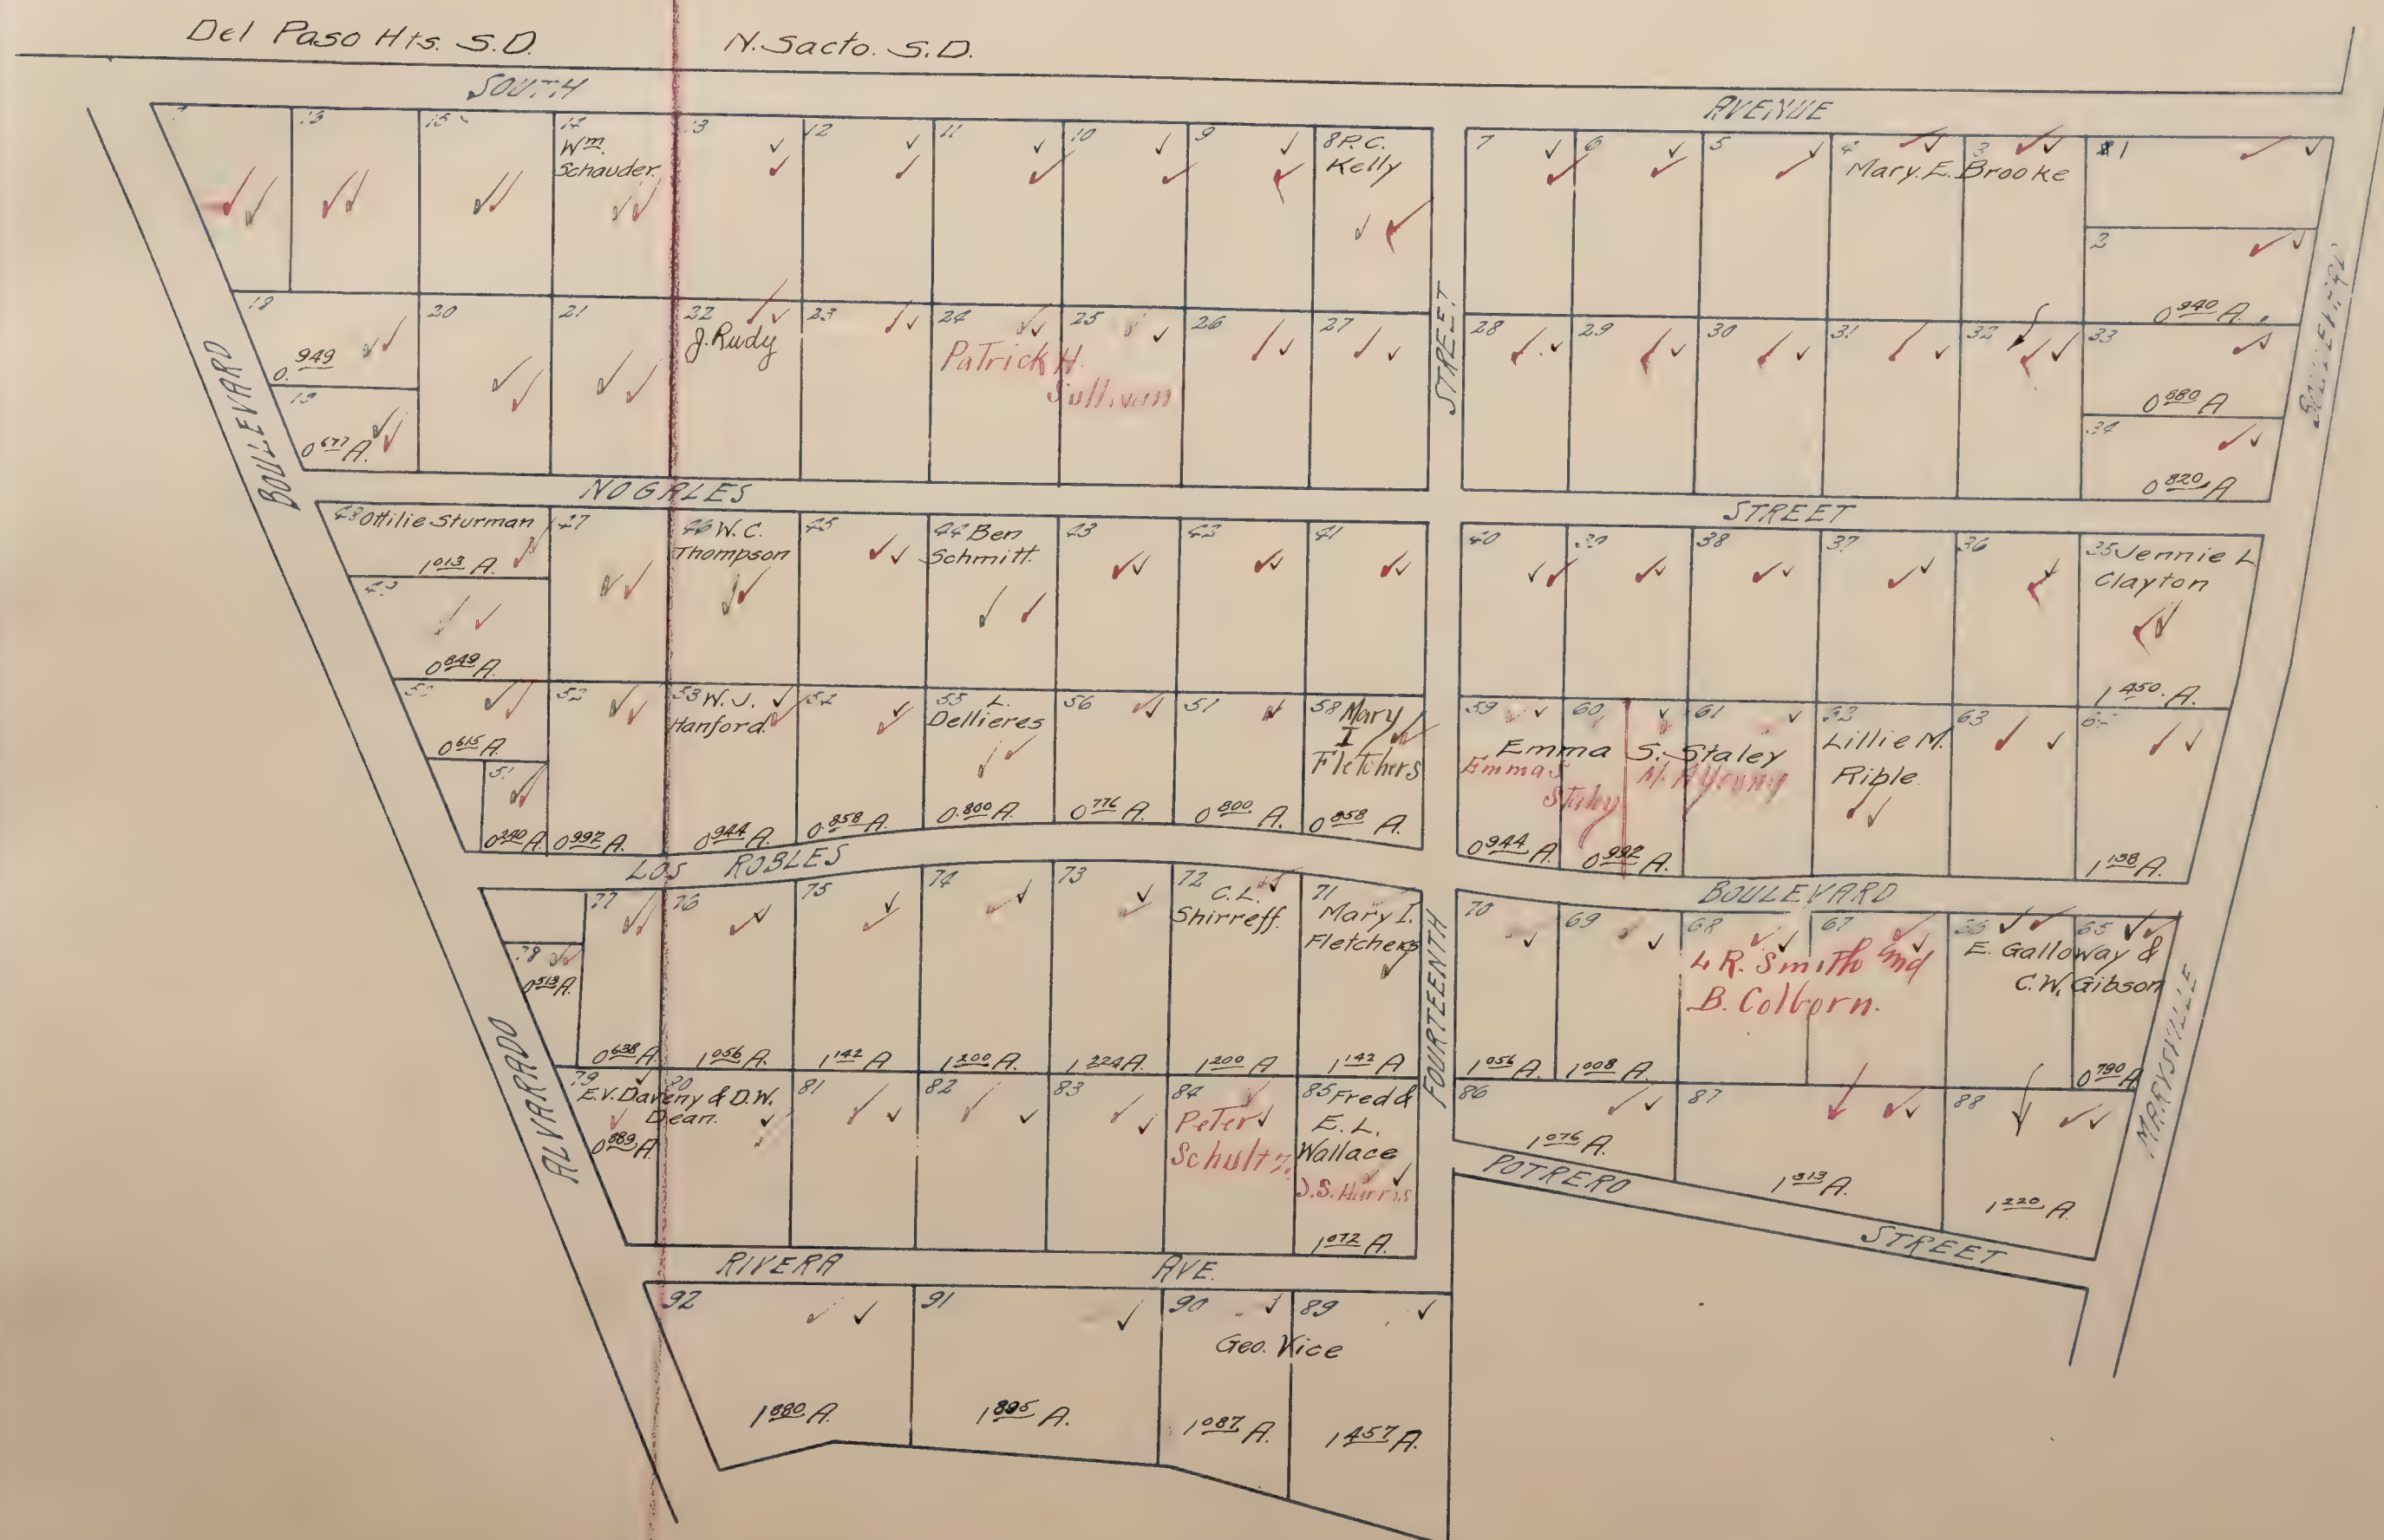

OAK RIDGE

Mapped.

Black Ink - 1919 Ownership
Red Ink - 1920 Ownership

OLIVE HEIGHTS

OR


Brooke Realty Co's. Subdivision No 121.

LOCATED IN

S.W. 1/4 of Sec. 16, T. 10 N., R. 6 E.

Scale 1" = 300'

Dry Creek

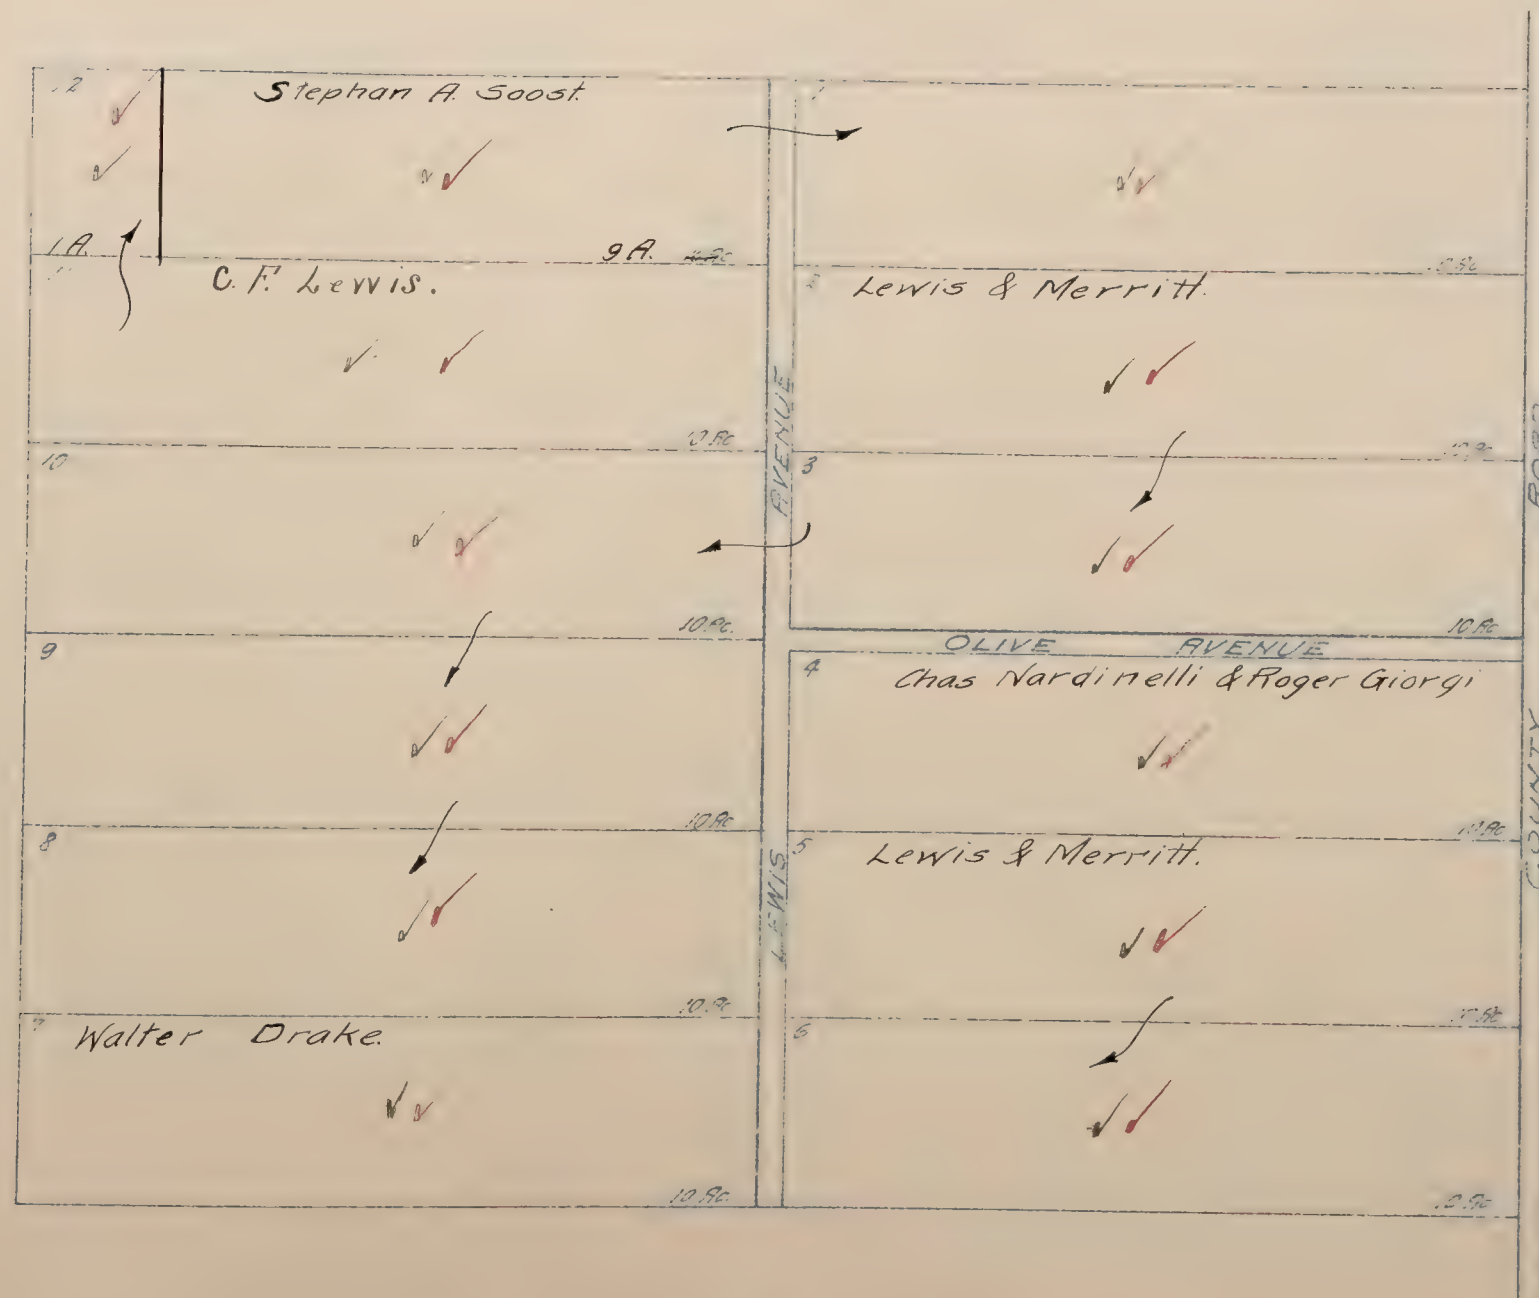

J.F. CROSS SUBDIVISION.

OLIVE HGTS.

Black Ink-1919 Ownership
Red Ink-1920 Ownership

ORANGEMEAD COLONY

located in


Lots 4 & 5 Upper Daylor Estate

Scale: 1" = 600 feet.

Blanks assessed to John and Mary A. Sturgis. ✓ ✓ Wilson S.D.

R. MULL

All Lots 10 Acres unless otherwise marked

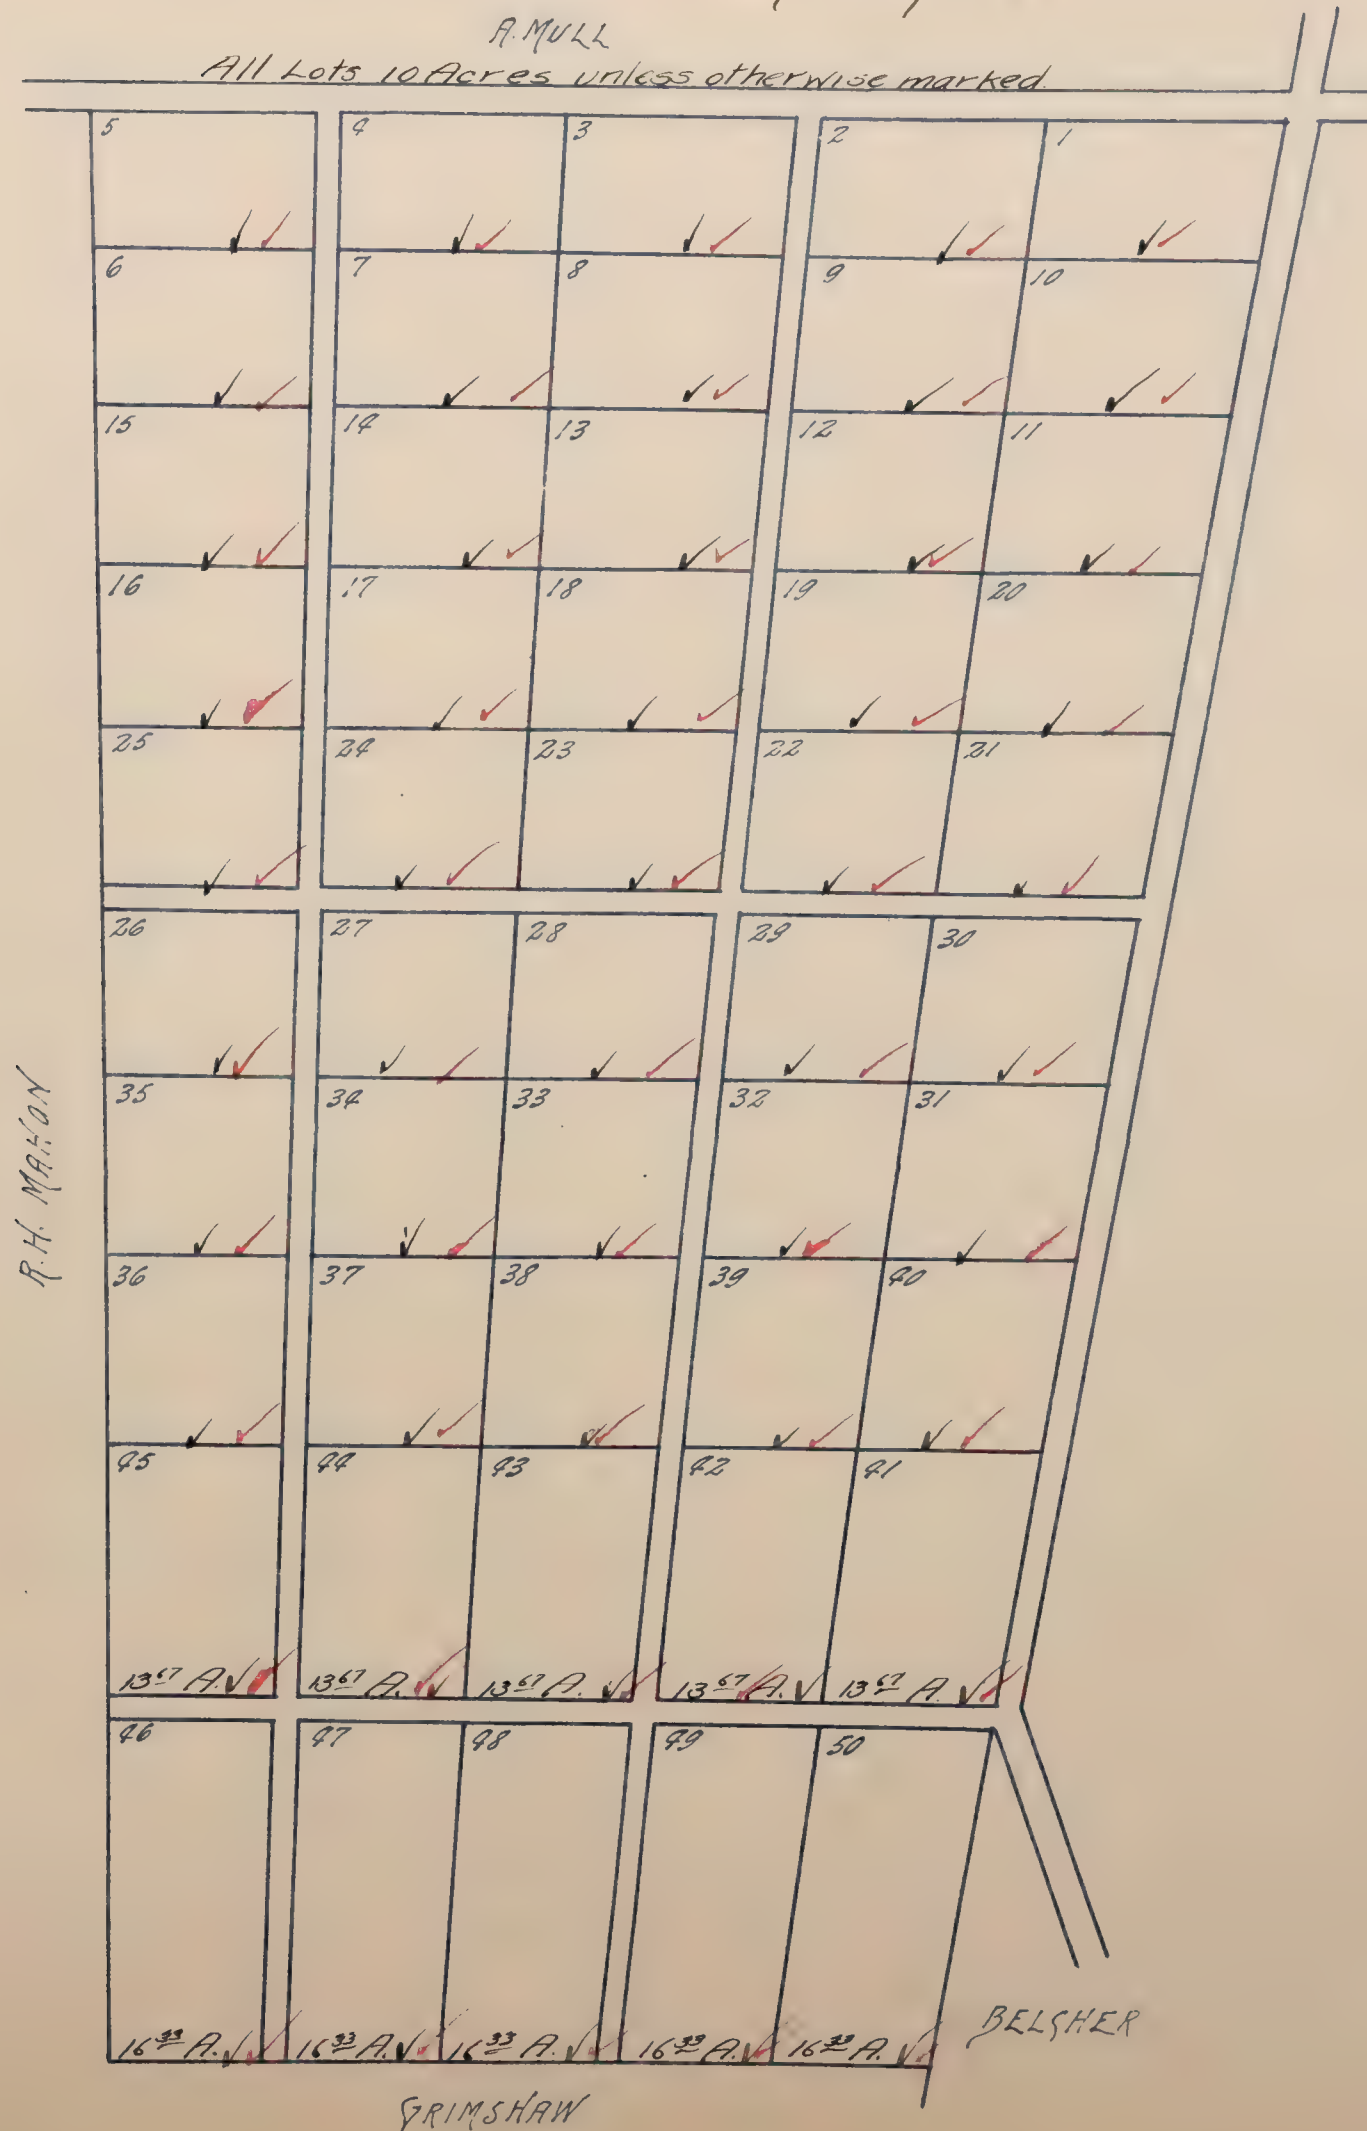

Orangevale S.D.



Mapped.

ORANGEVALE BLUFFS

LOCATED IN THE


E. 1/2 of S.W. 1/4 of Sec. 34, T.10N., R.7E.

Scale 150'-1"

Blanks to Orangevale Townsite Co.

Black Ink-1919 Ownership
Red Ink-1920 Ownership

Orangevale S.D.

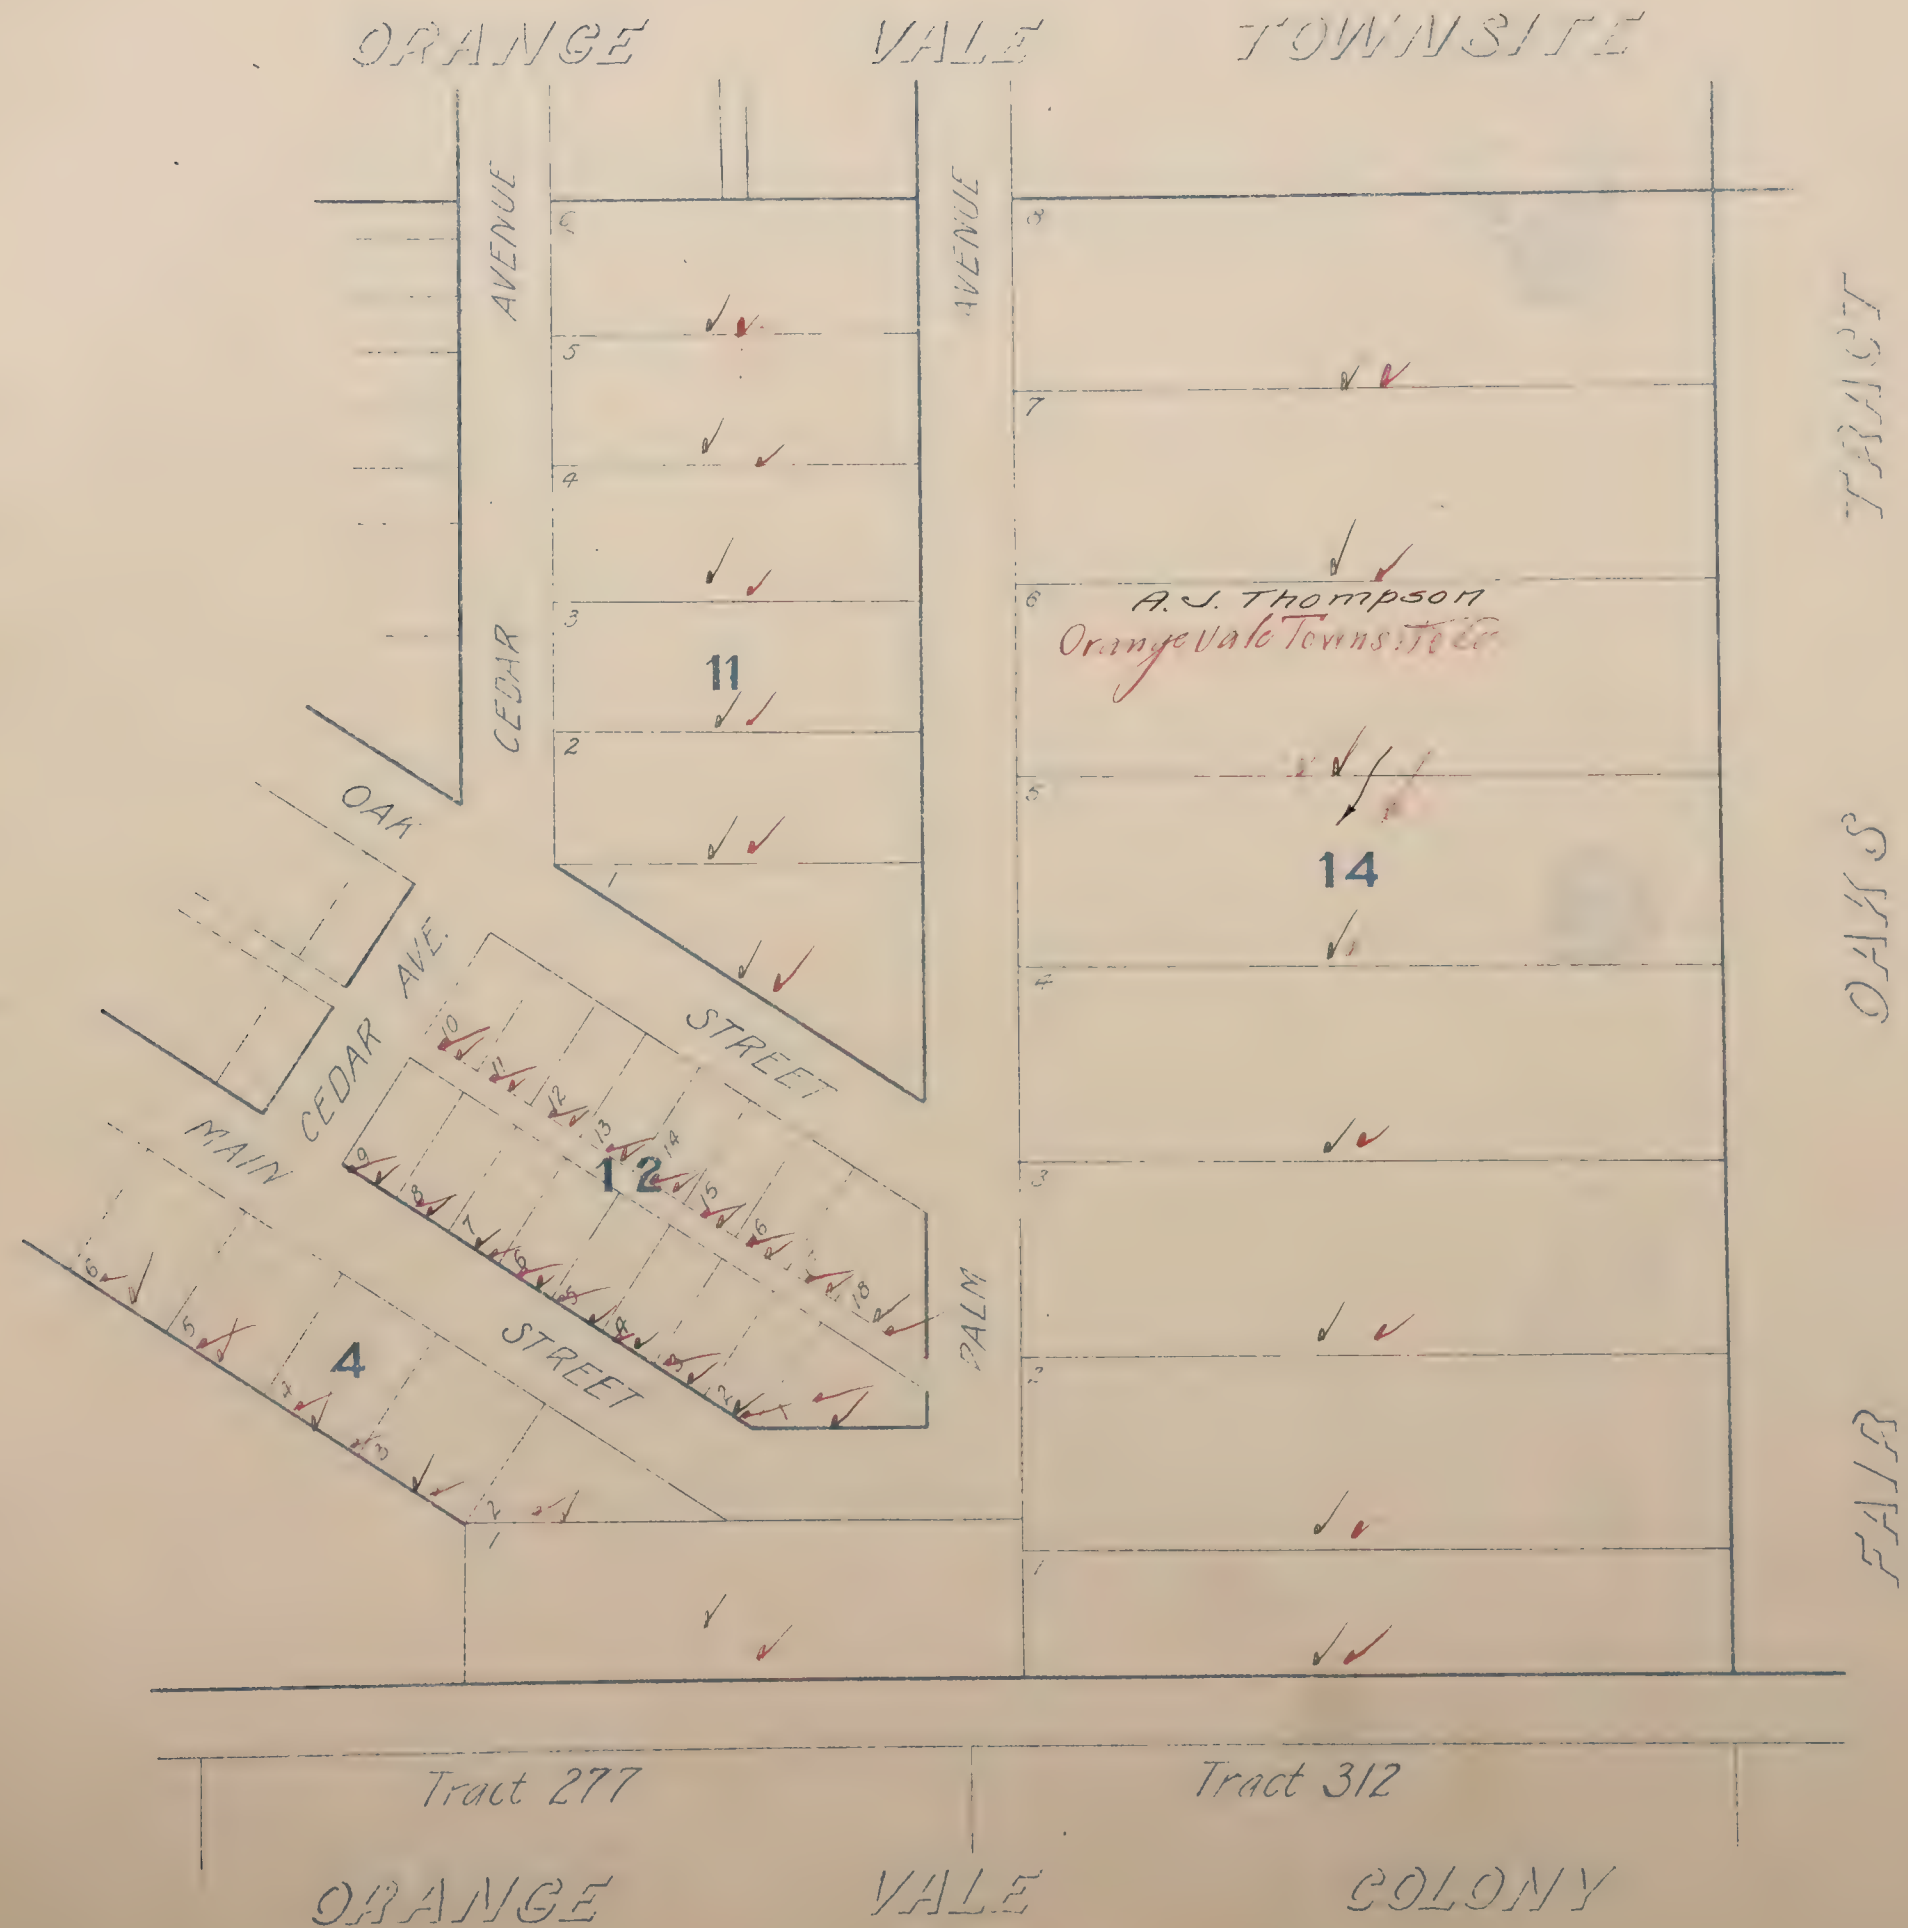

LOCATED IN
Section 4 T.7N.R.5E.
Scale: 1 in = 200 feet

Black Ink-1919 Ownership

Prairie S.D.

Blanks assessed to C.M. Goethe

CRANSE

AVENUE

James Nolan

RED STONES ROAD

ЭНУЗАВ

CITRUS

POMEGRANATE

AVENUE

TANGERIN

AVENUE

ORANGE PARK

12


ORANGE PARK

LOCATED IN
Section 4 T.7N.R.5E.
Scale: 1 in = 200 feet.

Black Ink-1919 Ownership
Red Ink-1929 Ownership

Prairie S.D.

Blanks assessed to C. M. Goethe ✓✓

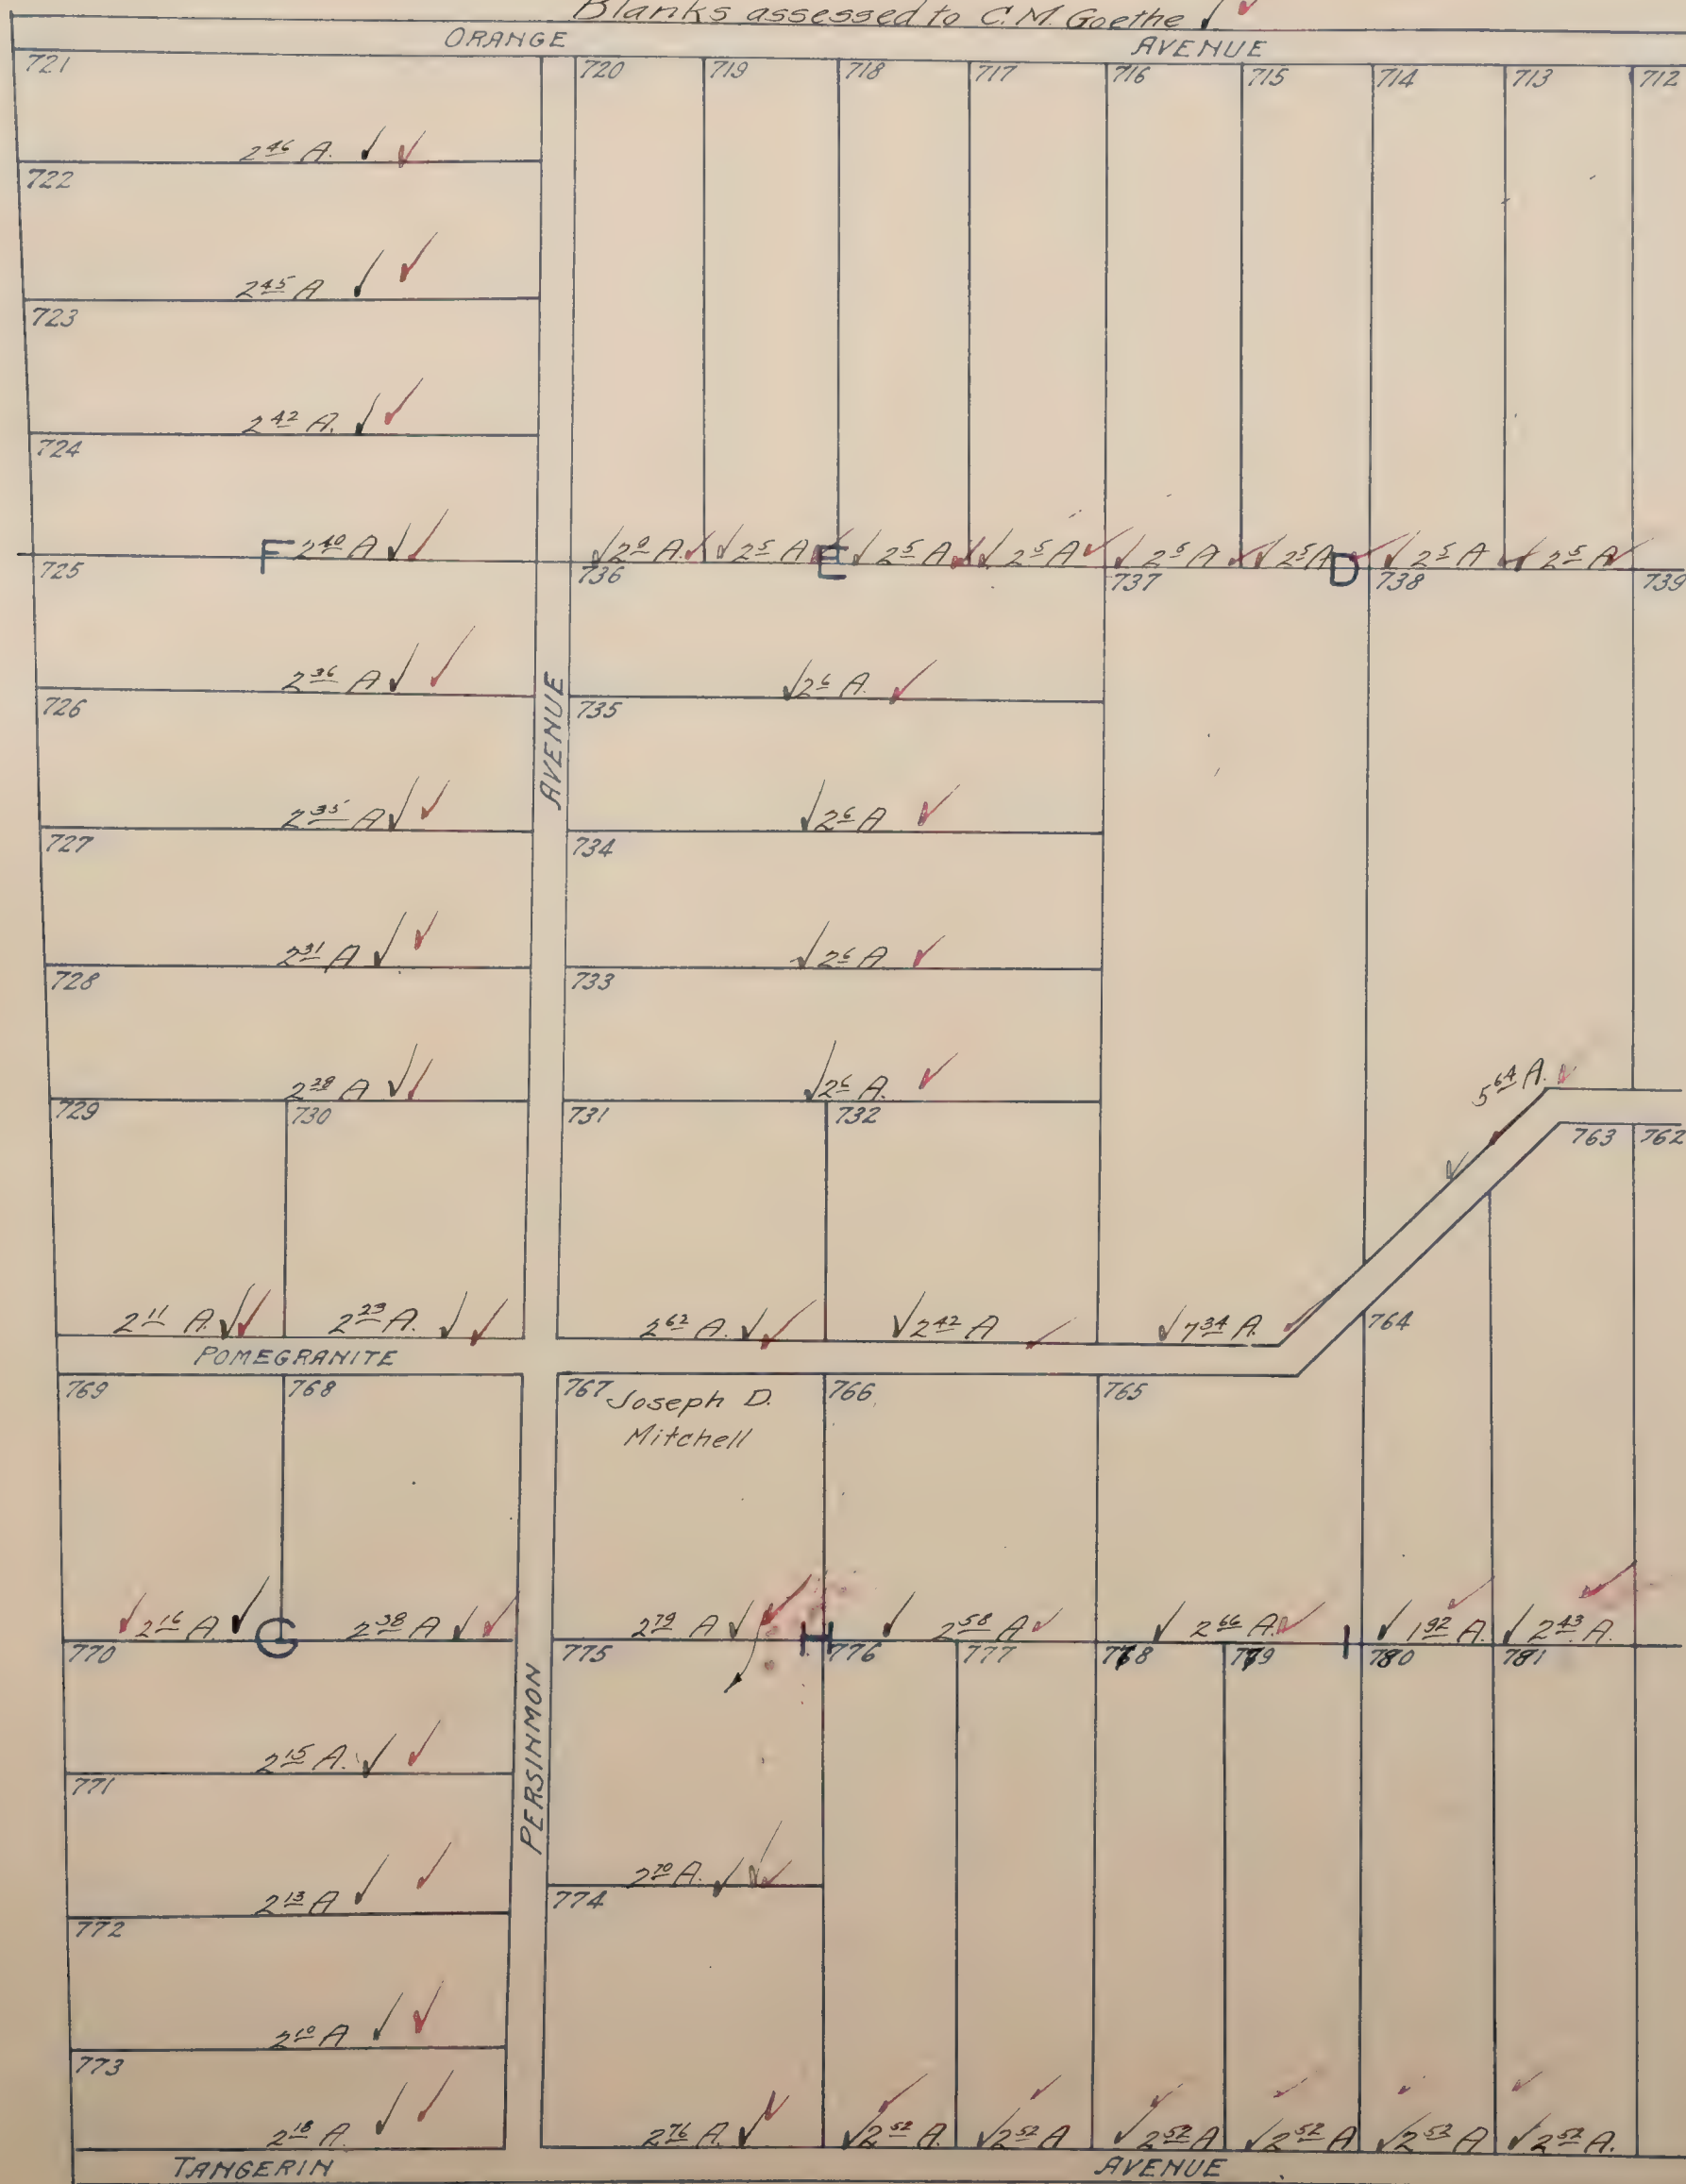

Black Ink-1919 Ownership
Red Ink-1923 Ownership

Scale 15 chains = 1 inch

Roberts. S.D.
Orange. S.D.



✓ Theo. Milliken Lot 8, Blk. 6, Orangevale Townsite
✓ Mrs. Nellie Beauchamp Lot 4 Blk 23 Orangevale Colonization Co.
✓ First Methodist Episcopal Church Fe. Tr. 169.

Mapped.

Black Ink - 1919 Ownership
Red Ink - 1920 Ownership

PALMETTO HEIGHTS

BEING

Lots 11 & 21 in the LOUISIANA TRACT

Scale: 100' = 1"

*Wm. H. K. Co.
Georg. J. D.*

36TH ST.

PALMETTO AVENUE

101	102	103	104	105	106
146			107		
145			108		
144			109		
143			110		
142			111		
141			112		
140			113		
139			114		
138			115		
137			116		
136			117		
135 A. E. Deason			118 H. A. Patrick		
134 ↓			119 C. P. King		
133 Jno. S. Blair			120 Susie E. Mullenney		
132 H. A. Patrick			121 Ennis & Brown		
131 H. L. Dean			122 W. C. Muir		
130 A. Lehman			123 Minna Epstein		
129 L. De Costa			124 J. H. Christian		
128 ↓			125 Tom A. Cody		
127 Ennis & Brown			126 W. E. Trainor		
128 B. F. Driver			127 W. K. Glasford		

City

Limits.

TERRACE AVENUE

Black Ink-1910 Ownership
Red Ink-1920 Ownership

LOCATED IN THE
N.E. ¼ of Sec.20 T.8 N., R.5 E.

Scale: 80' = 1"

Frank Ridge
Goldberg S.D.

PARKER AVENUE				ROOSEVELT AVENUE			
1 Hattie C. Billings	2	3 Jeanette L. Dunster	4 Minnie A. Kleinsorge	5	6 J. A. M ^{rs} Kee	7 J. H. M ^{rs} Winston	8
✓	✓	✓	✓	✓	✓	✓	✓
16 Julia Windle.	15	14 ↓	13 J. J. Morris	12 ↓	11 ↓	10 ↓	9 ↓ O. G ^{rs} A.
✓	✓	✓	✓	✓	✓	✓	✓
				O. G ^{rs} A.			

Mapped.


Black Ink-1919 Ownership
Red Ink-1923 Ownership

PEERLESS LAND & INVESTMENT CO. SUBD. NO. 1

LOCATED IN
Sections 28 29 & 32 T.7N.R.5E.
Scale: 1 inch = 400 feet

Blank to F. Hickman. ✓✓

Prairie S.D.

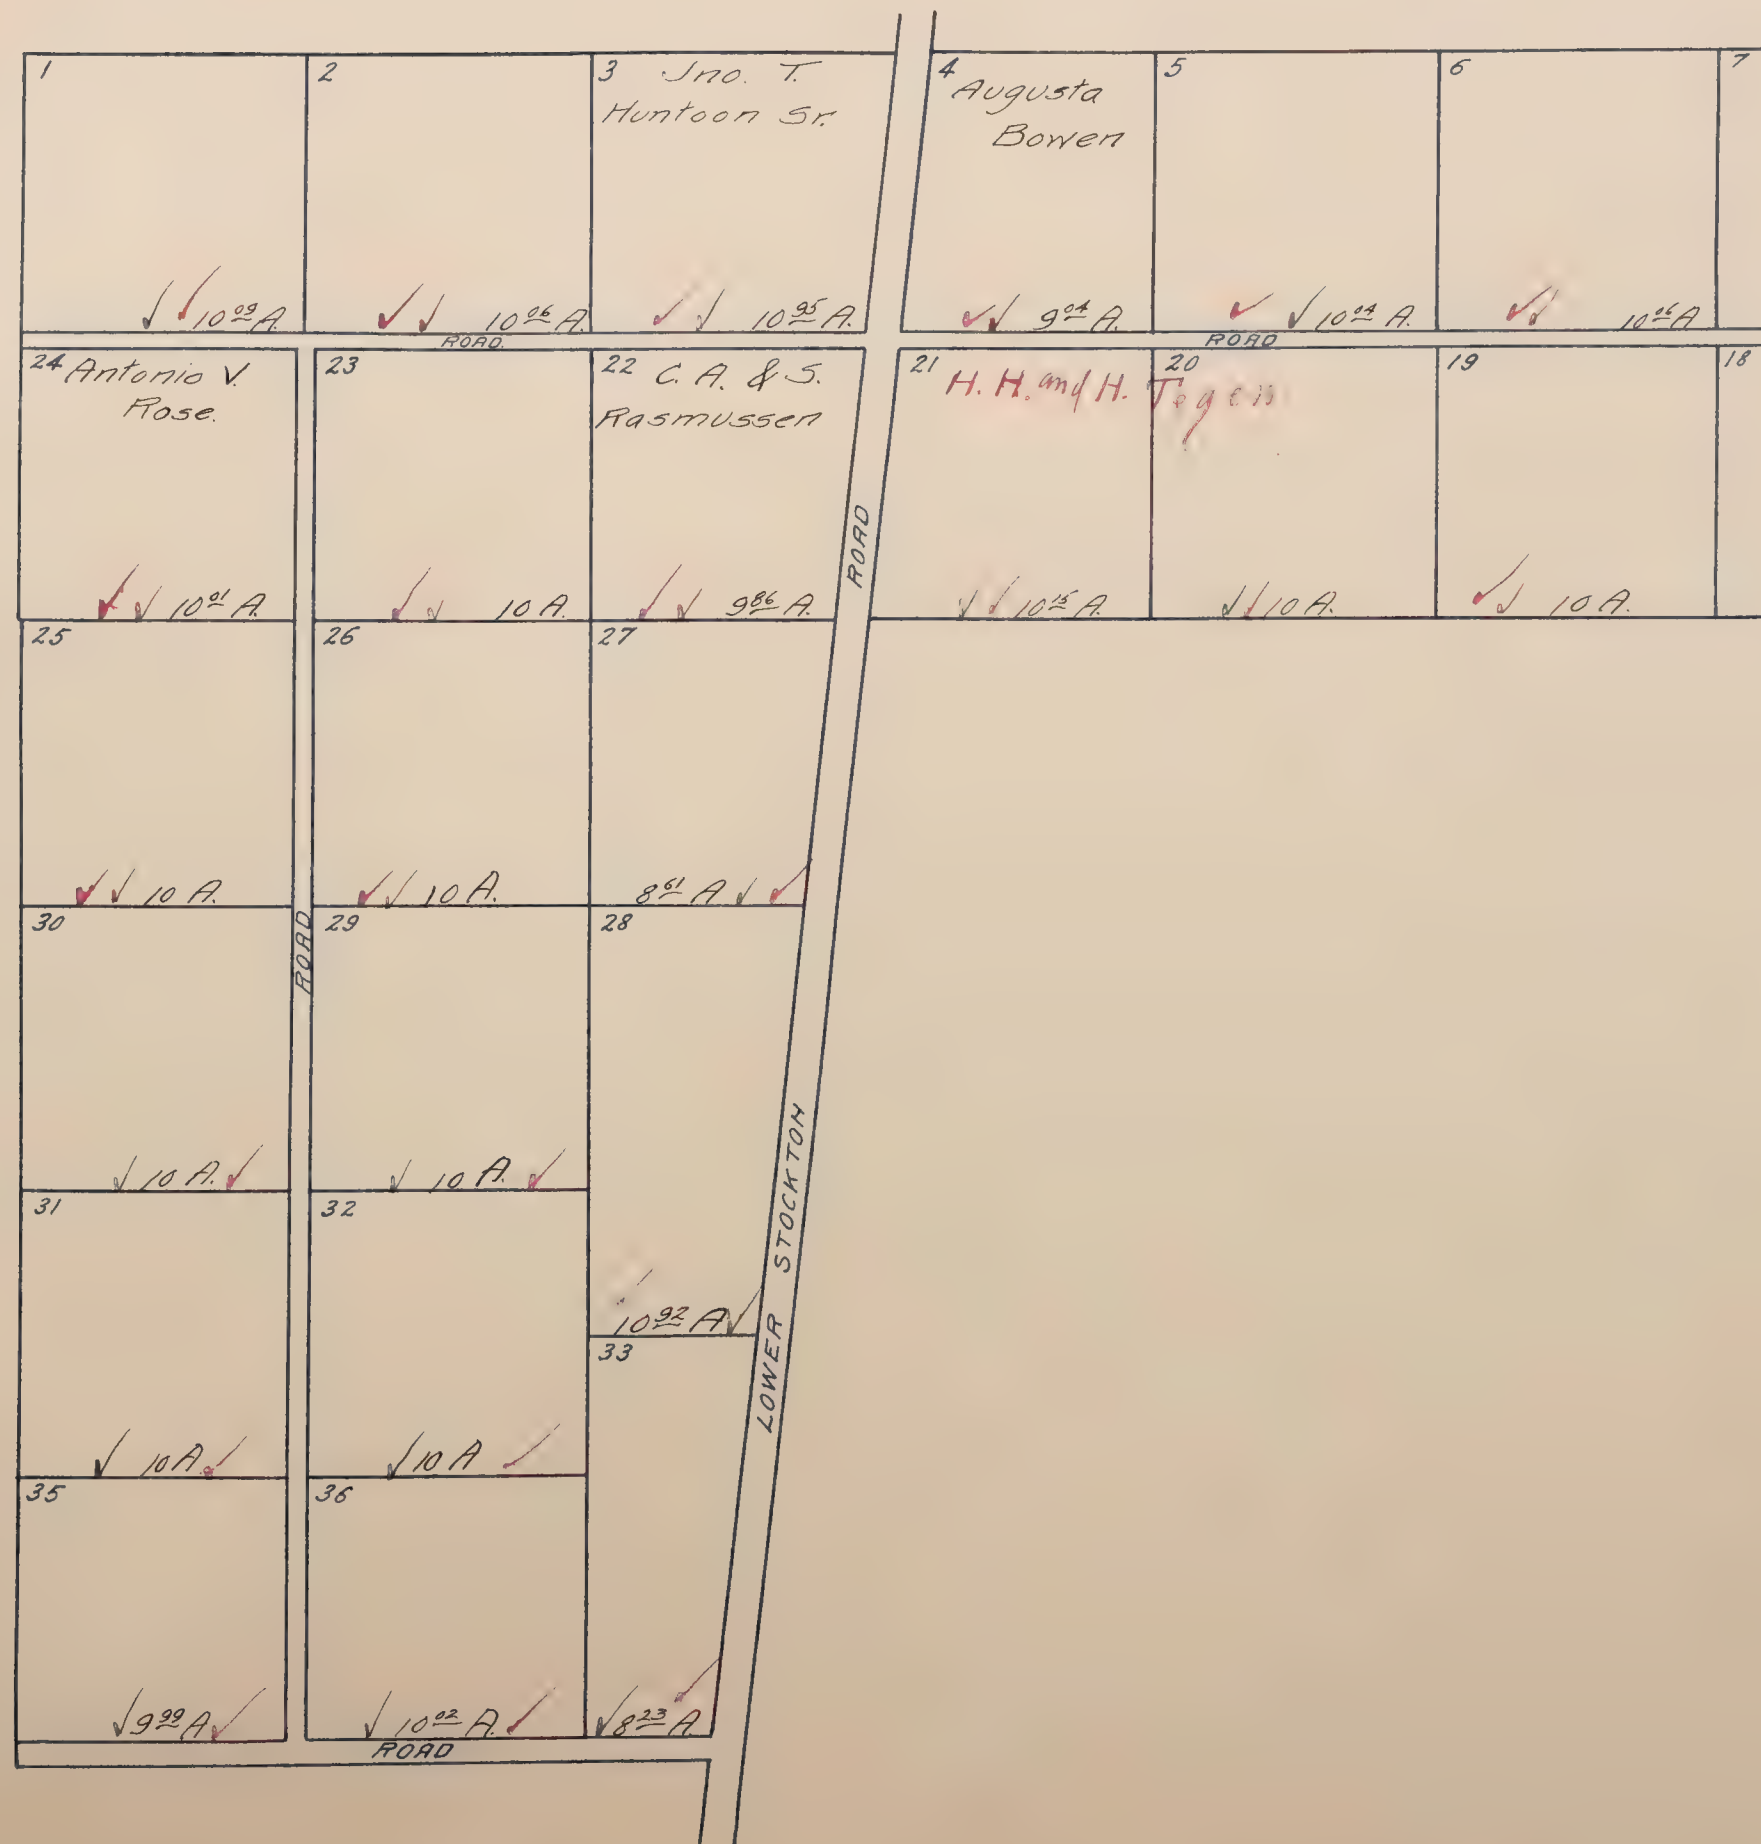

Mapped.

Black Ink-1919 Ownership
Red Ink-1979 Ownership

PEERLESS LAND & INVESTMENT CO. SUBD. NO. 1
LOCATED IN
Sections 28 29 & 32 T.7N.R.5E.
Scale: 1 inch = 400 feet.

Prairie S.D.

Blanks assessed to F. Hickman. ✓✓


6	7	8	9	10	11	12
	✓ 10 ²⁸ A ✓	✓ 10 ²⁸ A ✓	✓ 10 ²⁸ A ✓	✓ 10 ²⁸ A ✓	✓ 10 ²⁸ ✓	✓ 10 ²⁸ A ✓
19	18	17	16	15	14	13
			✓ L.C. Cummings			
	✓ 10 A ✓	✓ 10 A ✓	✓ 10 A ✓	✓ 10 A ✓	✓ 10 A ✓	✓ 10 A ✓

PIERCE-WILSON TRACT.

LOCATED IN THE
S. 4 SEC. 24 T. 8 N. R. 4 E.


Black Ink - 1919 Ownership
Red Ink - 1920 Ownership

Freemont
Sutter S.D.

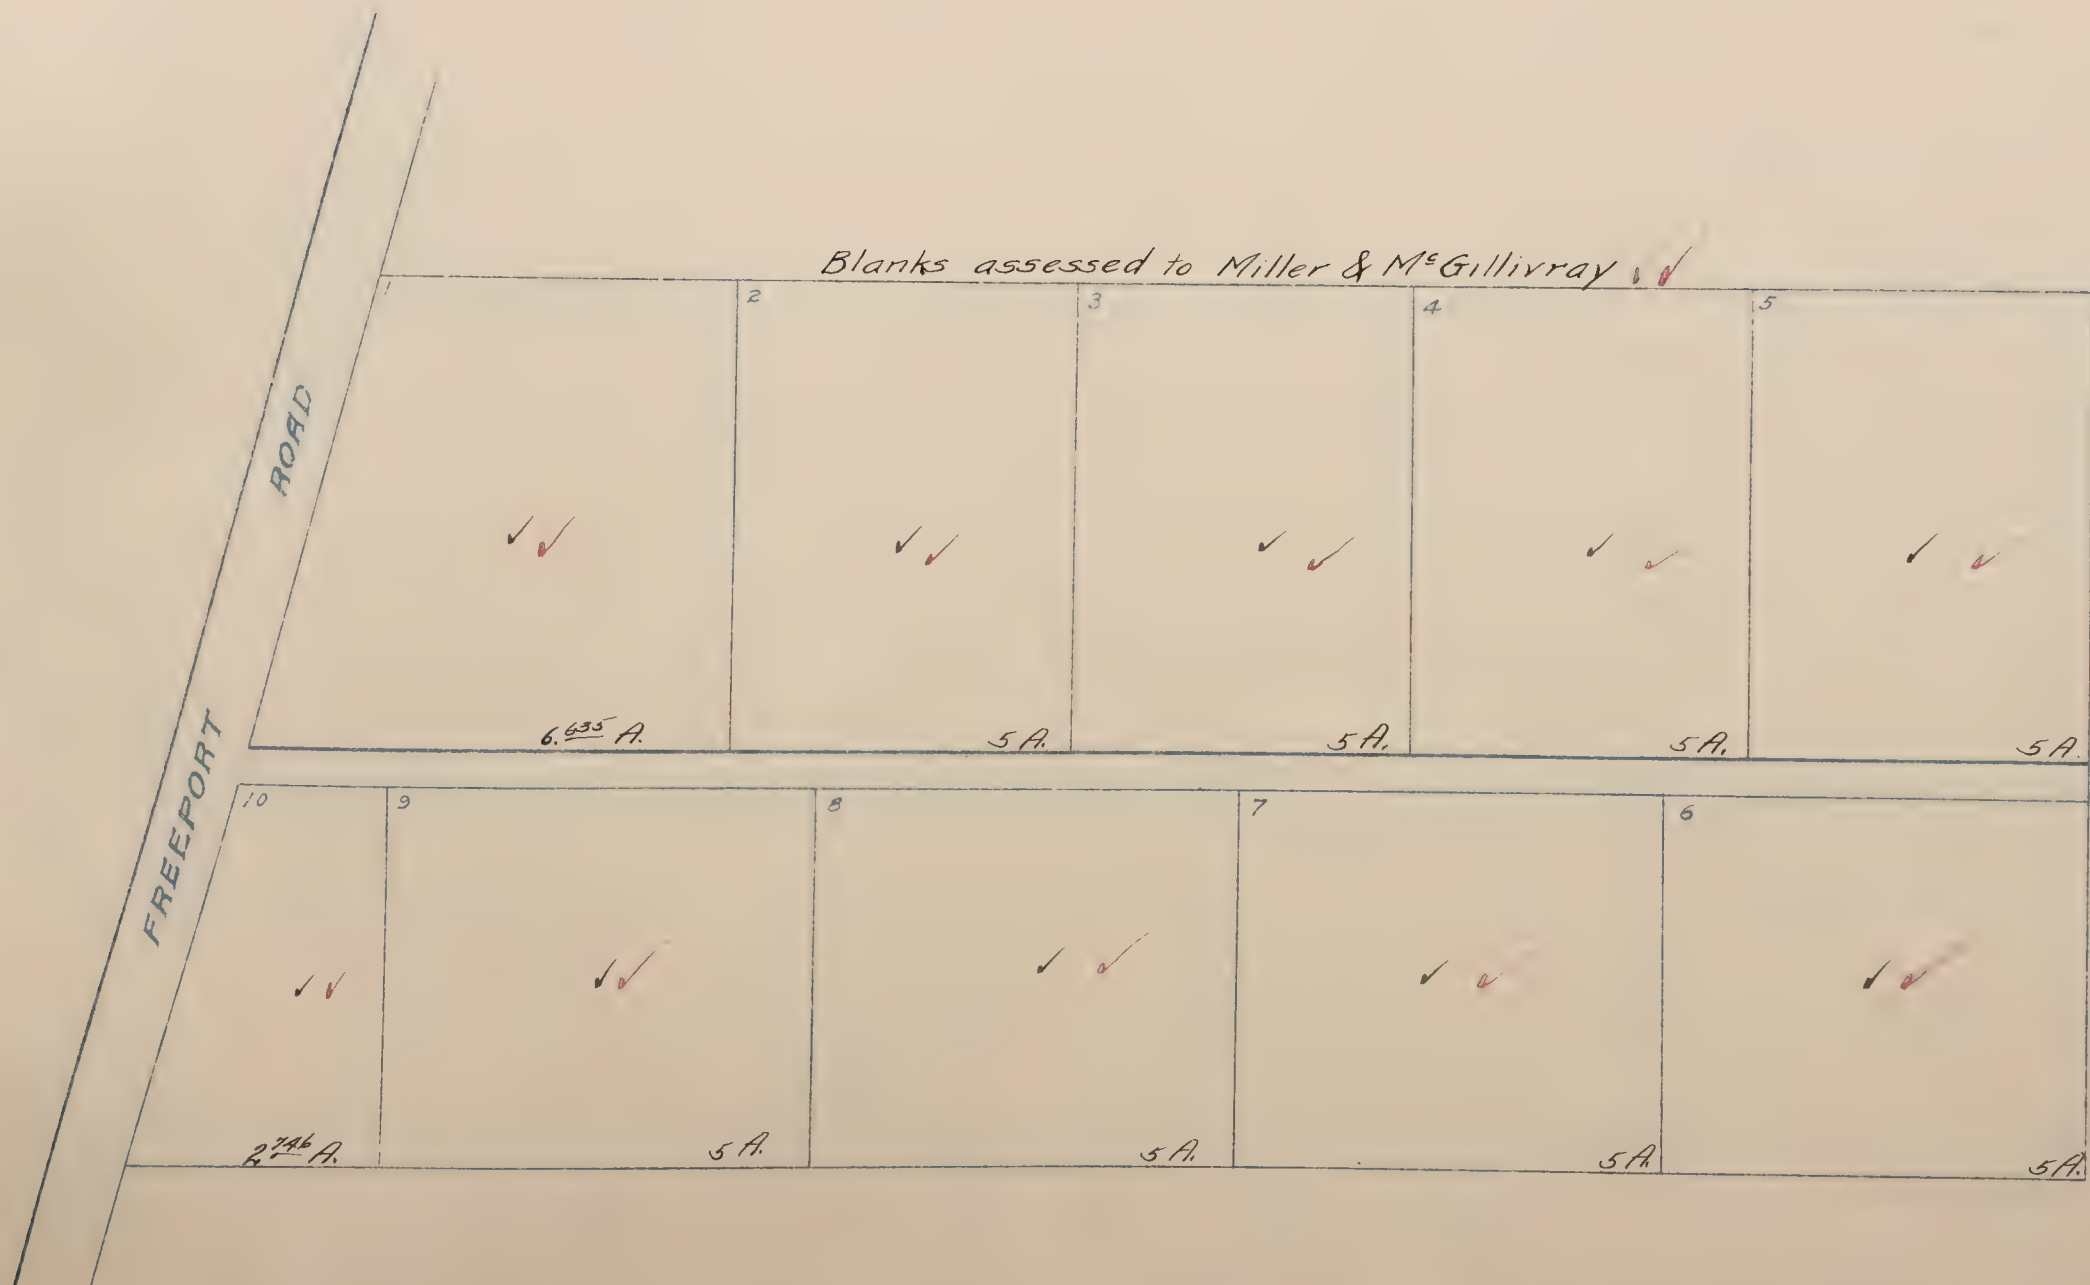

Black Ink-1919 Ownership
 Red Ink-1920 Ownership
RAFFETTO HEIGHTS
 located in
 Sec 15 T8N R5 E.
 Scale: 1"=150'

Junction S.D.

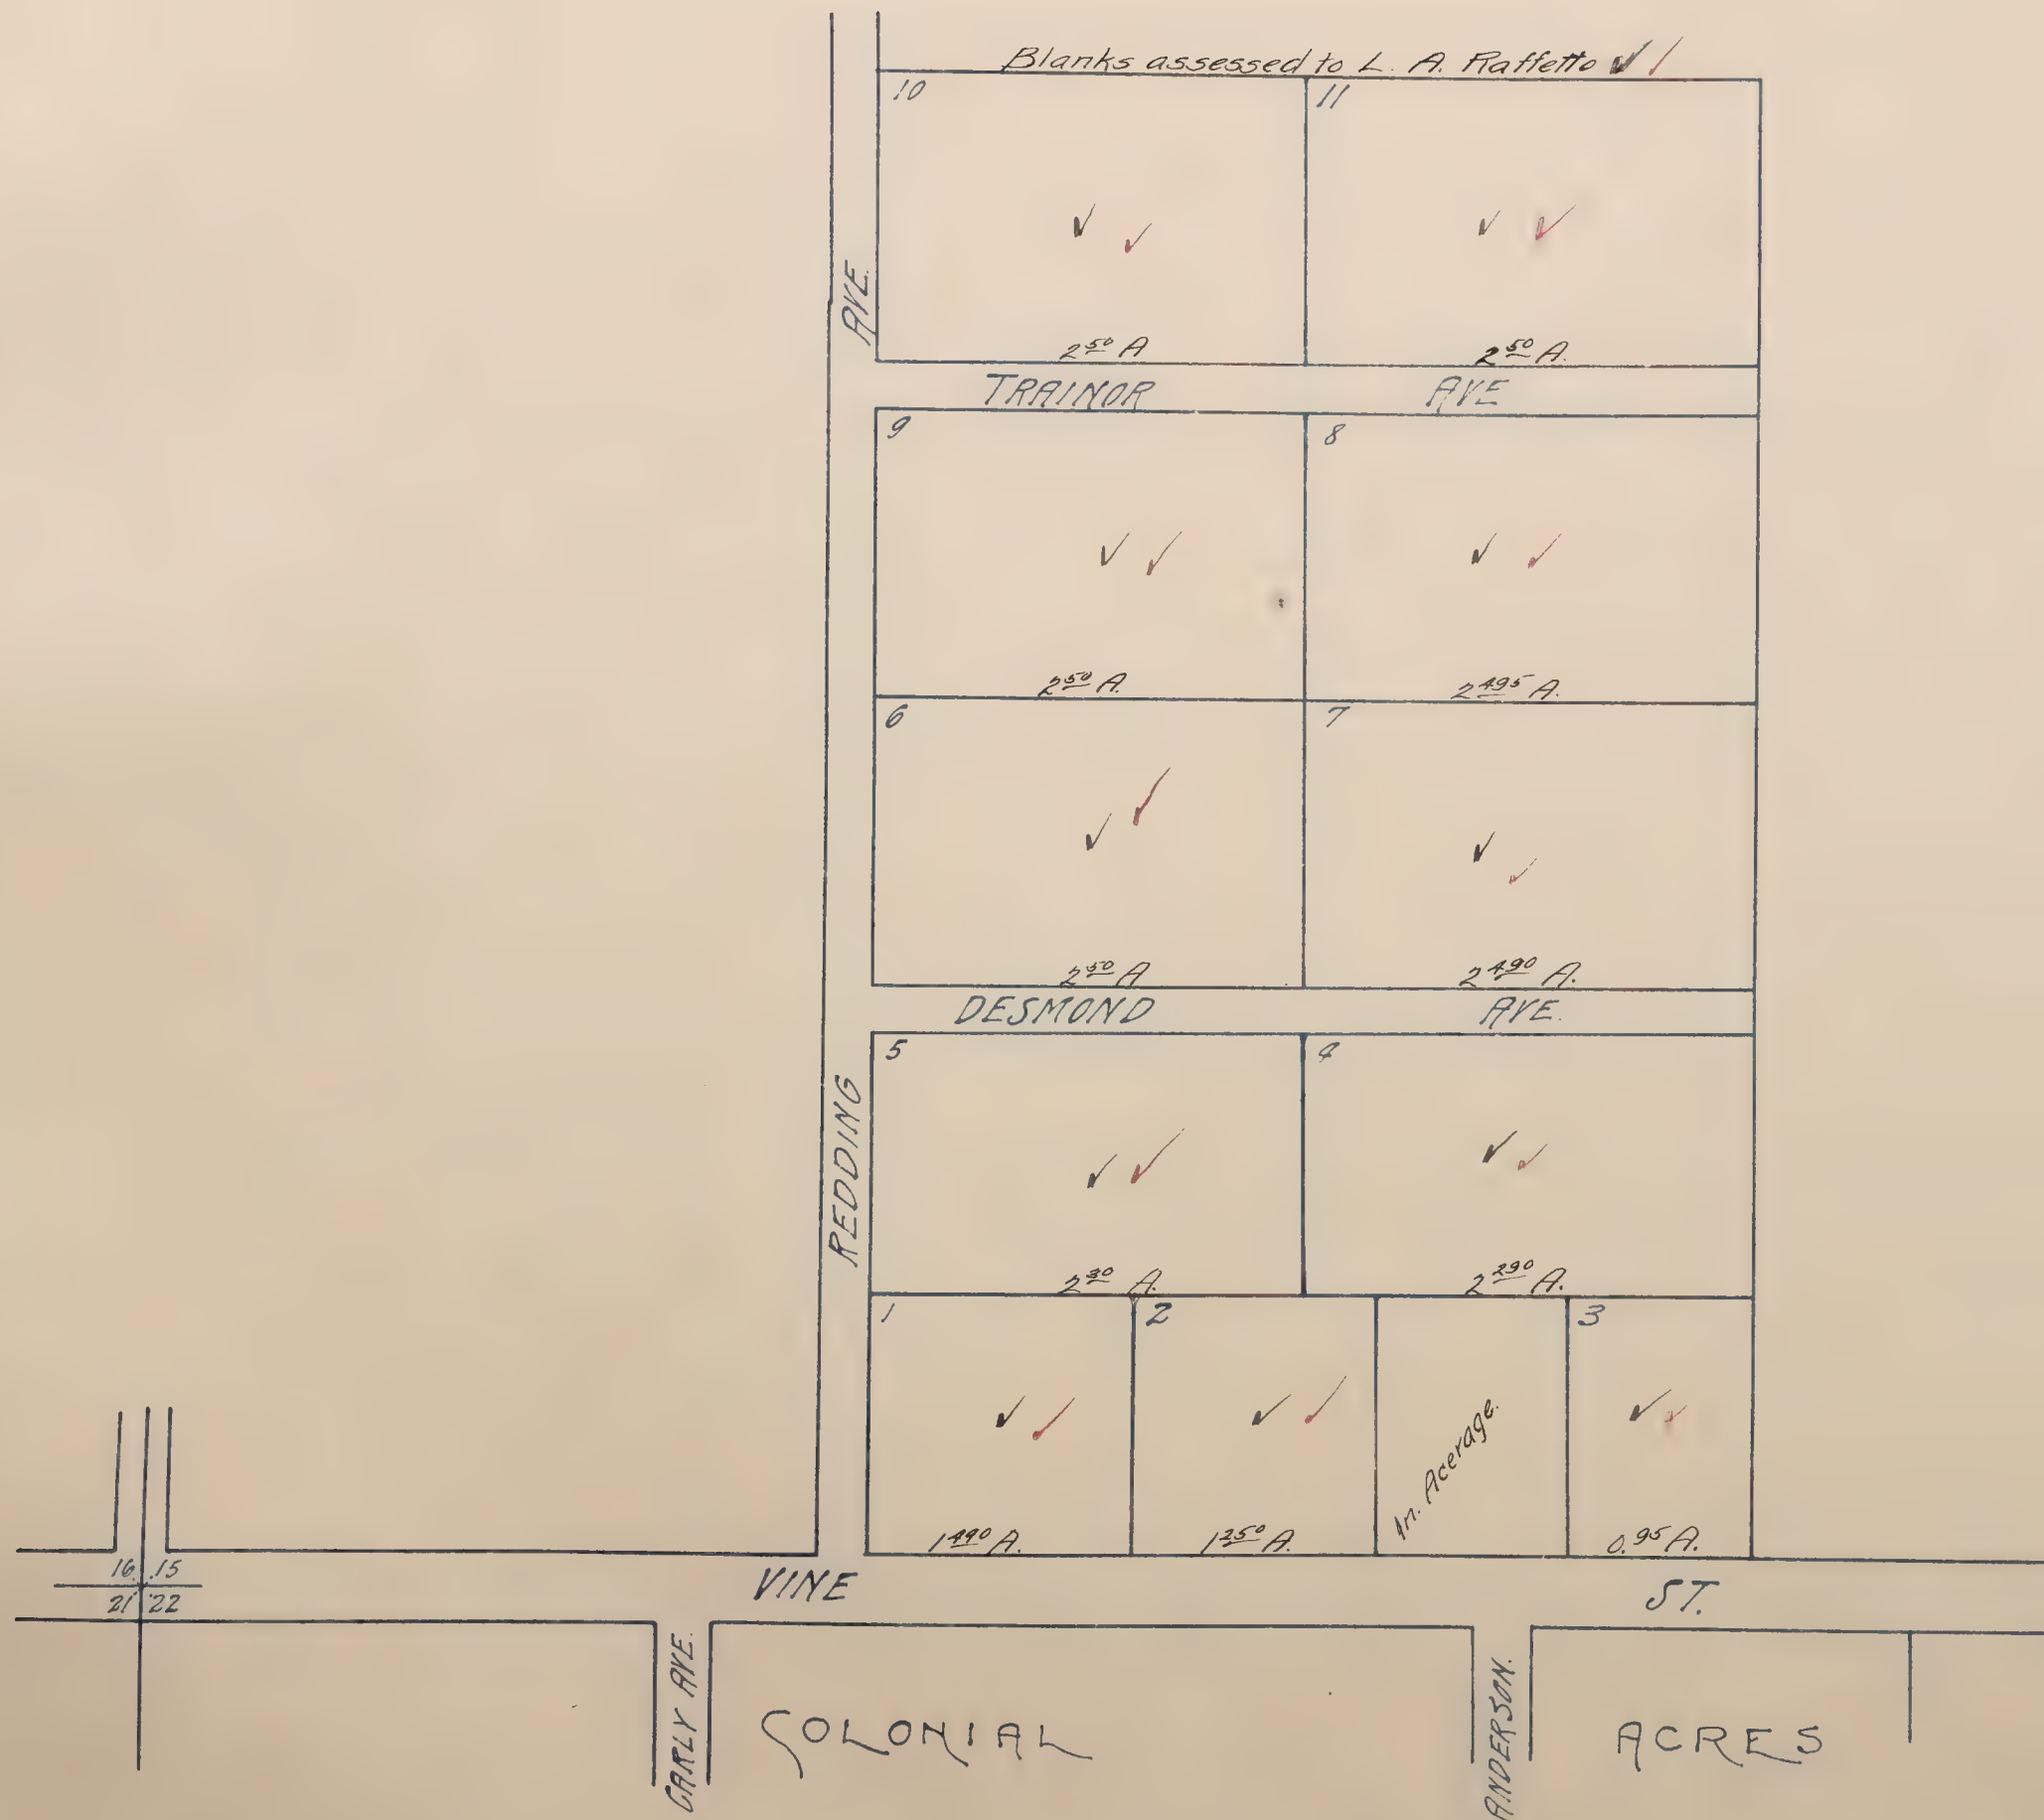

RAFFETTO

Mapped.

Black Ink-1919 Ownership
Red Ink-1929 Ownership

RALPH SKINNER TRACT
Being The
S $\frac{1}{2}$ of S.W. $\frac{1}{4}$ SEC. 5, T. 9 N. R. 7 E.

Blanks to Ralph L. Skinner ✓

Robert L. D.

Grover Rusch

1
10 ¹⁸ Ac.

6
9. ⁹⁸

2
10 ⁰⁰ Ac.

4
9 ⁵⁹ Ac.

5
9 ⁵⁷ Ac.

7
10 ⁰⁰ Ac.

3
10 ⁰⁰ Ac.

8
10 ⁰⁰ Ac.

CITRUS HEIGHTS ADDN No 4

FAIR OAKS TRACT BLOCK XV

FAIR OAKS TRACT BLOCK XVII

Ralph Skinner

RAMONA VILLA

LOCATED IN
E 1/2 of Sec. 15 T8N R5E
Scale 100' = 1"

direction S.D.

Blanks assessed to M. J. Dillman.

Mapped.

Black Ink-1919 Ownership
Red Ink-1920 Ownership




Mapped

Black Ink-1919 Ownership
RANCHO DEL PASO
SUBDIVISION NO. 11
Scale 1"=8 chains

K. H. W.
Oak Grove S.D.
Del Paso Heights S.D.

Blanks to Interurban Acres Land Co. ✓
All Lots 10 Acres unless otherwise noted.

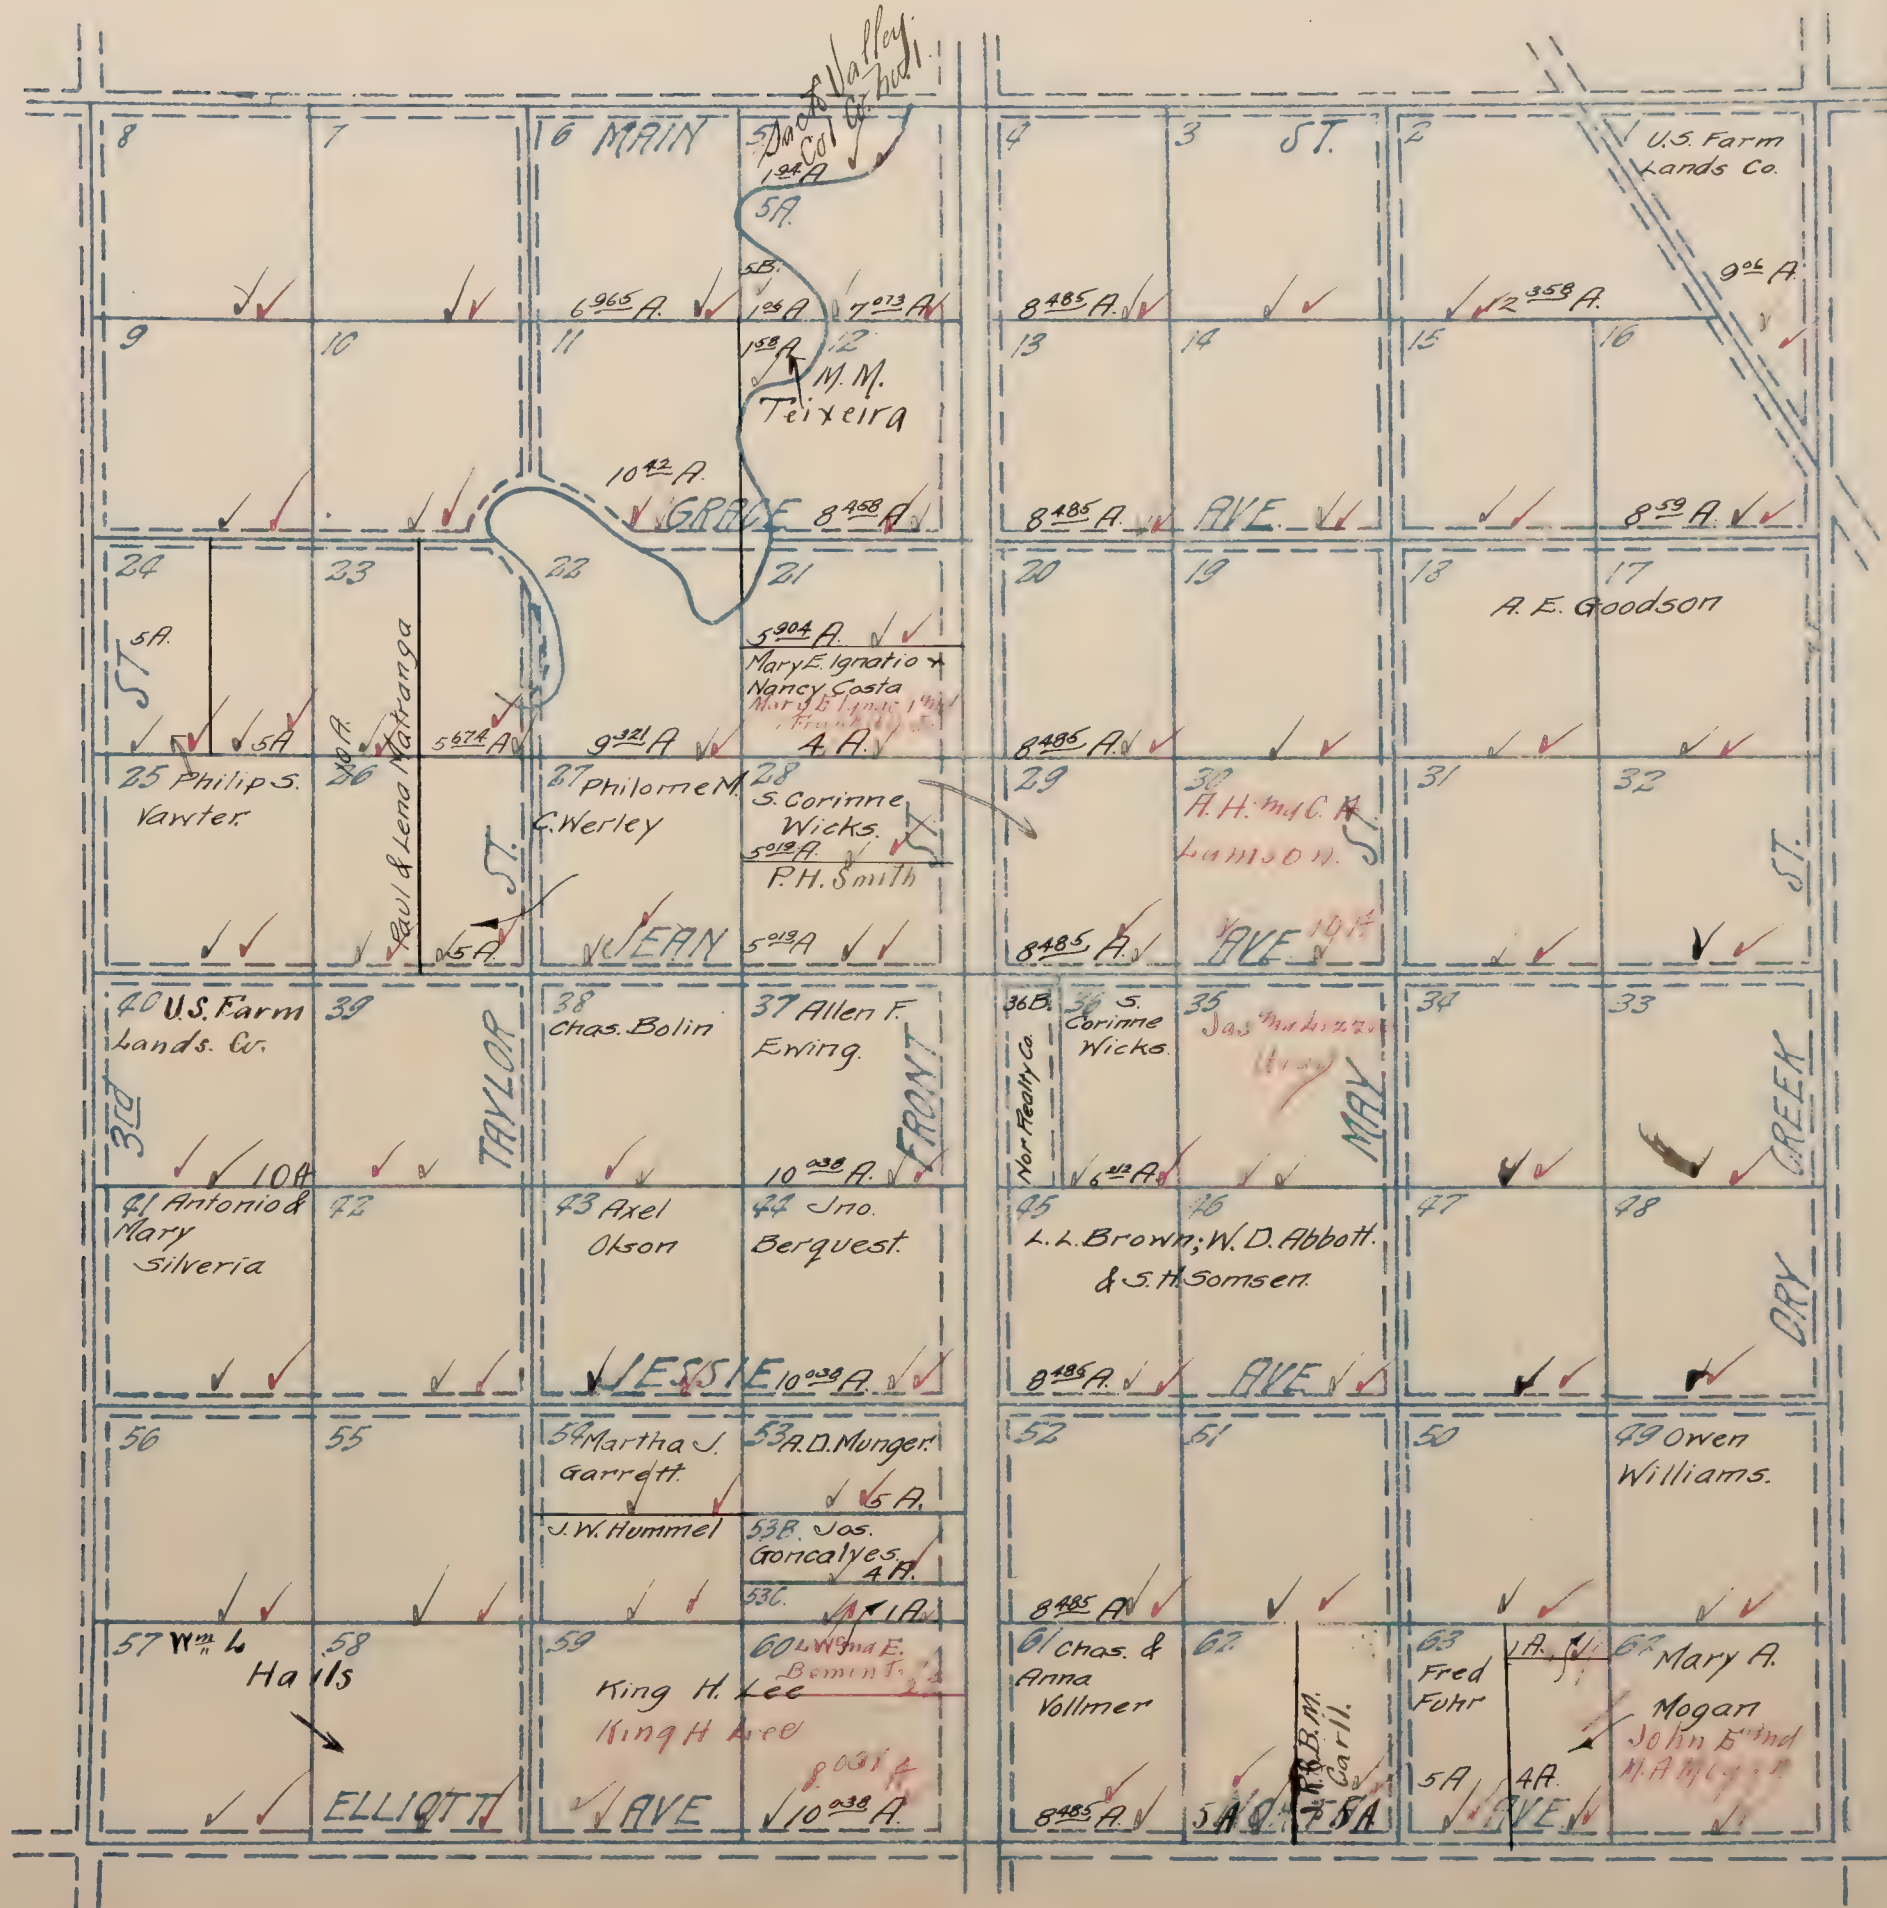

SUBD'N. SEC 28
RANCHO DEL PASO

Scale 1 in = 80 chains

Mapped.

Arco, S.D.

Blanks to United States Farms Lands Co.
 All Lots 10 Acres unless otherwise noted.

Black Ink - 1919 Ownership
 Red Ink - 1920 Ownership

7 F.A. P.E.; W.H. & M.B. Mathews; R.M. Dunton and J.R. Beggs. ✓		8 Cornelius B. & Minnie M. Ratzlaff. ✓		9 S.A.R. & A.M. Kruger. ✓		10 Wm. T. Greer. ✓	
		11 ✓		12 ✓		13 W.H. McHenry. ✓	
				14 30 A.		15 North Sacto Land Co. ✓	
20 40 A.		21 Thomas M. Burns. ✓		22 Sarah Gamble. ✓		23 20 Ac.	
24 5 A. Edw. W. Hunt. ✓		25 5 A. Dwight B. Sterling. ✓		26 5 A. Louis Lutenneger. ✓		27 John & Elsie Roth. ✓	
28 5 A. Nellie M. Schoeffle. ✓		29 5 A. Dan Long & Jim Ough. ✓		30 10 A. George Petrinovich. ✓		31 10 A. Mary O. Wallner. ✓	
32 35 A.		33 5 A.		34 10 A.		35 9 1/2 A.	
36 40 ✓		37 30 ✓		38 30 ✓		39 35 ✓	
40 41 ✓		41 42 ✓		42 43 E.A. Brown & H.T. Silvius. ✓		43 44 ✓	
44 45 ✓		45 46 ✓		46 47 ✓		47 48 ✓	
48 50 ✓		49 51 ✓		50 52 ✓		51 53 ✓	
52 54 ✓		53 55 ✓		54 56 ✓		55 57 ✓	
56 58 ✓		57 59 ✓		58 60 ✓		59 61 ✓	
60 62 ✓		61 63 ✓		62 64 ✓		63 65 ✓	
64 11 01/4 A.		65 11 01/4 A.		66 11 01/4 A.		67 11 01/4 A.	
68 11 A.		69 9 3/4 A.		70 10 3/4 A.		71 10 3/4 A.	

Black Ink-1919 Ownership
Red Ink-1929 Ownership


Mapped

RAY GOWERS SUBD. NO. 1


located in
Sect. 1, 11, 12, T. 5 N. R. 6 E.
Scale: 1" = 8 chs.

Arno SD.

Blanks to Ray Gowers
All lots 20 Acres unless otherwise noted

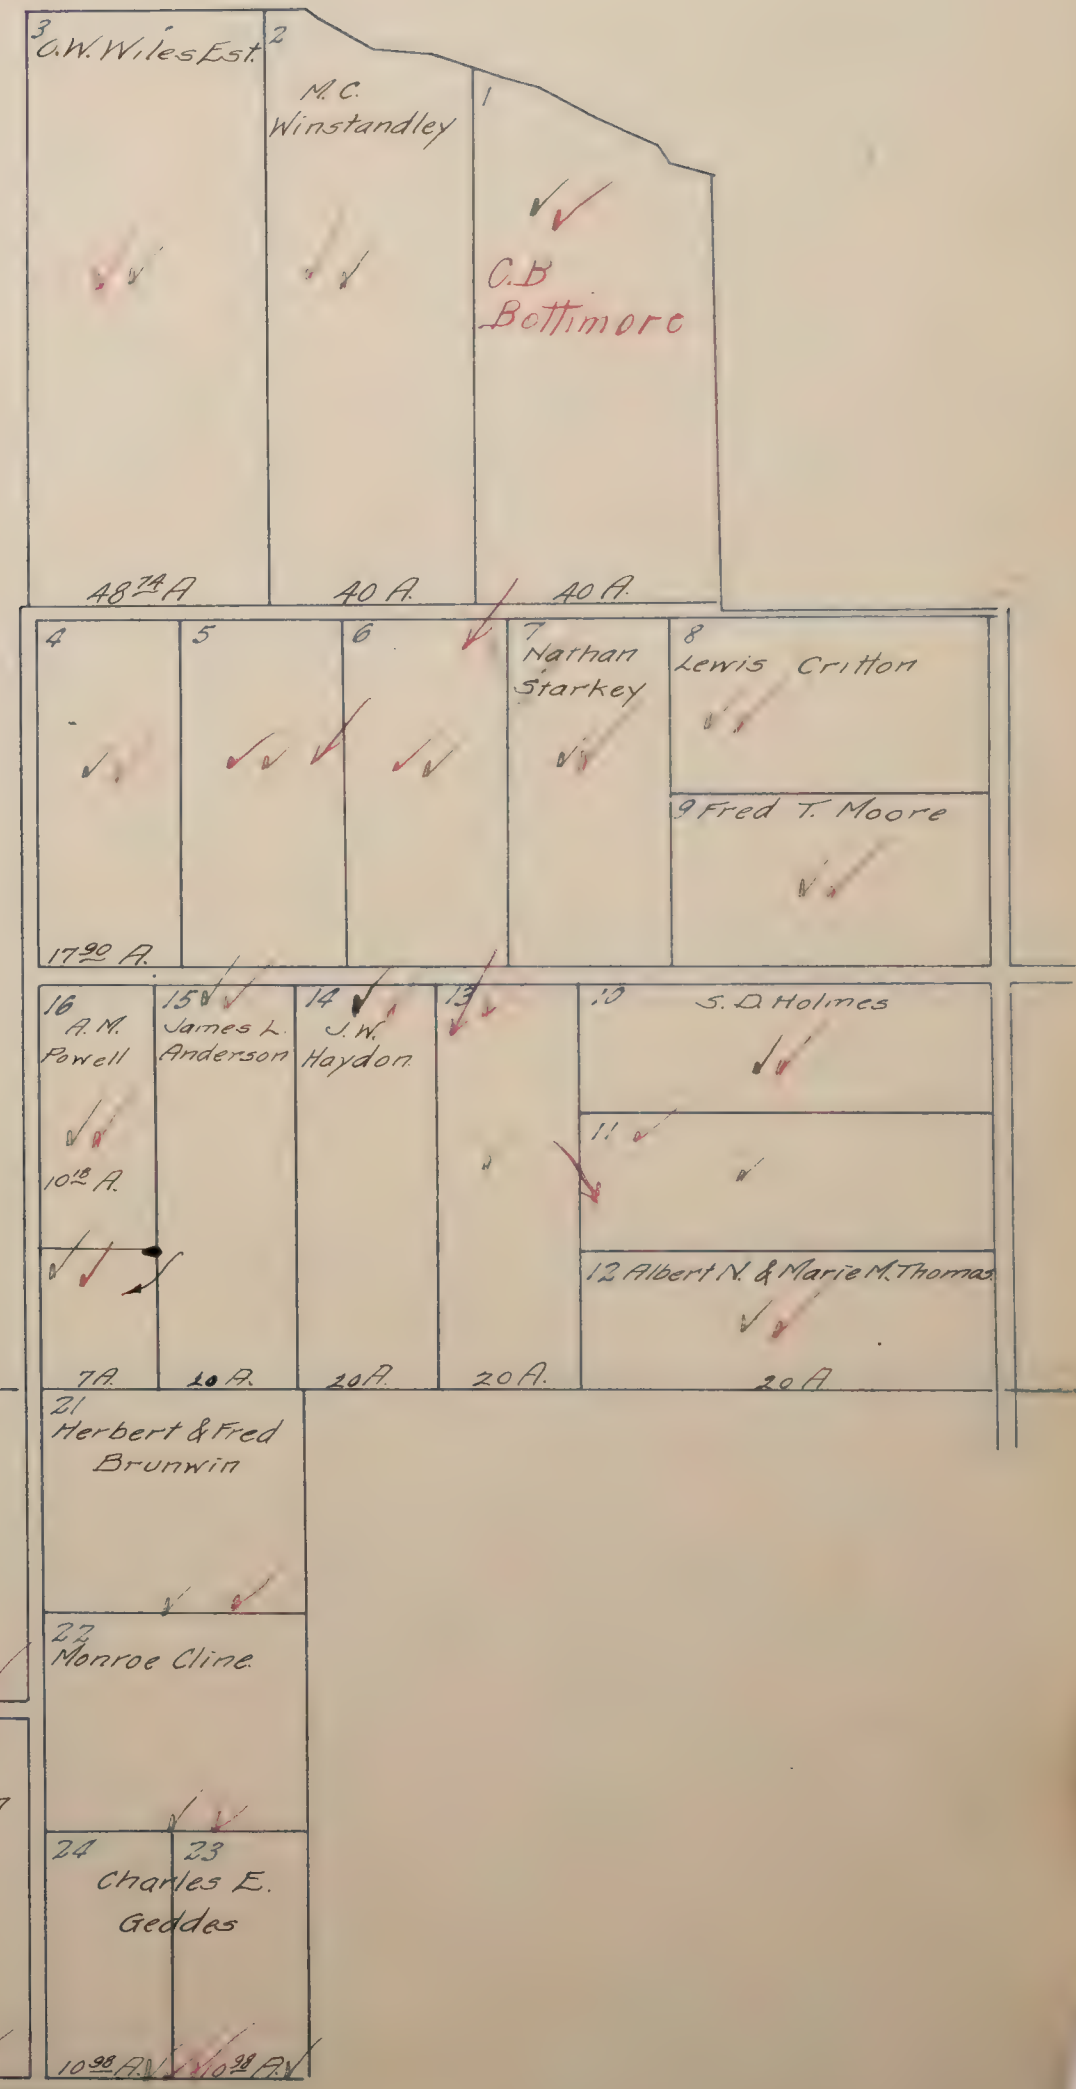

Turn Cities SD.

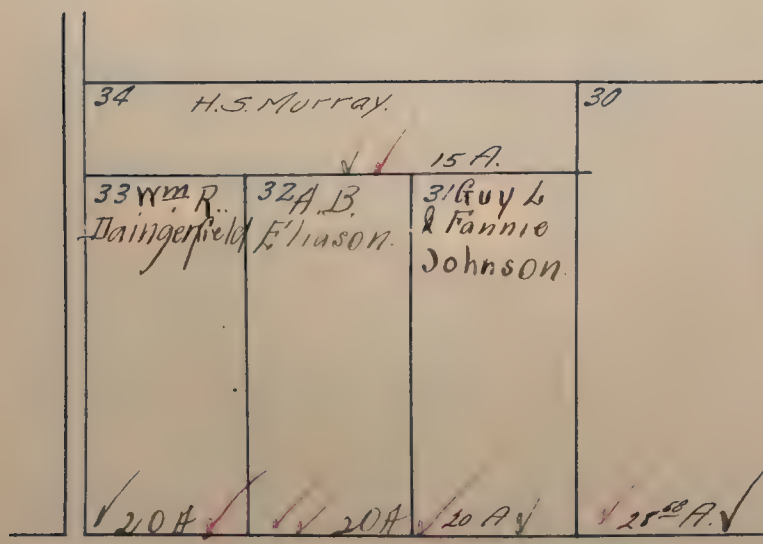

Black Ink-1919 Ownershir
Red Ink-1920 Ownership

RAY & MILES SUBD.

LOCATED IN
Secs. 23, 25 & 30, T. 5 N., R. 6 & 7 E., M. D. B. & N.
Scale: 500' = 1"

Blanks to Ellen Cornell ✓✓

Galt S.D.

COUNTY				ROAD			
12 G. A. Miles. ✓✓ 10 ⁹⁴ A	19 ✓✓ 10 ⁹⁴ A	20 ✓✓ 10 ⁹⁴ A	27 Chas. N. Klett. ✓✓ 9 ⁹⁴ A	28 Chas. N. Klett. ✓✓ 10 ⁹⁴ A	35 ✓✓ 7 ⁵² A	36 ✓✓	38 Alex. Barquist. ✓✓
13 ✓✓ 10 ⁹⁴ A	18 ✓✓ 10 ⁹⁴ A	21 ✓✓ 10 ⁹⁴ A	26 ✓✓ 9 ⁹⁴ A	29 Clayton G. Wood. ✓✓ 10 ⁹⁴ A	34 ✓✓ 7 ⁵² A	20 ⁹⁴ A	30 ⁹⁴ A
14 ✓✓ 11 ²² A	17 ✓✓ 10 ⁹⁴ A	22 Clara & Wm. S. Kates. ✓✓ 10 ⁹⁴ A	25 Allie W. Metzler & Lucille Waterbury. ✓✓ 9 ⁹⁴ A	30 ✓✓ 10 ⁹⁴ A	33 ✓✓ 7 ⁵² A	37 ✓✓ 49 ²² A	
15 Christian Larsen ✓✓ 11 ²² A	16 Rob. T. Callaghan ✓✓ 10 ⁹⁴ A	23 Wilhelm Schmid. ✓✓ 5 ⁹⁴ A	24 Alma W. Metzler. ✓✓ 9 ⁹⁴ A	31 ✓✓ 10 ⁹⁴ A	32 ✓✓ 7 ⁵² A		
COUNTY				ROAD			

Black Ink-1919 Ownership
Red Ink-1921 Ownership

RAY & MILES SUBD.


LOCATED IN

Secs. 23, 25 & 30, T.5N., R.6&7E., M.D.B. & M.

Scale: 500' = 1"

Blanks to Ellen Cornell ✓

Galt S.D.

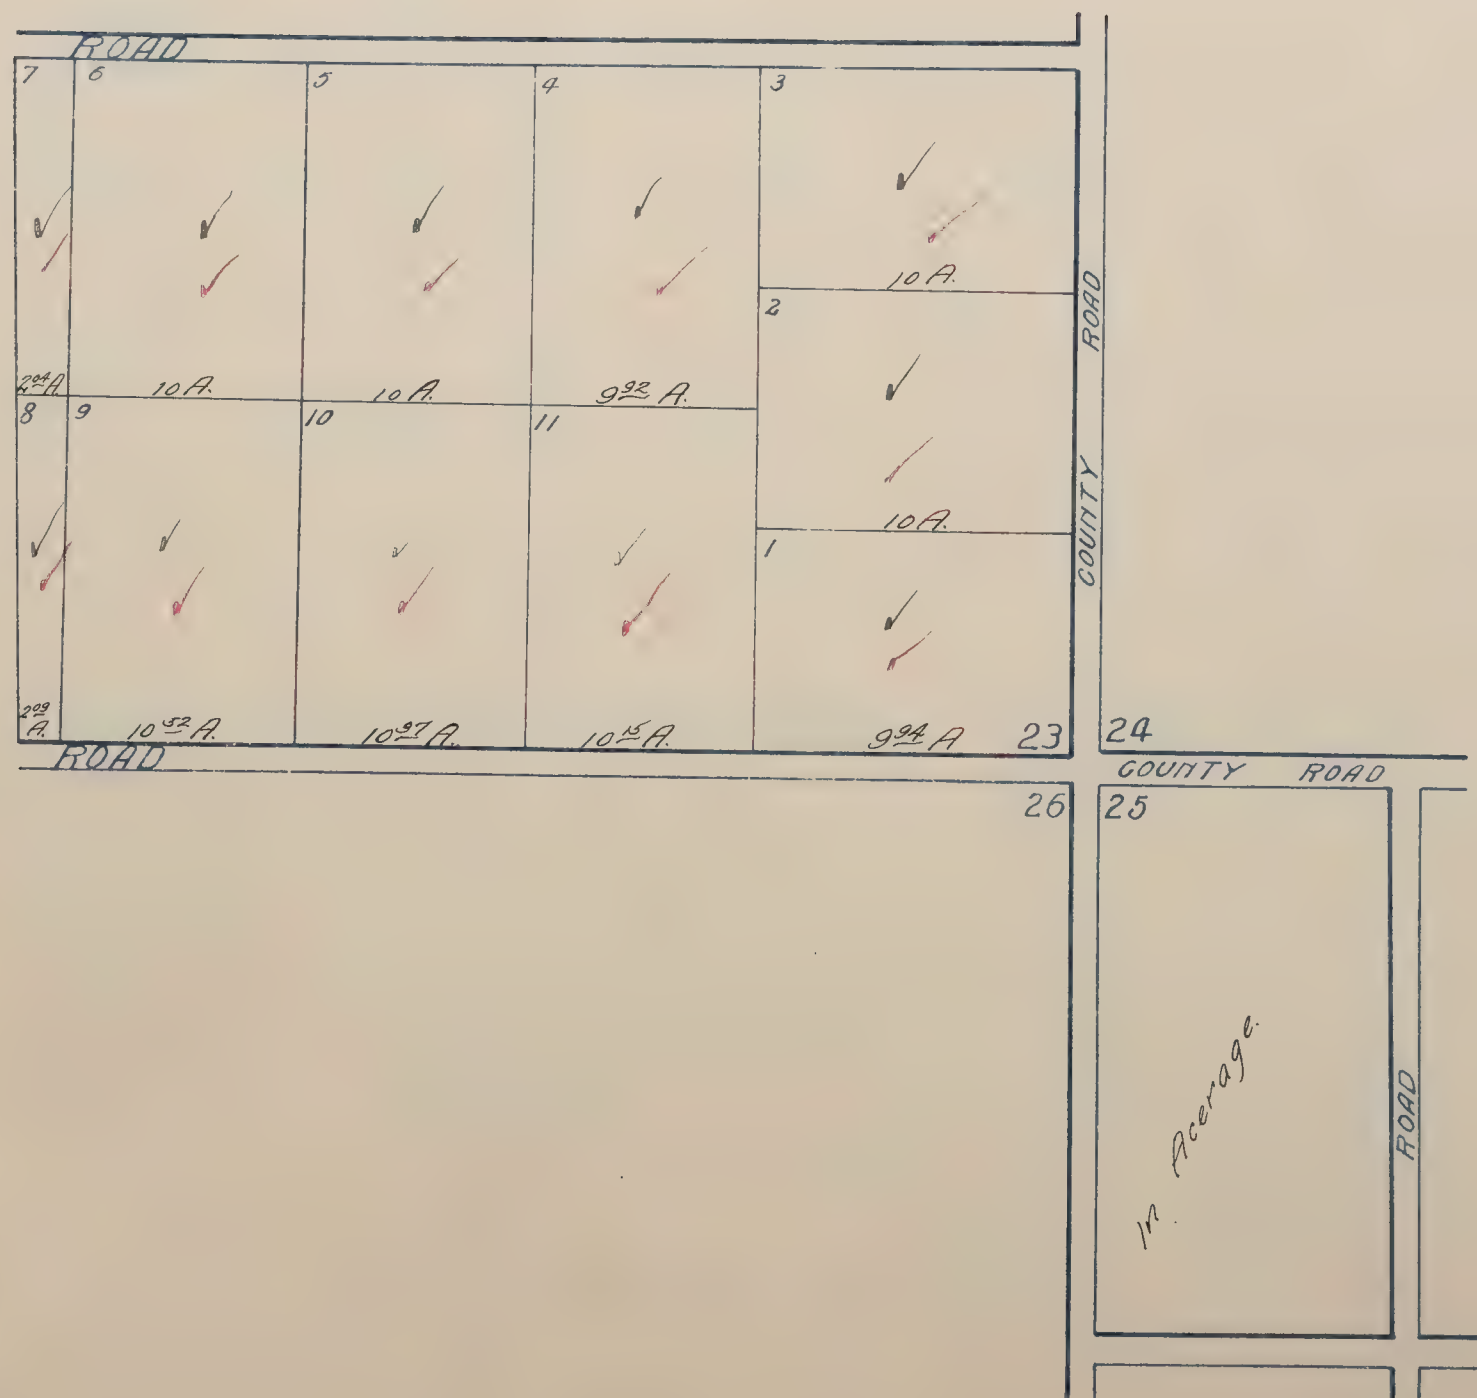

RICHLAND


BEING

E $\frac{1}{2}$ of N.W. $\frac{1}{4}$ SEC. 27 T. 8. N. R. 5 E

Scale 1" = 240 ft

Black Ink-1919 Ownership
Red Ink-1920 Ownership

Elder Creek S.D.

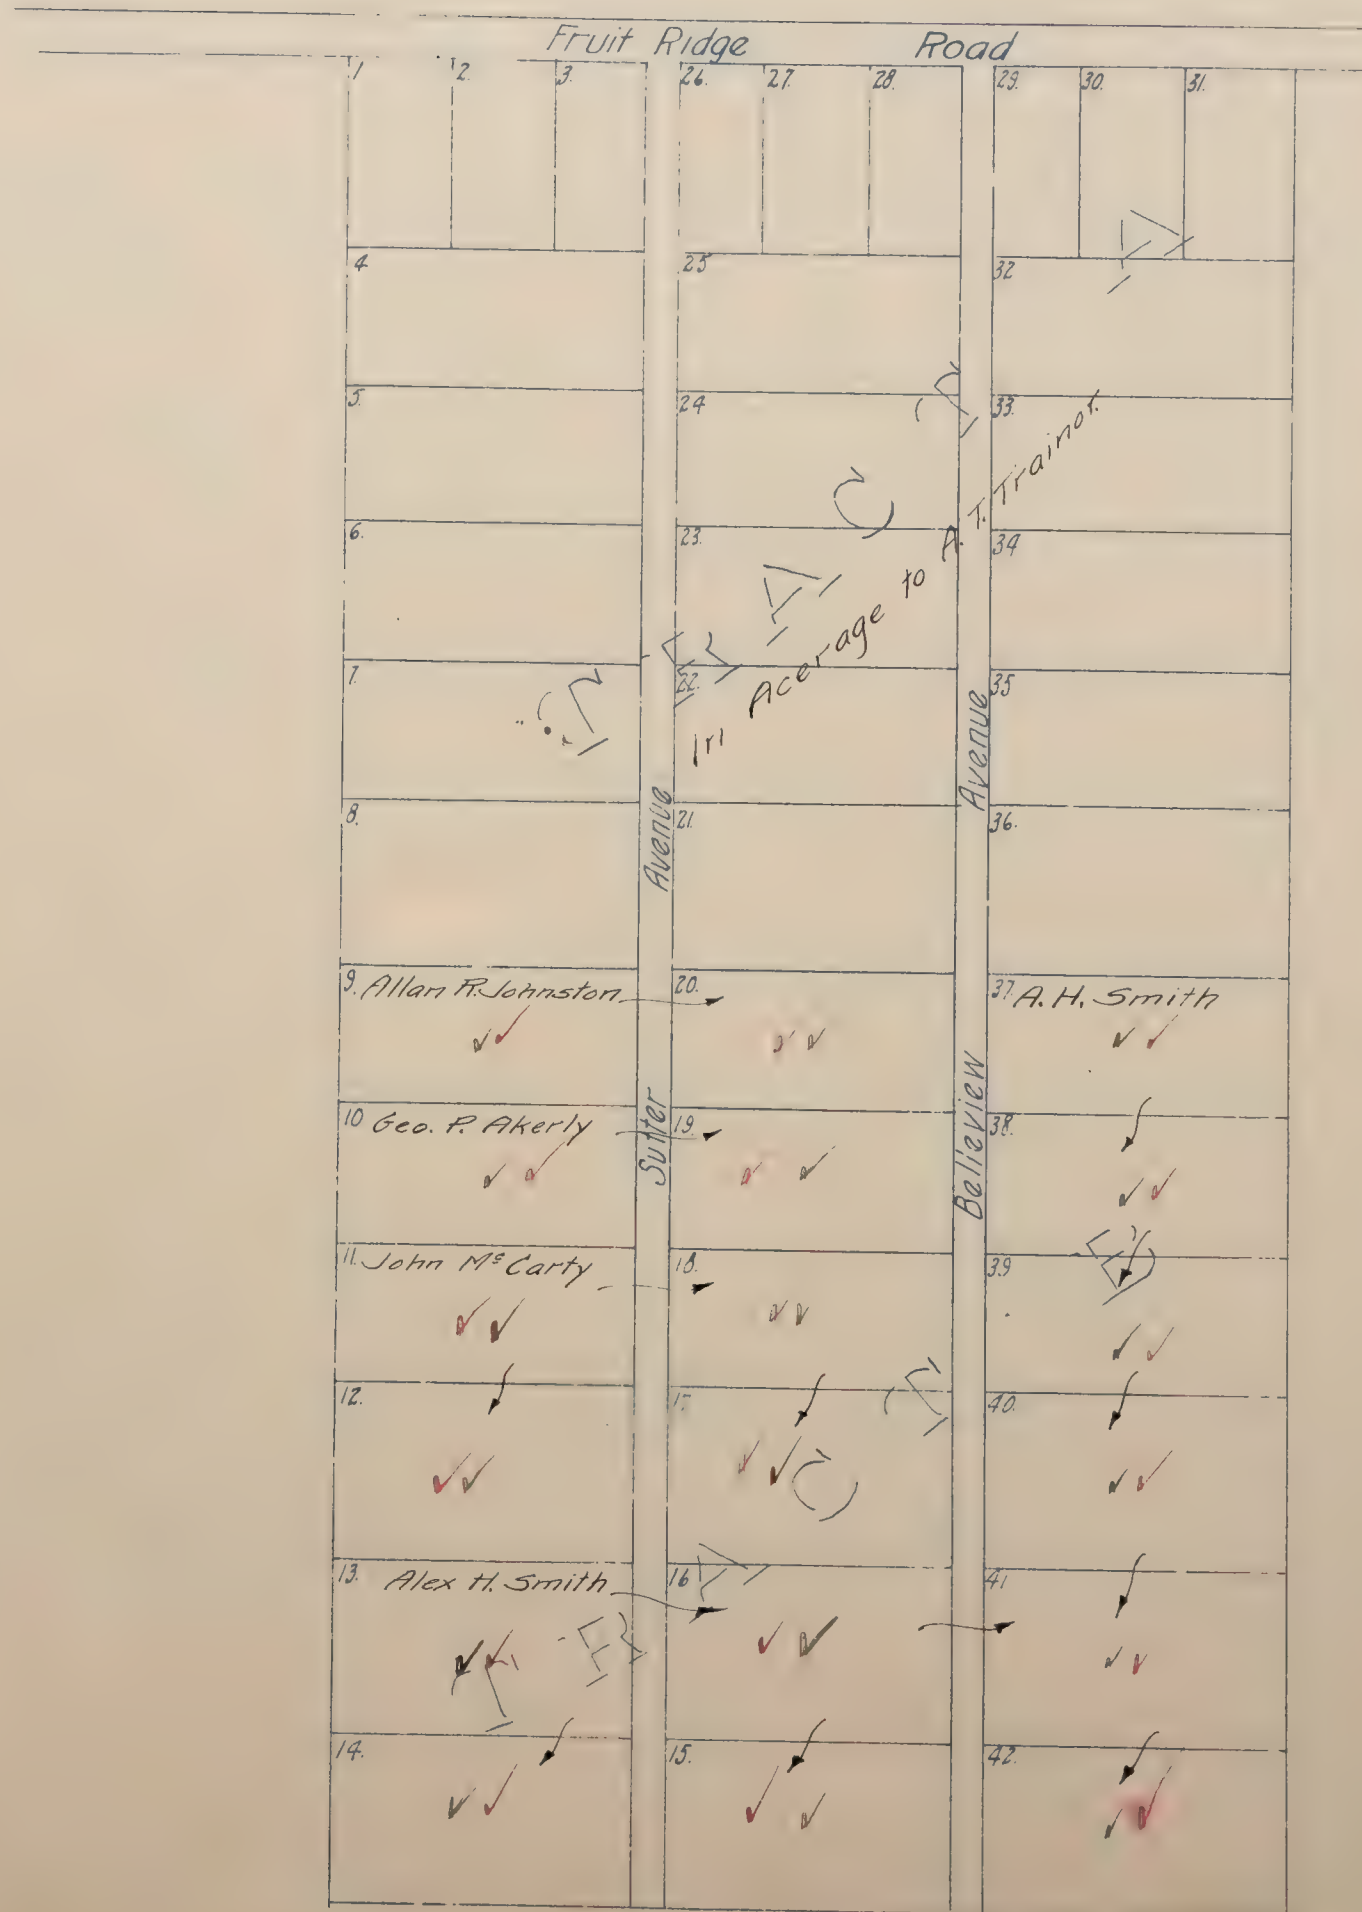

Black Ink-1910 Ownership
Red Ink-1920 Ownership

RIO LINDA

SUB'D'N NO.1

located in


Sec 21 & Sec F Rancho Del Paso

Scale: 1" = 10 Chs.

RIO LINDA. S. D.

Blanks to Interurban Acres Land Co. ✓✓✓
All Lots 10 Acres except where otherwise noted.

FRUITVALE, S. D.

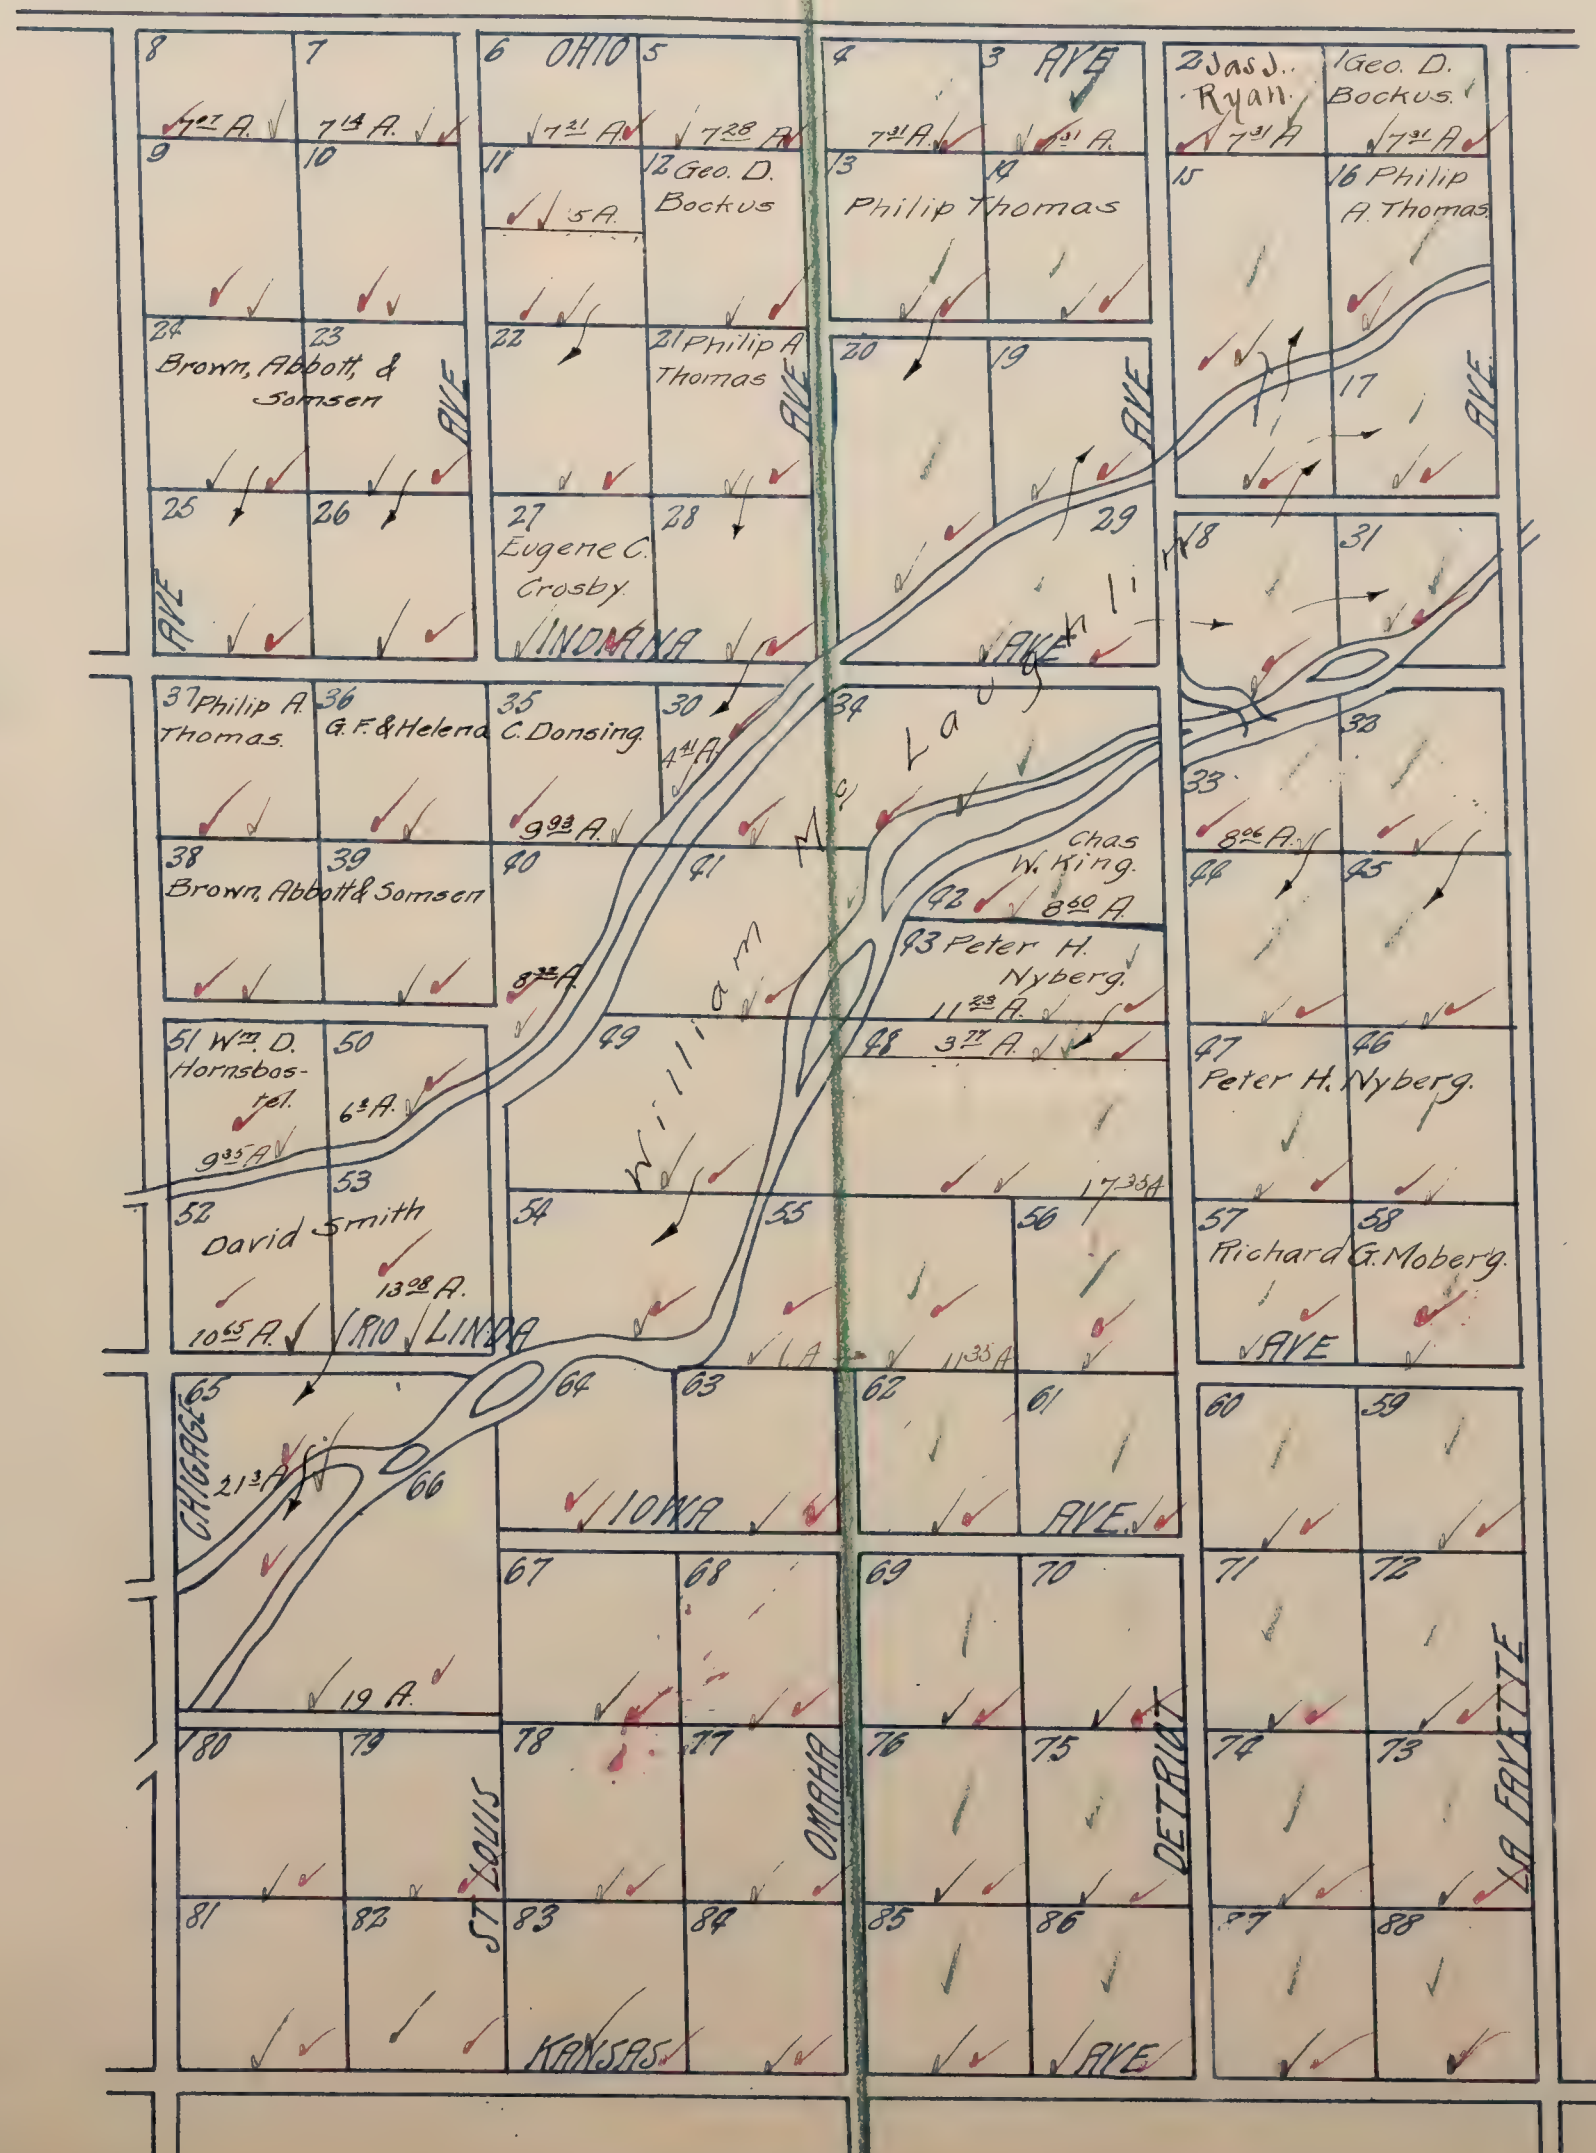

Black Ink=1919 Ownership
Red Ink=1920 Ownership

RIO LINDA
SUBDIVISION NO.2

located in
Sec's E & 8 Rancho Del Paso
Scale: 1" = 500'

Pro Linda
LINDA S.D.

Blanks to Sac. Suburban Fruit Lands
All Lots 10 Acres unless otherwise noted.



Also checked in
N2 of SW1/4 of NW1/4 of
SW1/4 - Sec - 8
Rancho Del Paso

Mapped.


Black Ink-1919 Ownership
Red Ink-1920 Ownership

RIO LINDA SUBD'N NO.3

located in
Sec's 7 & D Rancho Del Paso
Scale: 1"=500'

*Rio Linda
Lincoln S.D.*

Blanks to Sacto. Suburban Fruitlands Co. ✓
All Lots 10 Acres unless otherwise noted.

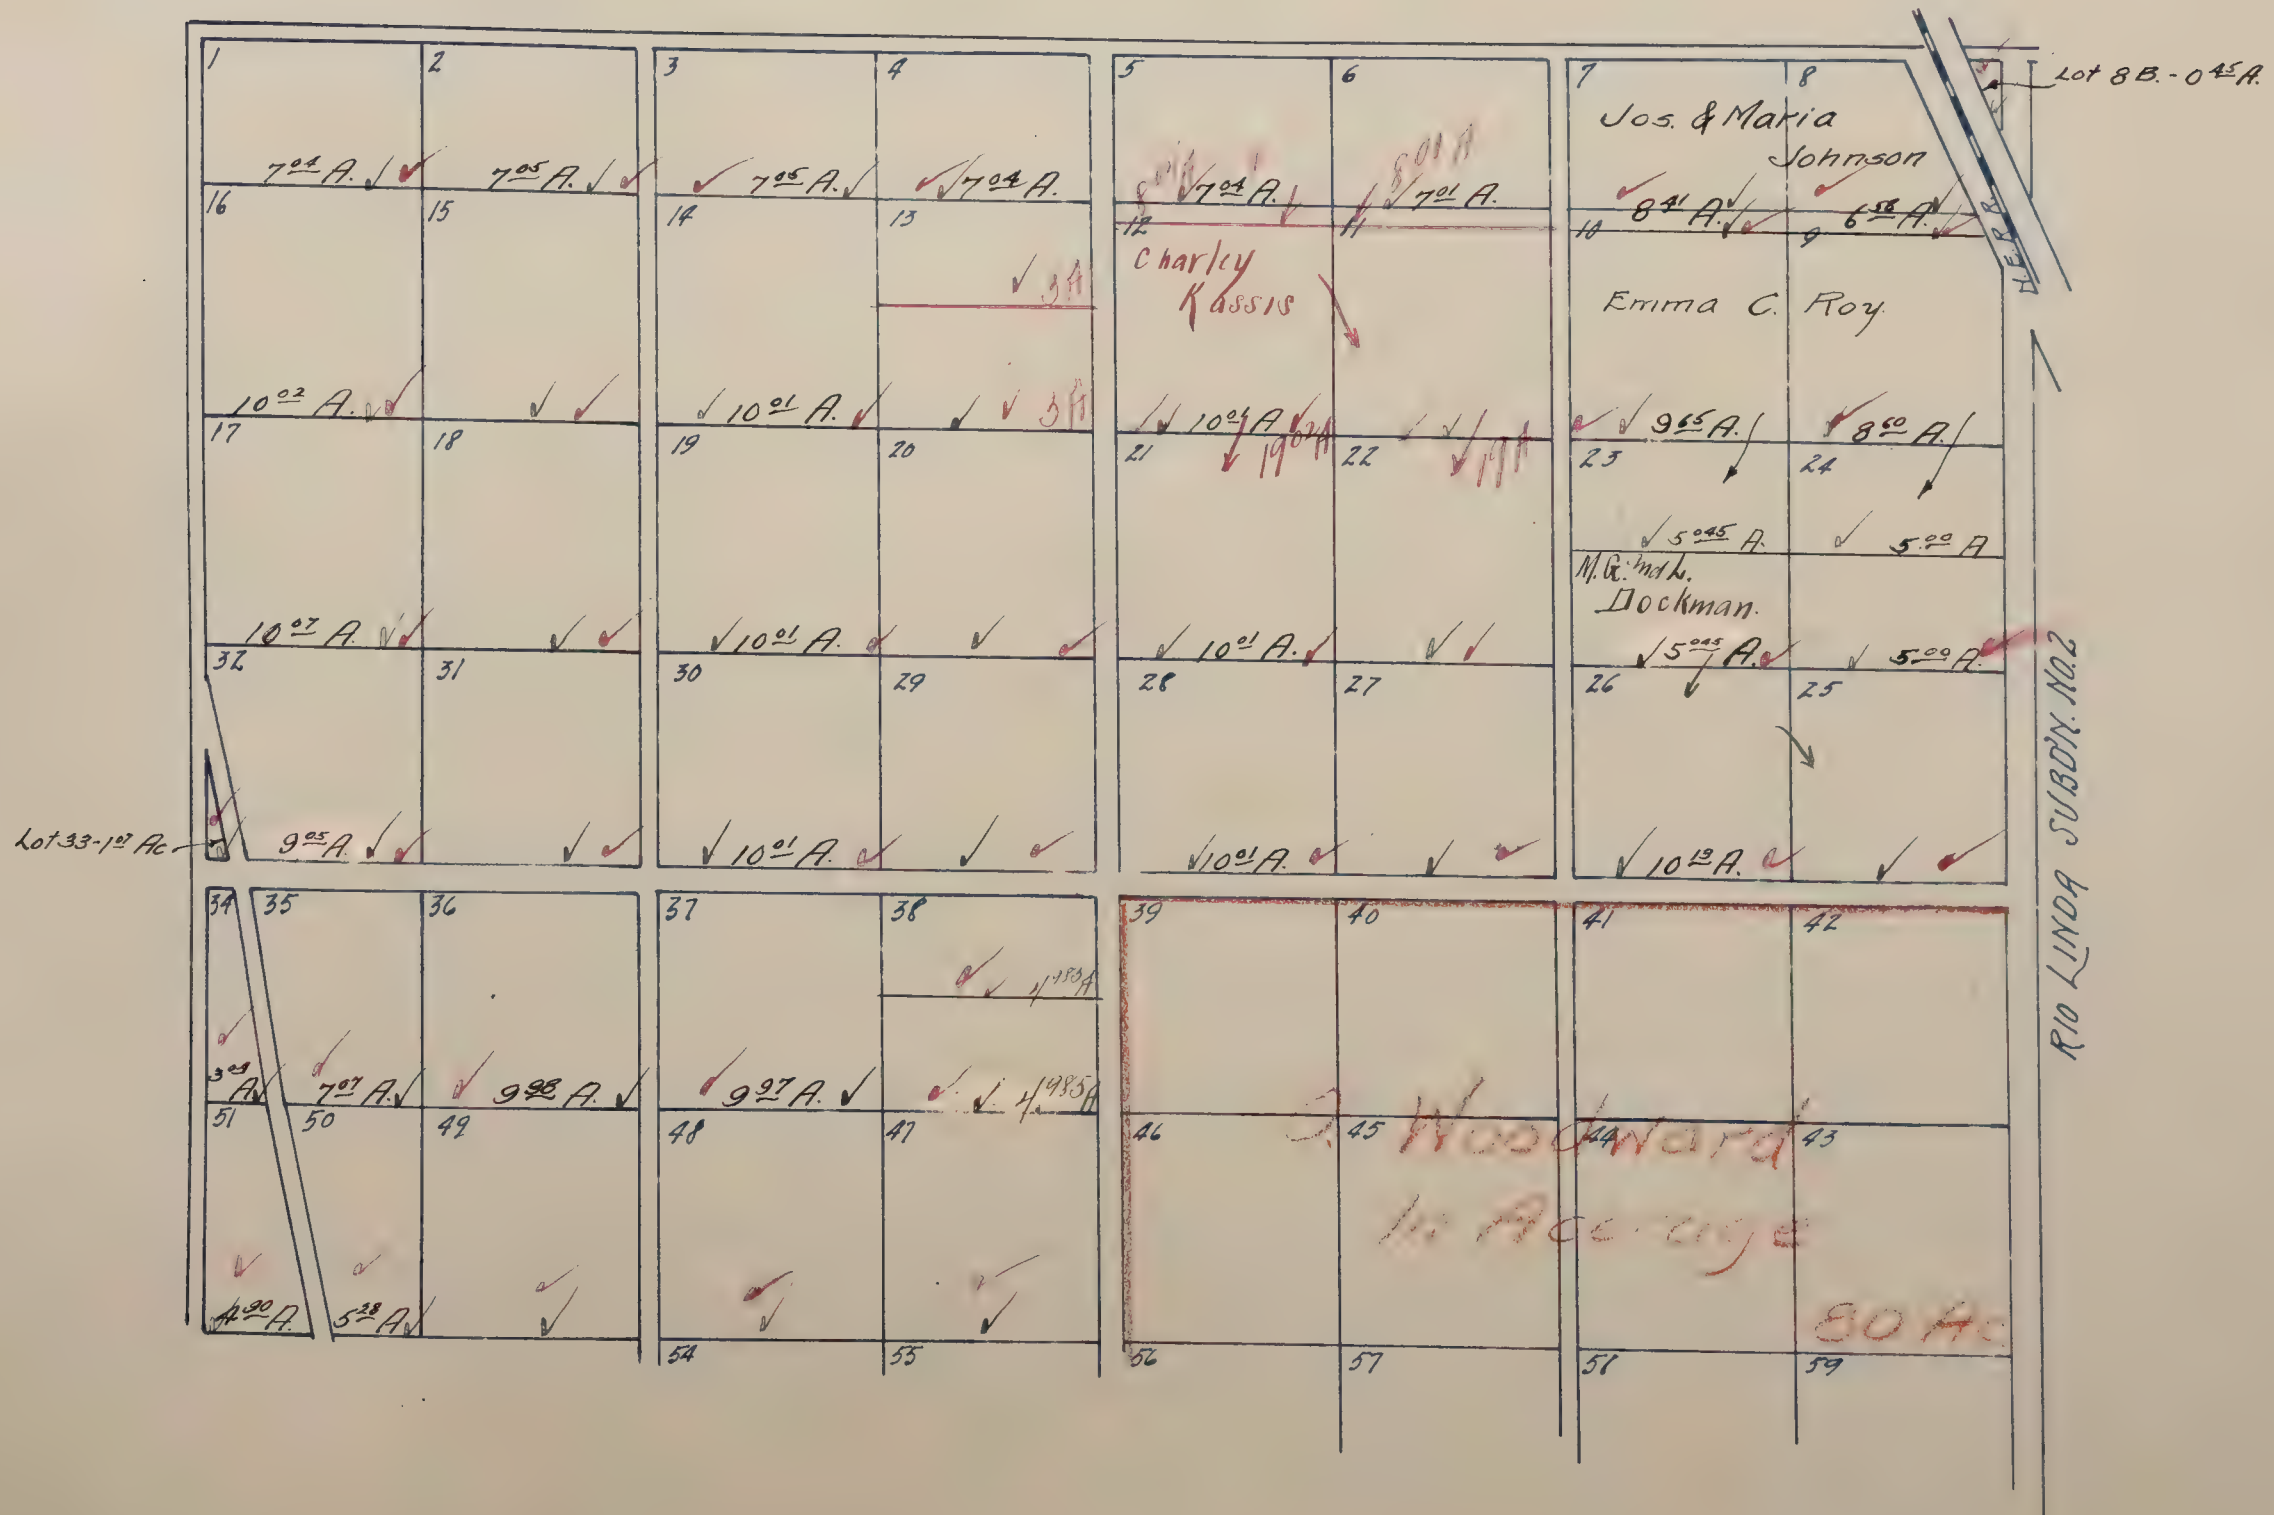

Black Ink-1919 Ownership
Red Ink-1920 Ownership


Maplet.

RIO LINDA SUBDN NO.3

located in
Secs 7 & D. Rancho Del Paso
Scale: 1"=500'

Rio Linda
Lincoln S.D.

Blanks to Sacto. Suburban Fruit Lands Co. ✓
All Lots 10 Acres unless otherwise noted.

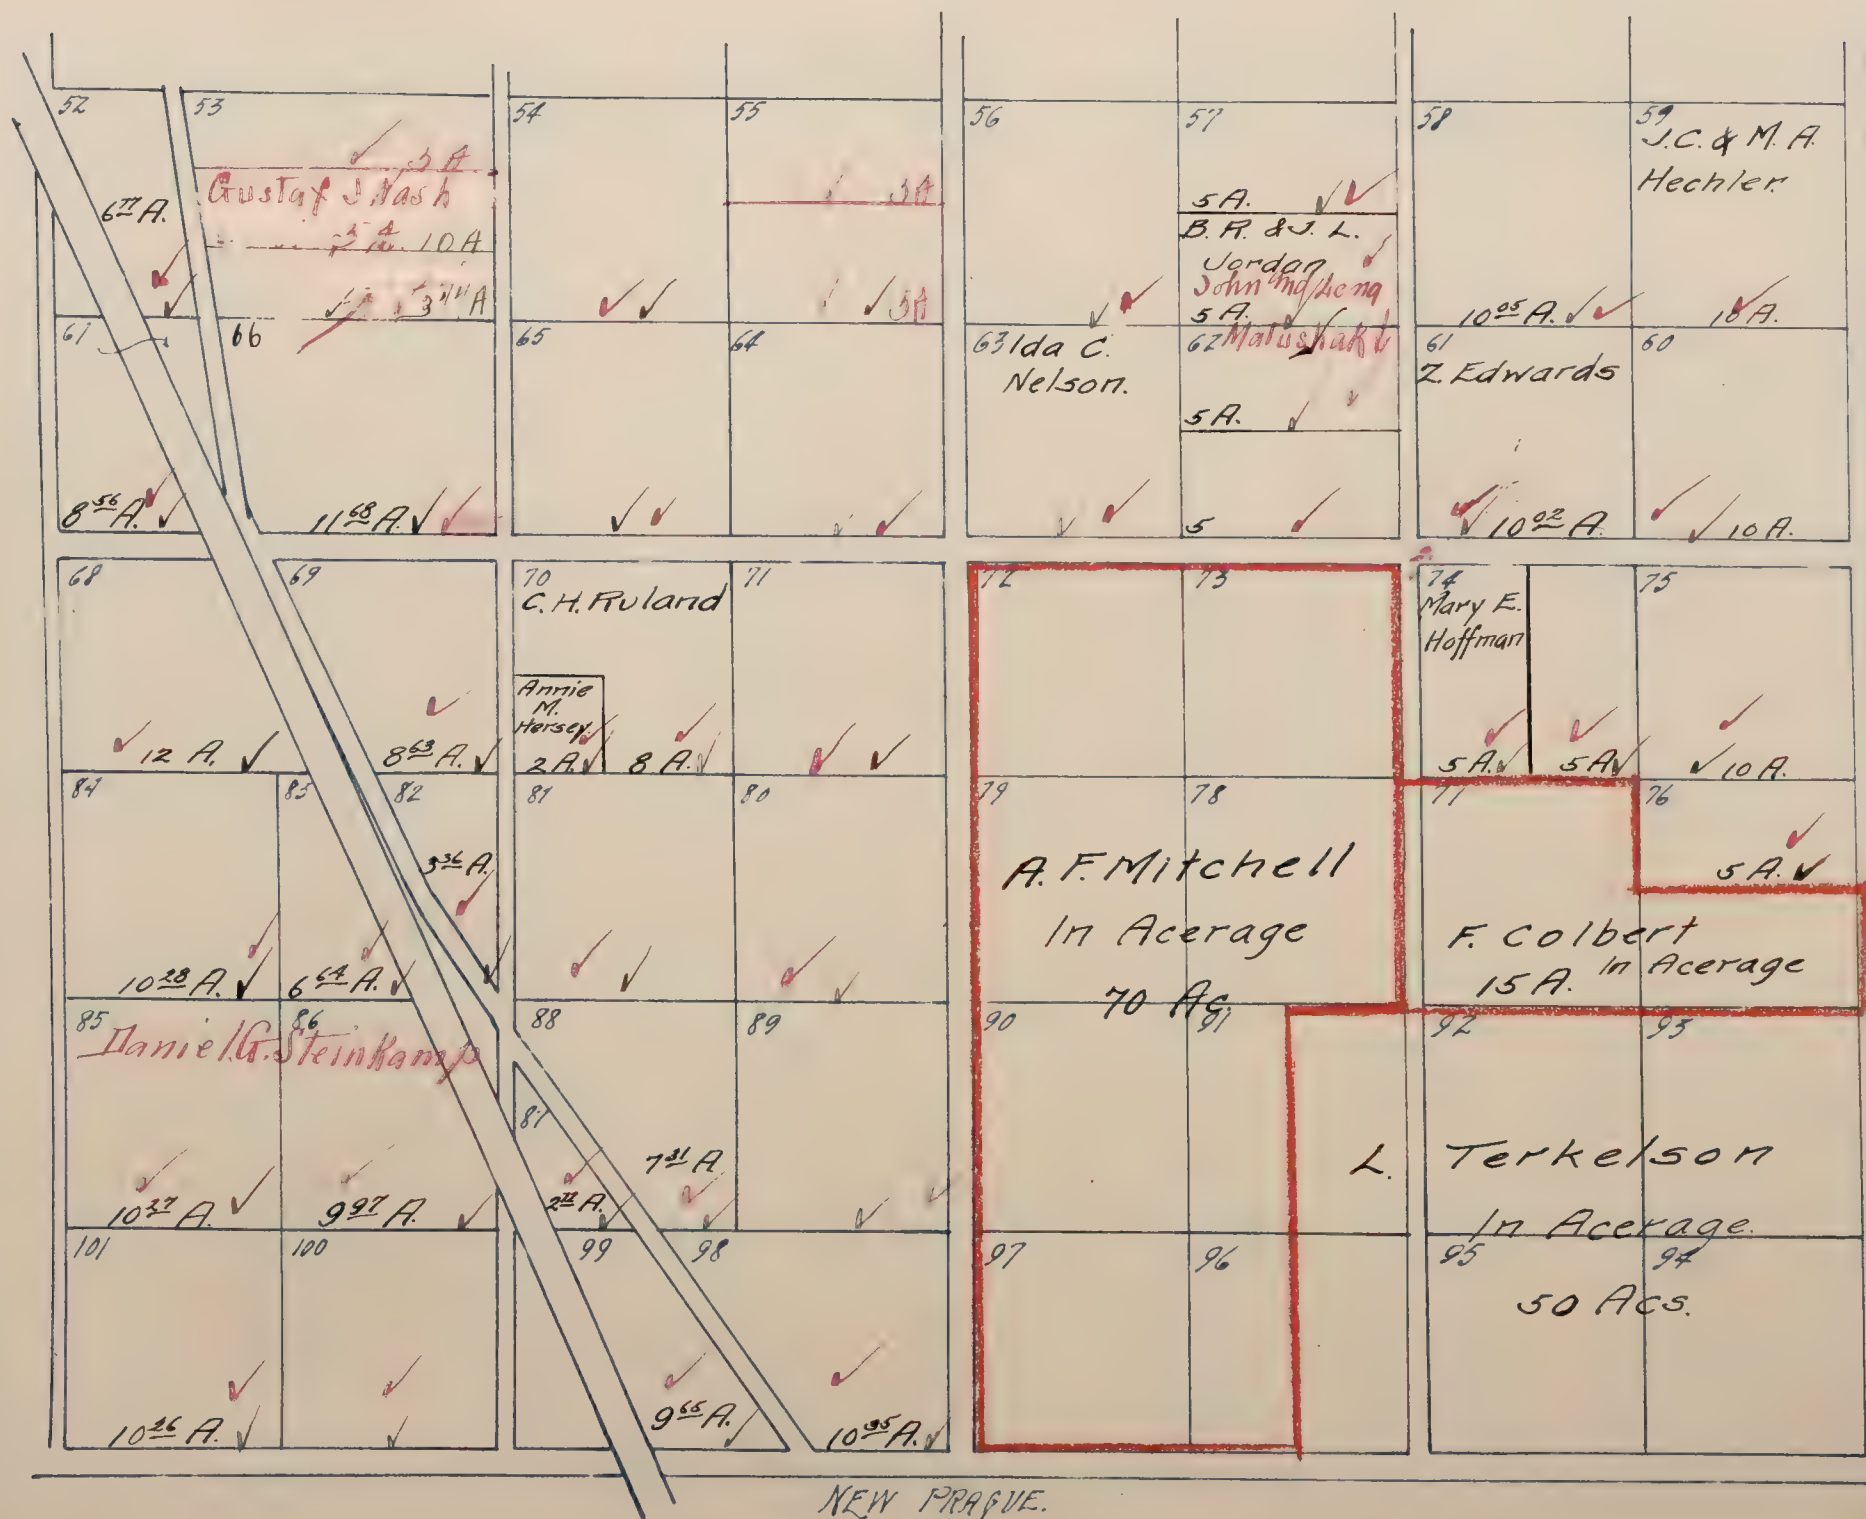

NEW PRAGUE.

RIO LINDA SUBDN NO.2

Black Ink-1919 Ownership
Red Ink-1920 Ownership

Rio Linda S.D.



Hubla S. D.

ACME ACRES

Mapped.


Blanks to Sac. Suburban Fruit Lands Co. ✓

Black Ink-1919 Ownership
Red Ink-1910 Ownership

TOWN OF RIO LINDA

located in
Sec. 8 Rancho Del Pozo
Scale: 1"=200'

*Rio Linda
Lincoln Co. S.D.*

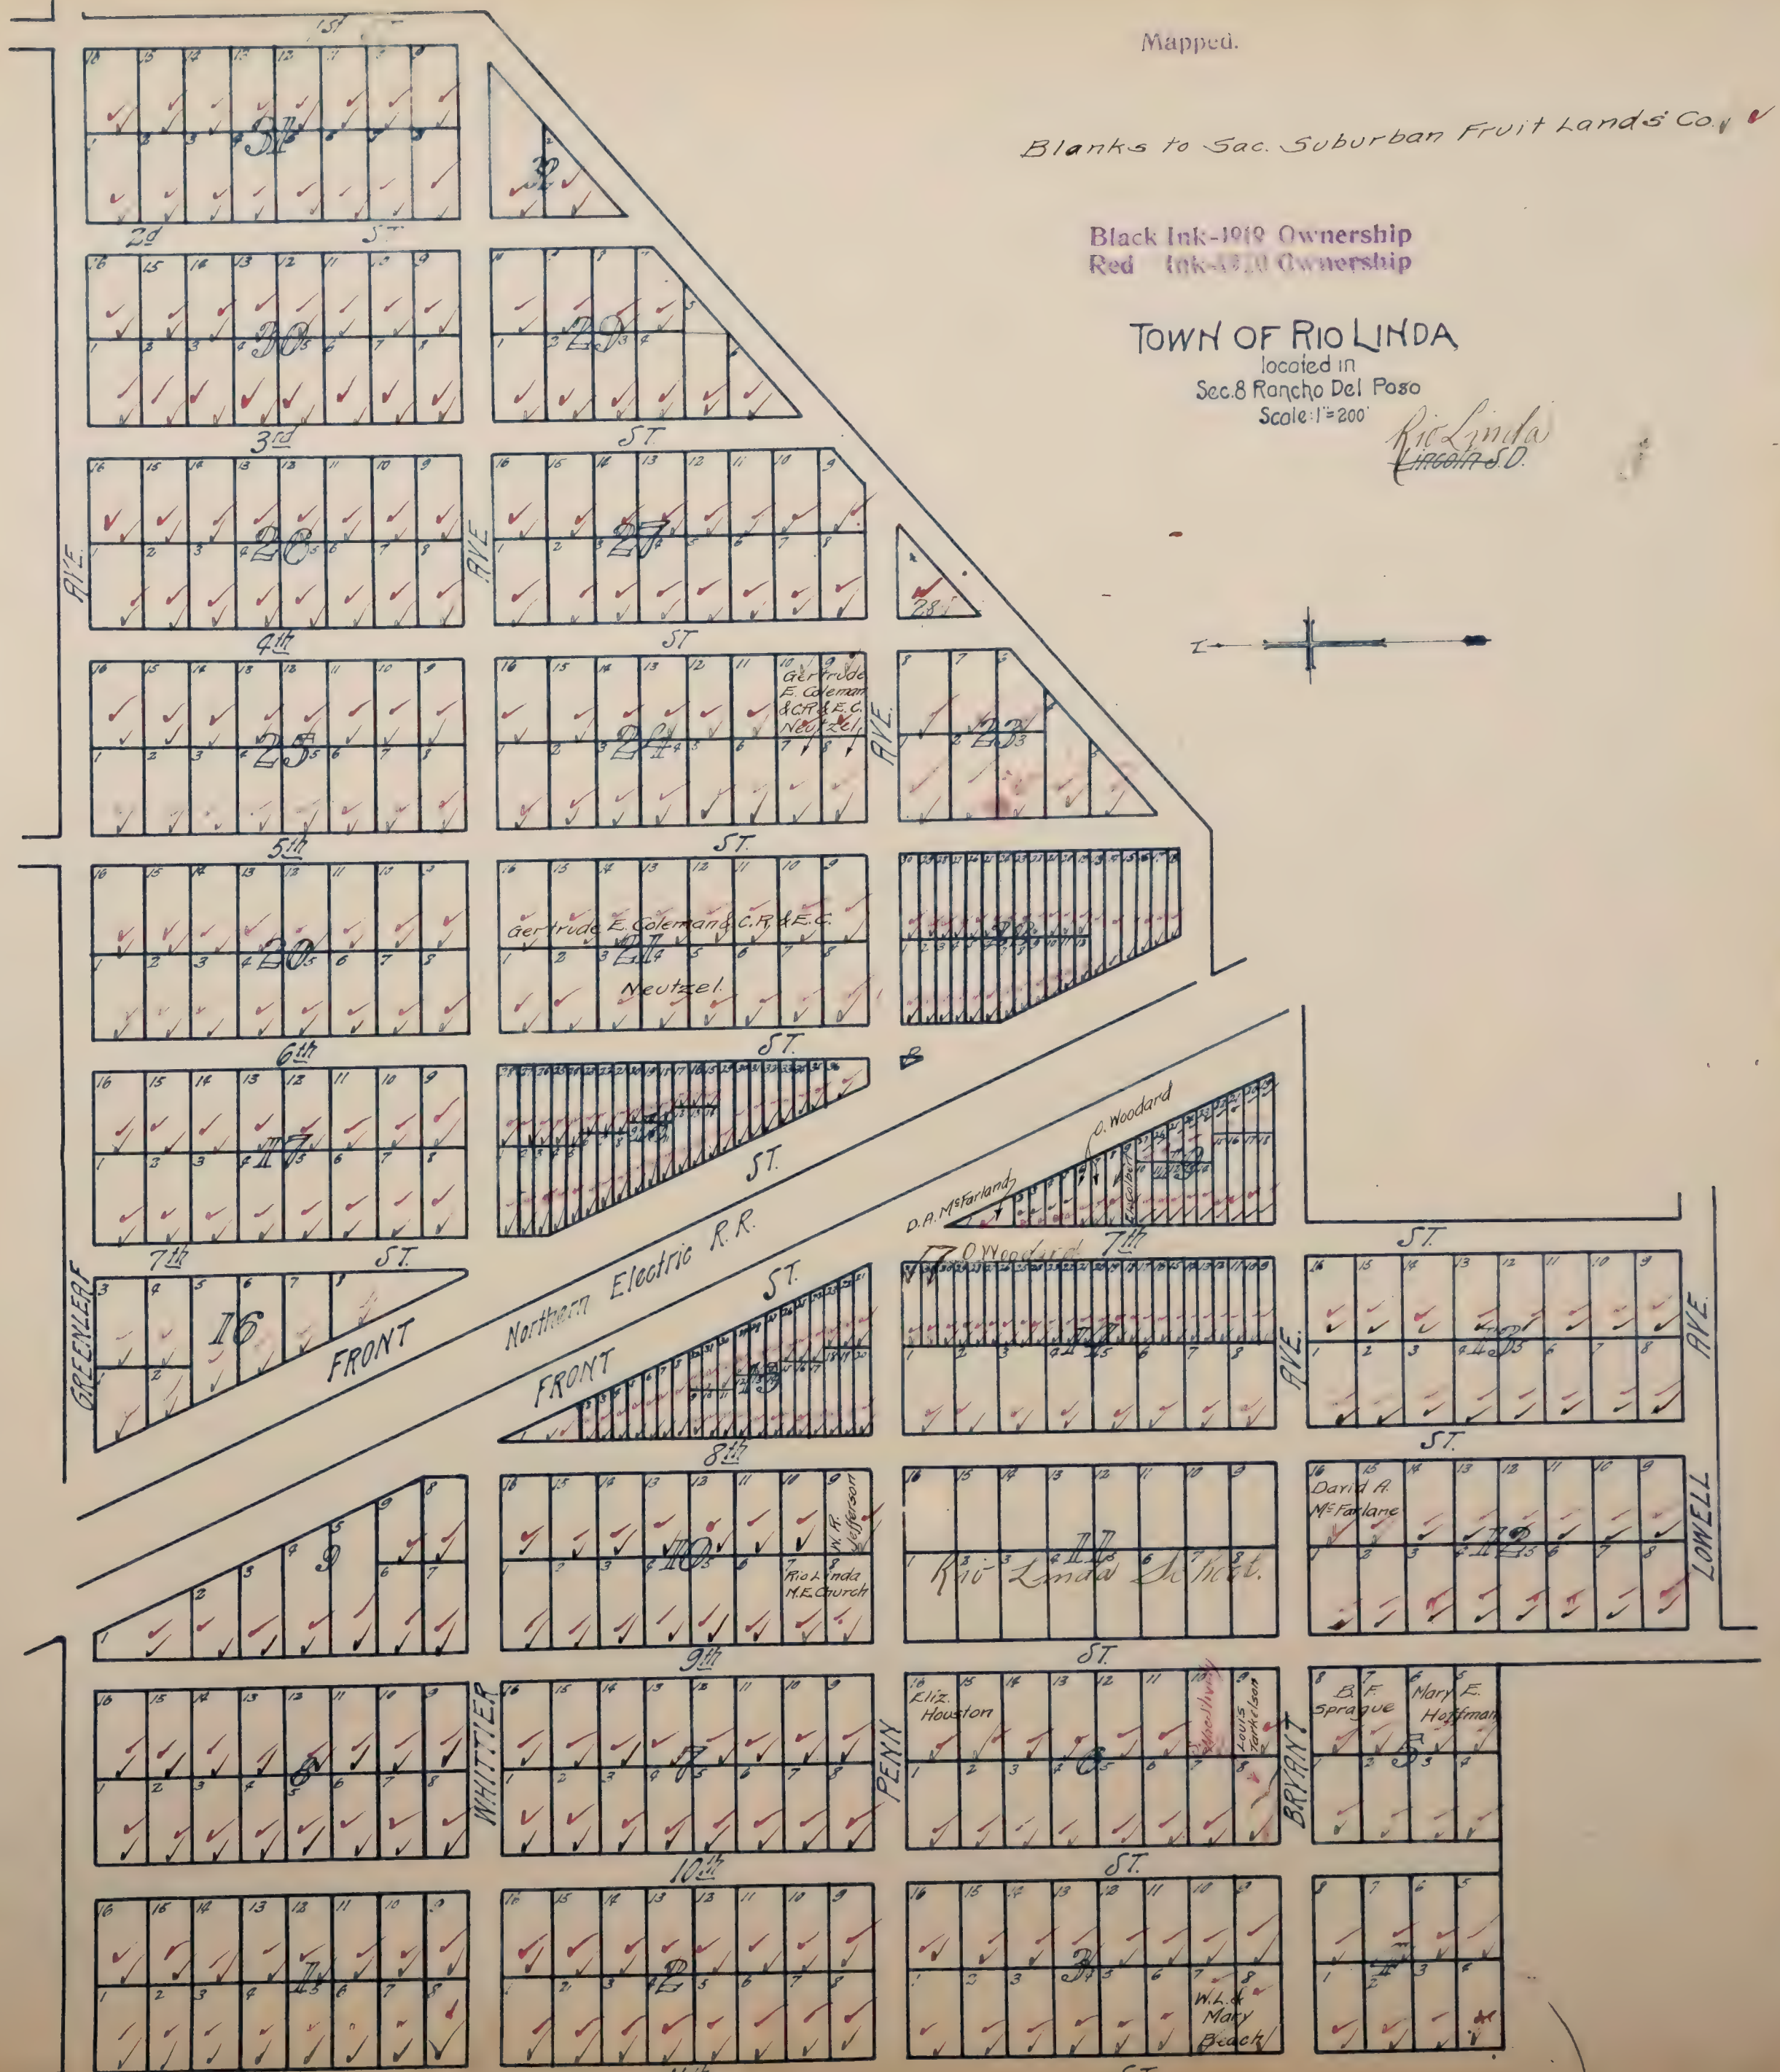


Black Ink-1919 Ownership
Red Ink-1920 Ownership
Mapped.

RIO RANCHO LAND SUBD.

Section 10
T. 10 N. R. 10 E. S. 10
Caddo County, Texas

Davis S.D.

All Lots 10 Acres unless otherwise noted.

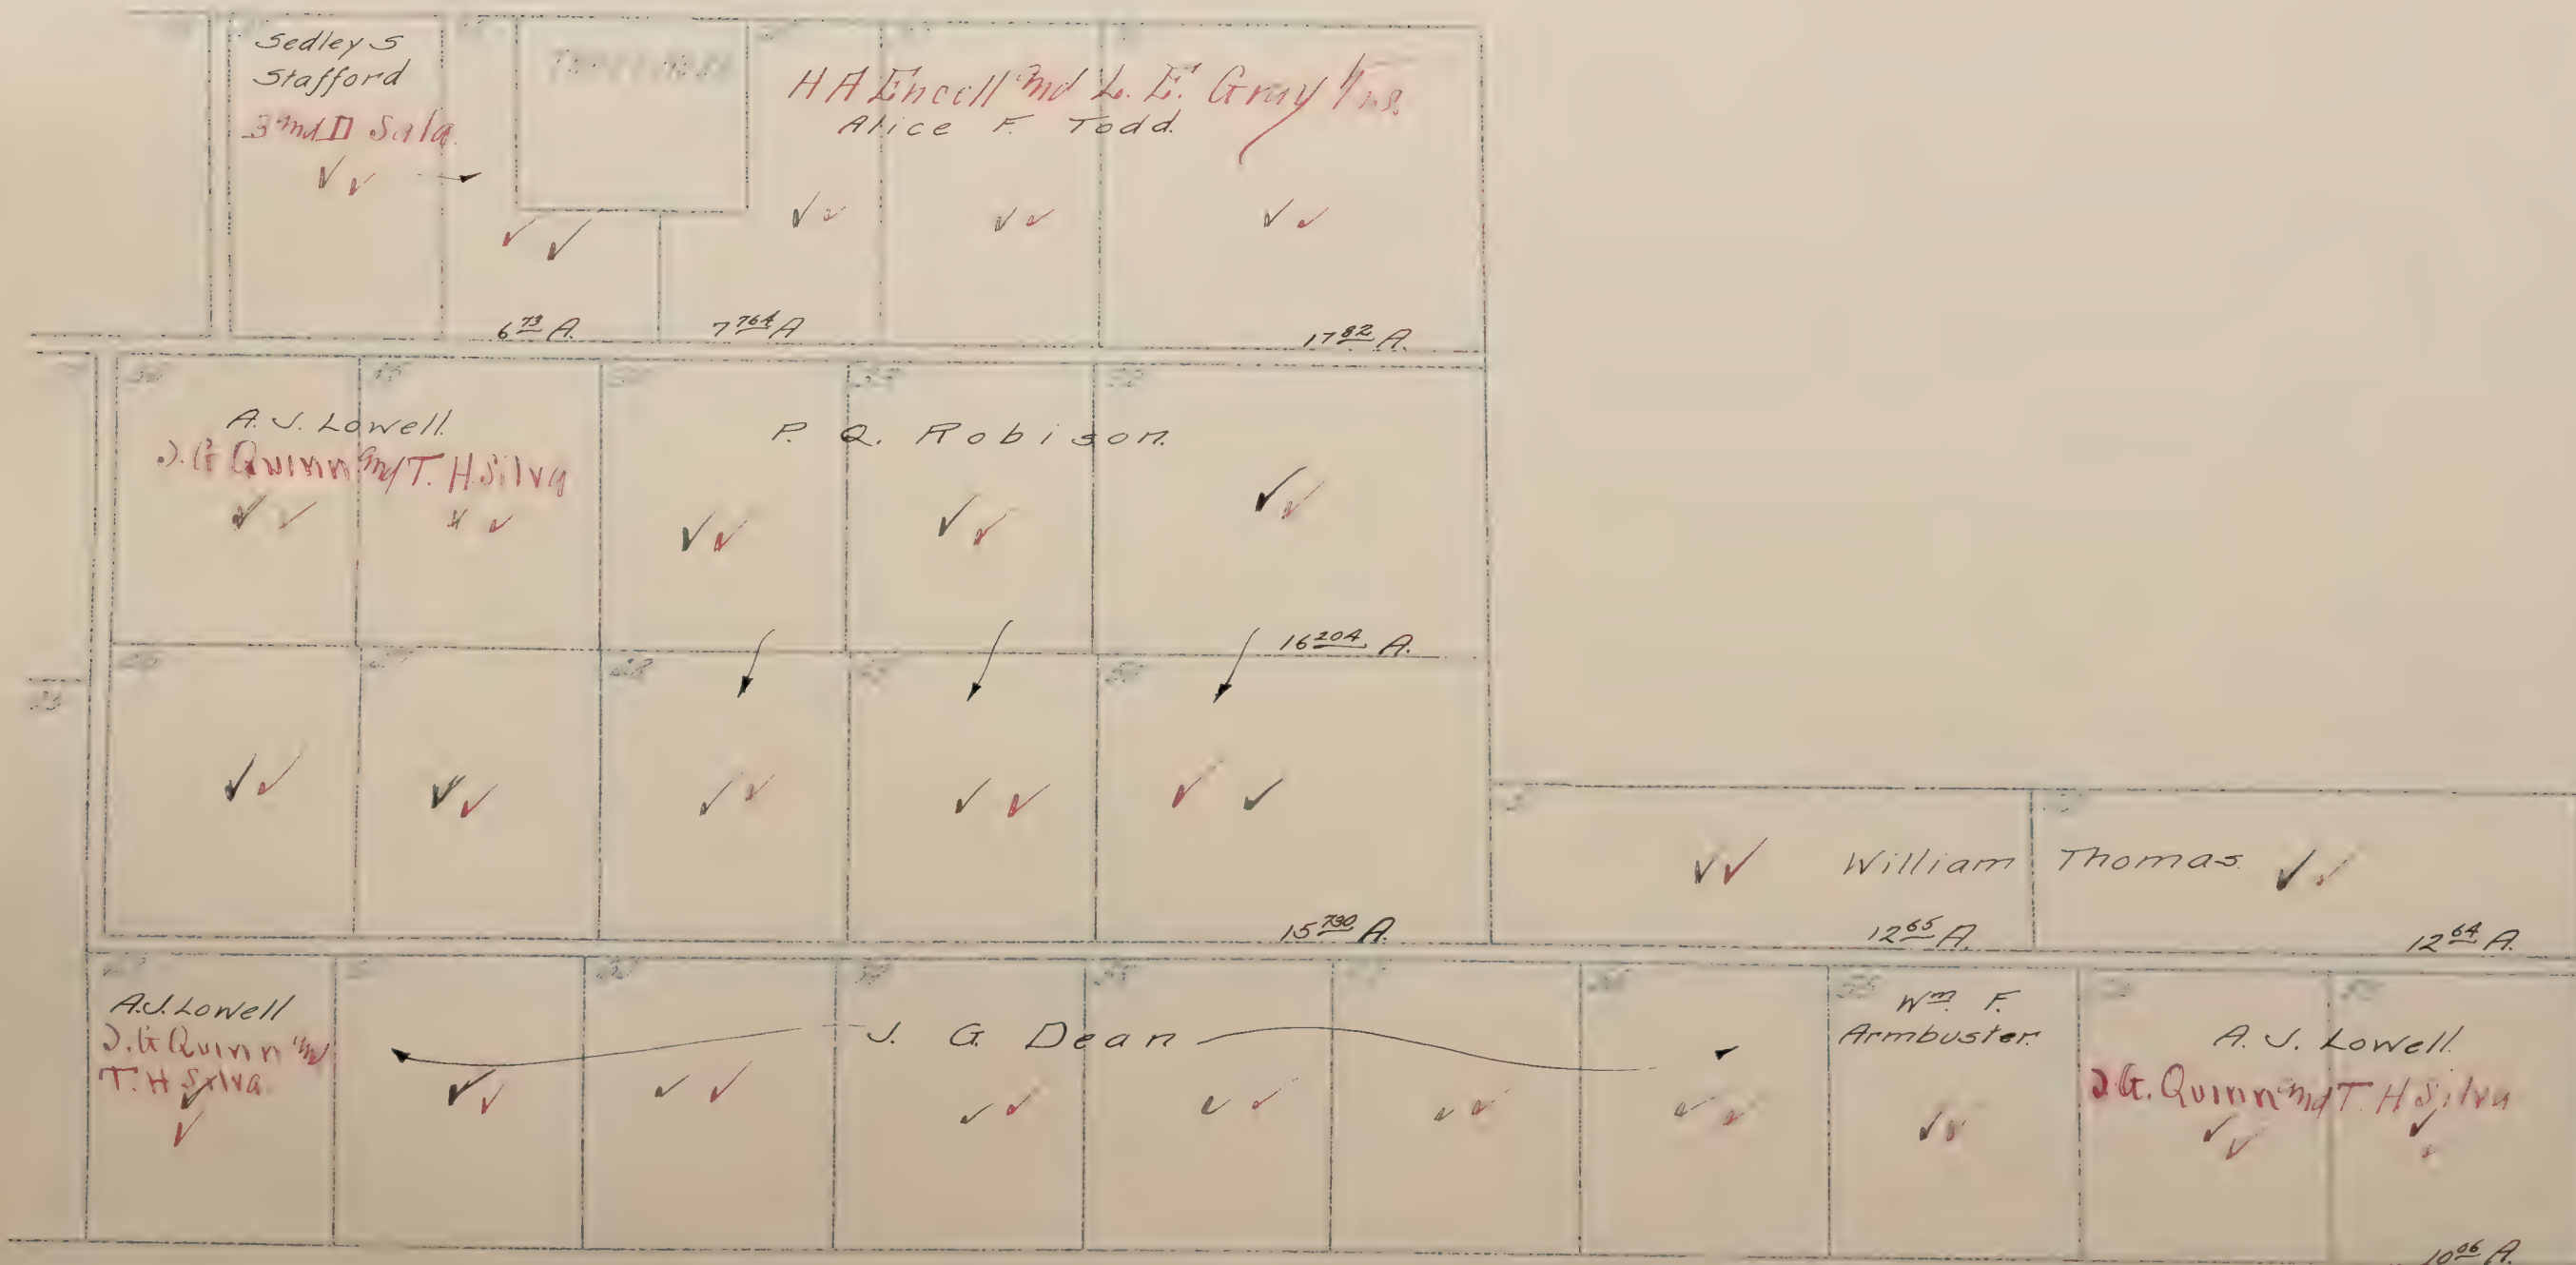

RIO RANCHO LAND SUBD.

located in
Sec's 14, 23, 24, T. 6 N. R. 6 E
Scale 1" = 400 ft

David L.D.
San Joaquin Co. SO.

Blanks to Jas. G. Quinn. ✓
All Lots 10 Acres unless otherwise noted.

Black Ink - 1919 Ownership
Red Ink - 1930 Ownership



Mapped.

Black Ink-1919 Ownership
Red Ink-1919 Ownership

RIVERSIDE ACRES

LOCATED IN
NW 1/4 of NE 1/4 Sec. 12 T 7 N R 4 E

Scale: 1" = 2 Chs

Frederick F. West Union S.L.

Blanks assessed to John T. Stall.

COUNTY	ROAD
6	1
✓✓ 4 ²² A	✓✓ 4 ²² A
7	2
✓✓ 4 A	✓✓ 4 A
8	3
✓✓ 3 ²² A	✓✓ 3 ²² A
9	4
✓✓ 3 ²² A	✓✓ 3 ²² A
10	5
✓✓ 3 ²¹ A	✓✓ 3 ²¹ A

Mappeu.

Black Ink-1919 Ownership
Red Ink-1910 Ownership

ROBLA ACRES


located in

S¹/₂ Sec. 10 T.9 N. R.5 E.

Scale: 1"=300'

Blanks to Fred G. Baird. ✓
All Lots 5 Acres unless otherwise noted

Robla
Robla Grove S.D.

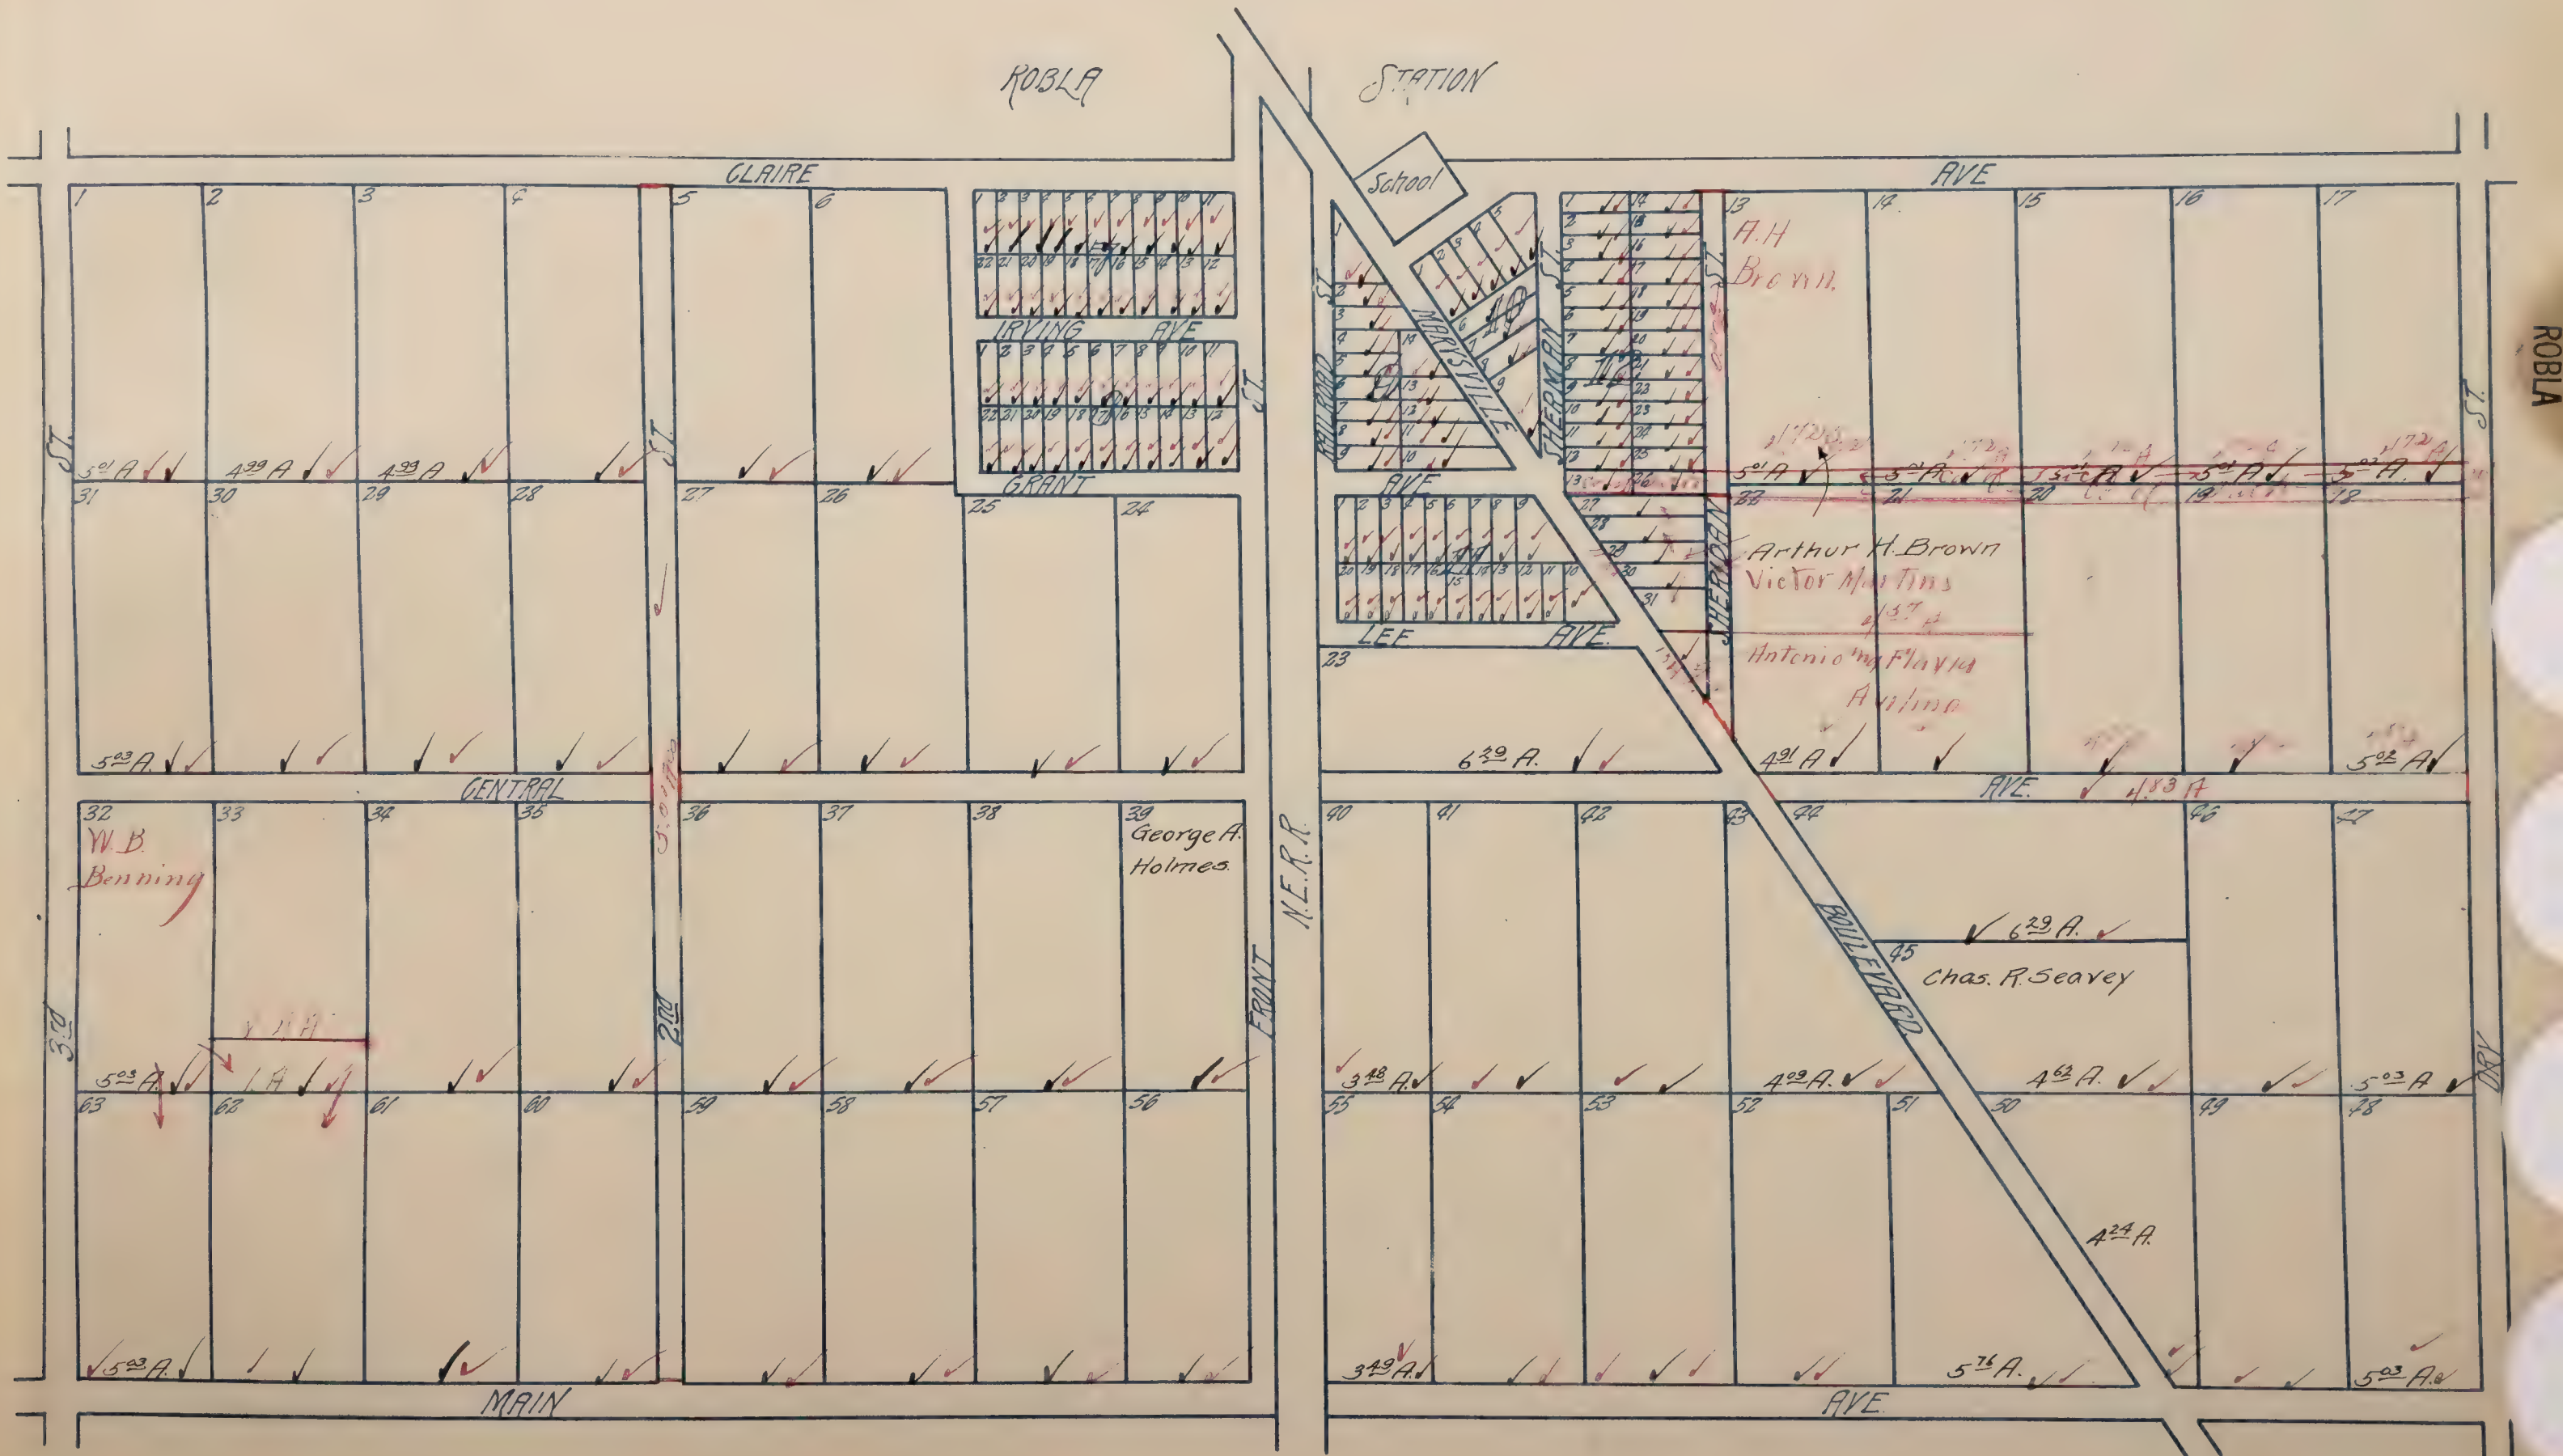

Agent

Black Ink 1910 Ownership
Red Ink 1920 Ownership

SACRAMENTO AVENUE HEIGHTS

LOCATED IN

N.E. 1/4 of Sec. 19, T.8N.R.5E.

Scale: 1"=60'

Fruit Ridge 1.10

W. & K. SUBD. No 18.

LOT 22 LOUISIANA TRACT

45	✓✓
46	Manse ✓✓
47	Manse ✓✓
48	F.H. ✓✓
49	✓✓
50	Wm. J. Andrew ✓✓
51	✓✓
52	F.W. Parker ✓✓
53	U.L. Sutliff ✓✓
54	G.A. Gostick Und 1/2 ✓ Calif. Nat'l Bank of Sac. Und 1/2 ✓
55	✓✓
56	L.C. Hunter Und 46% ✓ Calif. Nat'l Bank of Sac. Und 53% ✓
57	✓✓
58	L.C. Hunter ✓ Calif. Nat'l Bank of Sac. Und 1/2 ✓
59	✓✓

NORTH AVENUE							
11	10	9	8	7	6	5	4
L.C. Hunter Und 46% ✓ Calif. Nat'l Bank of Sac. Und 53% ✓	✓✓	✓✓	G.A. Gostick Und 1/2 ✓ Calif. Nat'l Bank of Sac. Und 1/2 ✓	L.C. Hunter Und 46% ✓ Calif. Nat'l Bank of Sac. Und 53% ✓	✓✓	✓✓	Flora Mankel ✓✓
✓✓	✓✓	✓✓	✓✓	✓✓	✓✓	✓✓	3 L.B. Hinman ✓✓

12	13	14	15	16	17	18	19	20
Shane Smith ✓✓	C.G. Corkran ✓✓ W.T. 1920 ✓✓	C.F. Florian ✓✓	Shane Smith ✓✓	J.W. Lennon ✓✓ W.T. 1920 ✓✓	L.C. Hunter ✓ Und 46% ✓ Cal. Nat'l Bank of Sac. Und 53% ✓	✓✓	A.B. Alkinson ✓ Und 46% ✓	21 Louise Morrow ✓✓
✓✓	✓✓	✓✓	✓✓	✓✓	✓✓	✓✓	✓✓	22 L.C. Hunter Und 46% ✓ Cal. Nat'l Bank of Sac. Und 53% ✓

CENTER AVENUE							
33	32	31	30	29	28	27	26
L.C. Hunter ✓ Und 46% ✓ Cal. Nat'l Bank of Sac. Und 53% ✓	✓✓	J.C. Carly ✓ Co. ✓	Albert Terhune ✓✓	✓✓	H.D. Kerr ✓ C.R. and L.E. Heale ✓	✓✓	✓✓
✓✓	✓✓	✓✓	✓✓	✓✓	✓✓	✓✓	23 A.B. Atkinson ✓✓

34	35	36	37	38	39	40	41
A.S. Hawk ✓✓	A.D. Burleson ✓✓	G.A. Gostick ✓ Und 1/2 ✓ Cal. Nat'l Bank of Sac. Und 1/2 ✓	✓✓	L.V. Sargent ✓✓	Emily B. Earle ✓✓	Sarah T. Roller ✓✓	H.D. Kerr ✓ C.R. and L.E. Heale ✓
✓✓	✓✓	✓✓	✓✓	✓✓	✓✓	✓✓	42 A. Meister & Sons ✓✓

43	44
A.C. Coleman ✓✓	✓✓
44 G.A. Gostick Und 1/2 ✓ Calif. Nat'l Bank of Sac. Und 1/2 ✓	✓✓

LAUREL AVENUE

AVENUE

Sac. Av Hgts


SACRAMENTO HEIGHTS

NE 1/4 SEC. 20 T. 8 N. R. 5 E

Scale 3 chains = 1 inch

Black Ink - 1919 Ownership
Red Ink - 1920 Ownership

*Fruit Ridge
Goldberg S. D.*

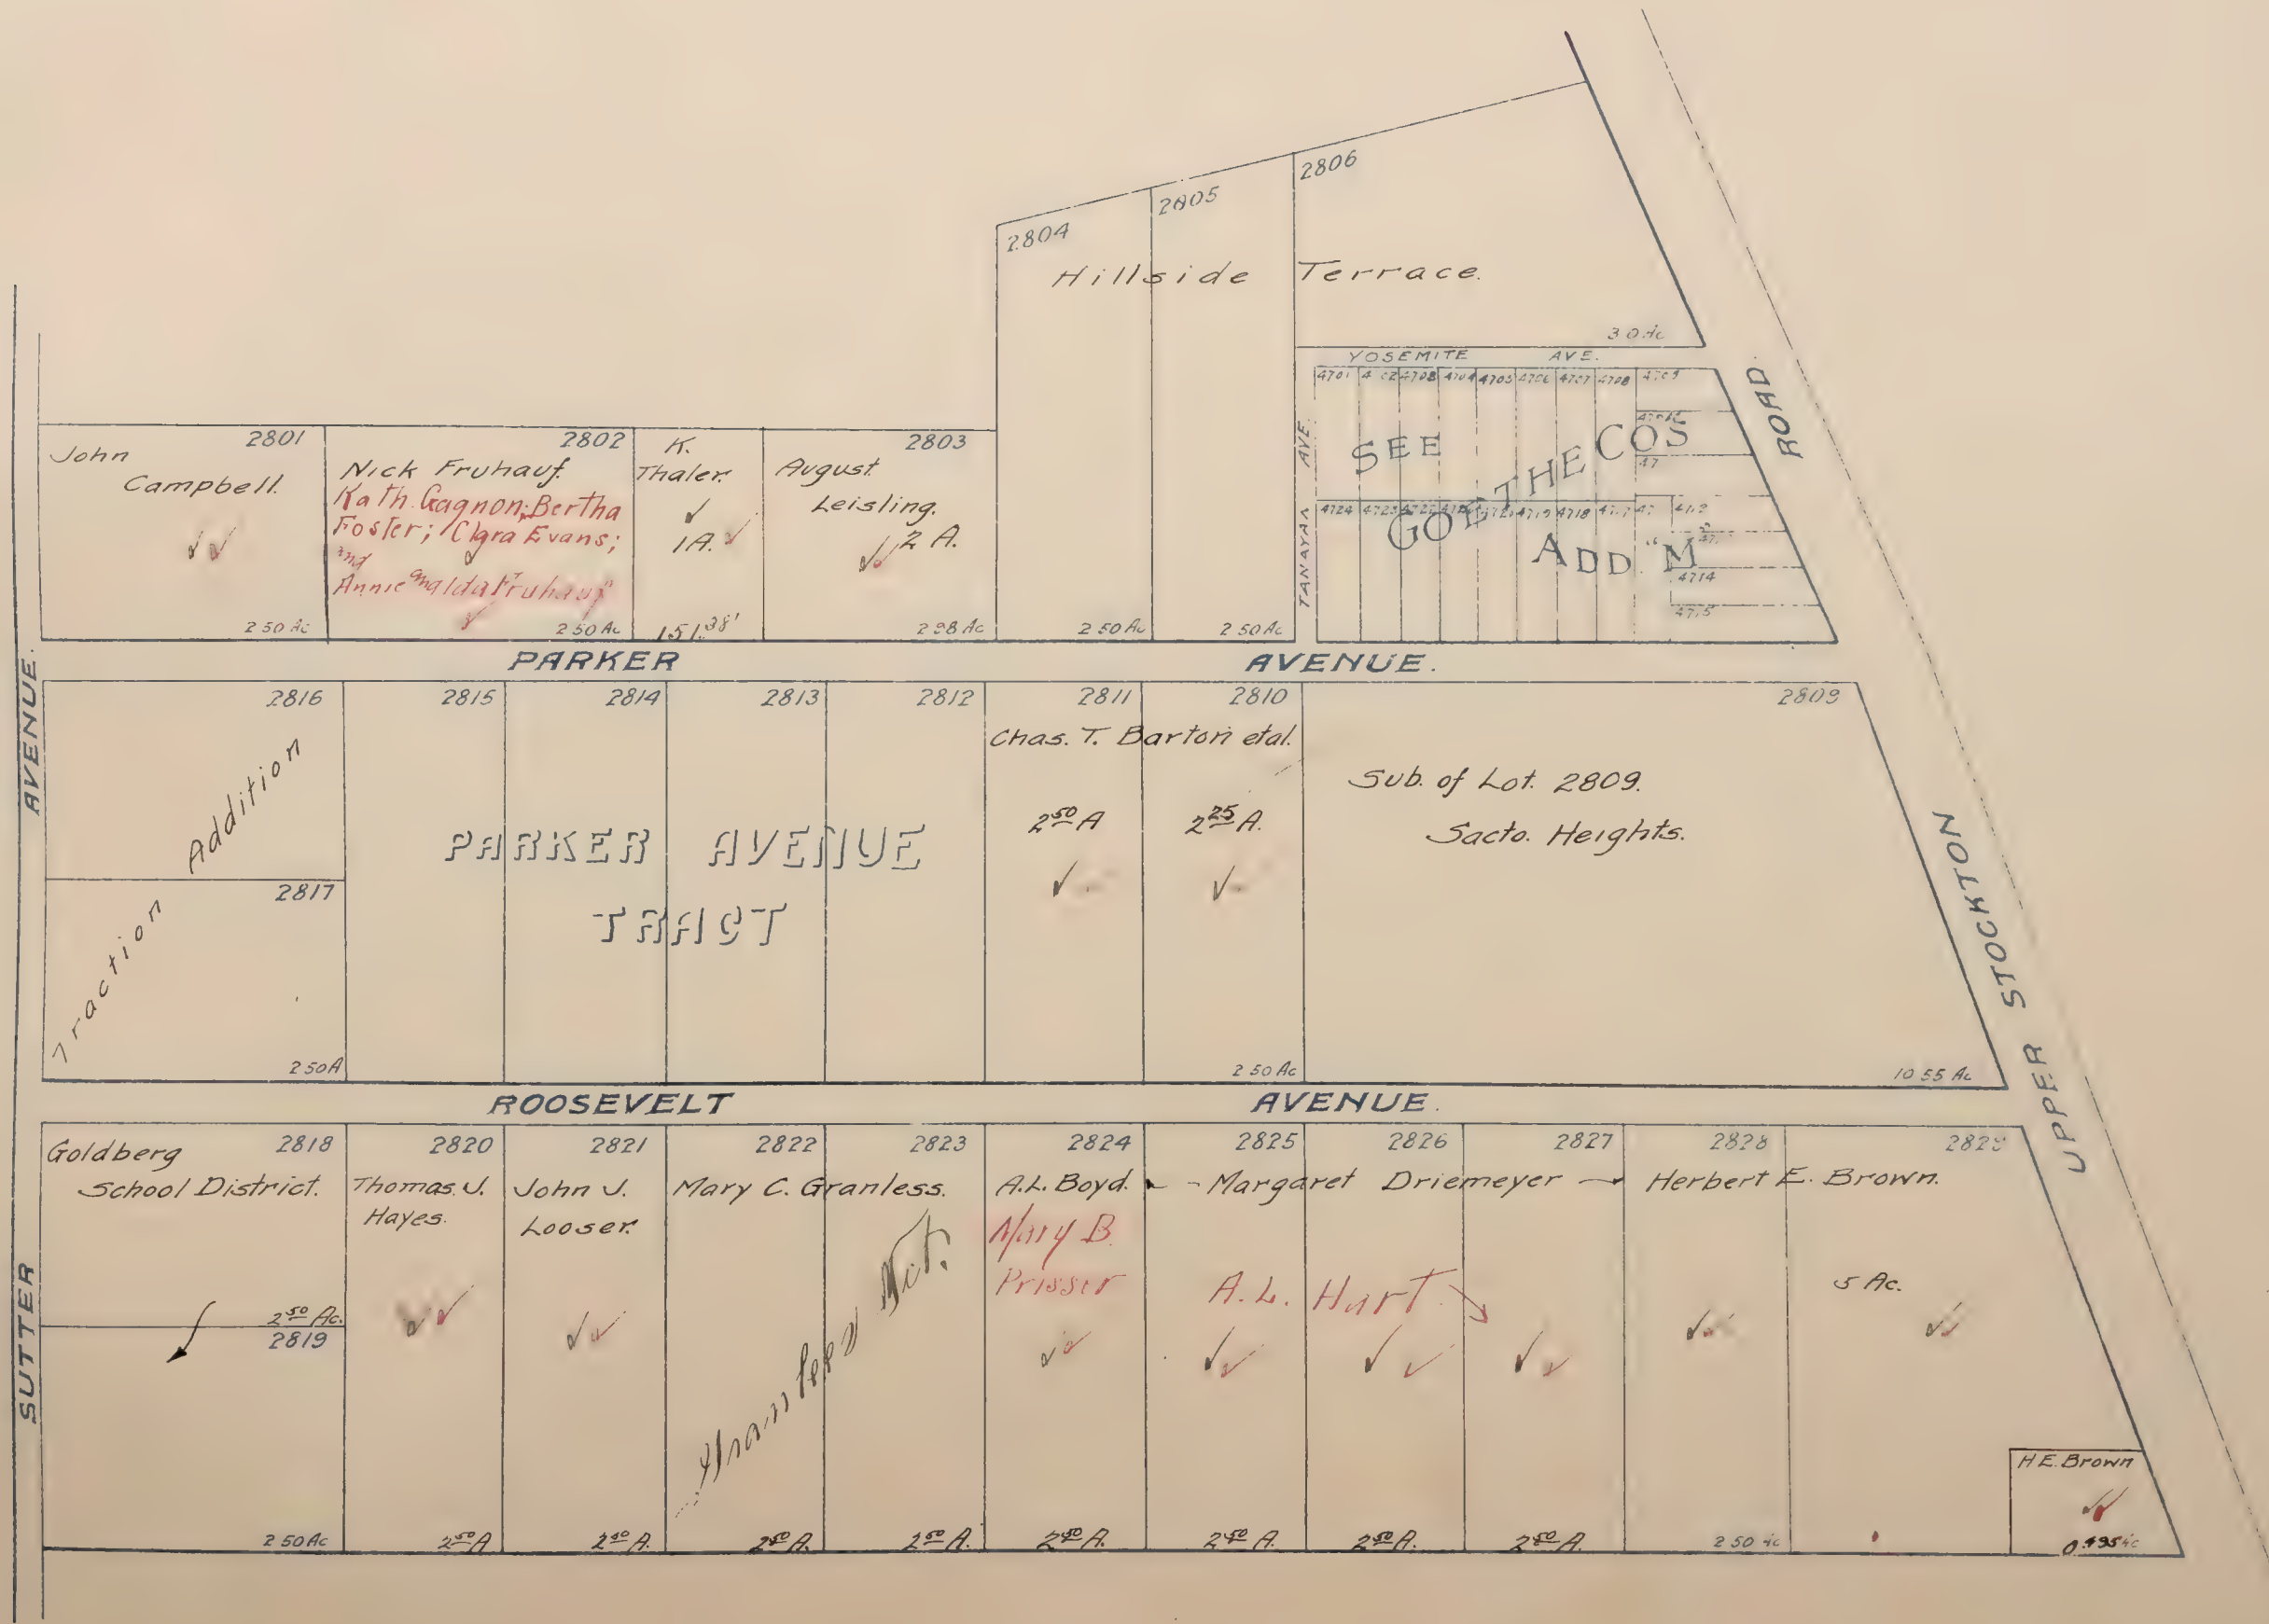


Sac. Hgts

Scale: 80' = 1"

Black Ink-1919 Ownership
Red Ink-1920 Ownership

Fruit Ridge 11.

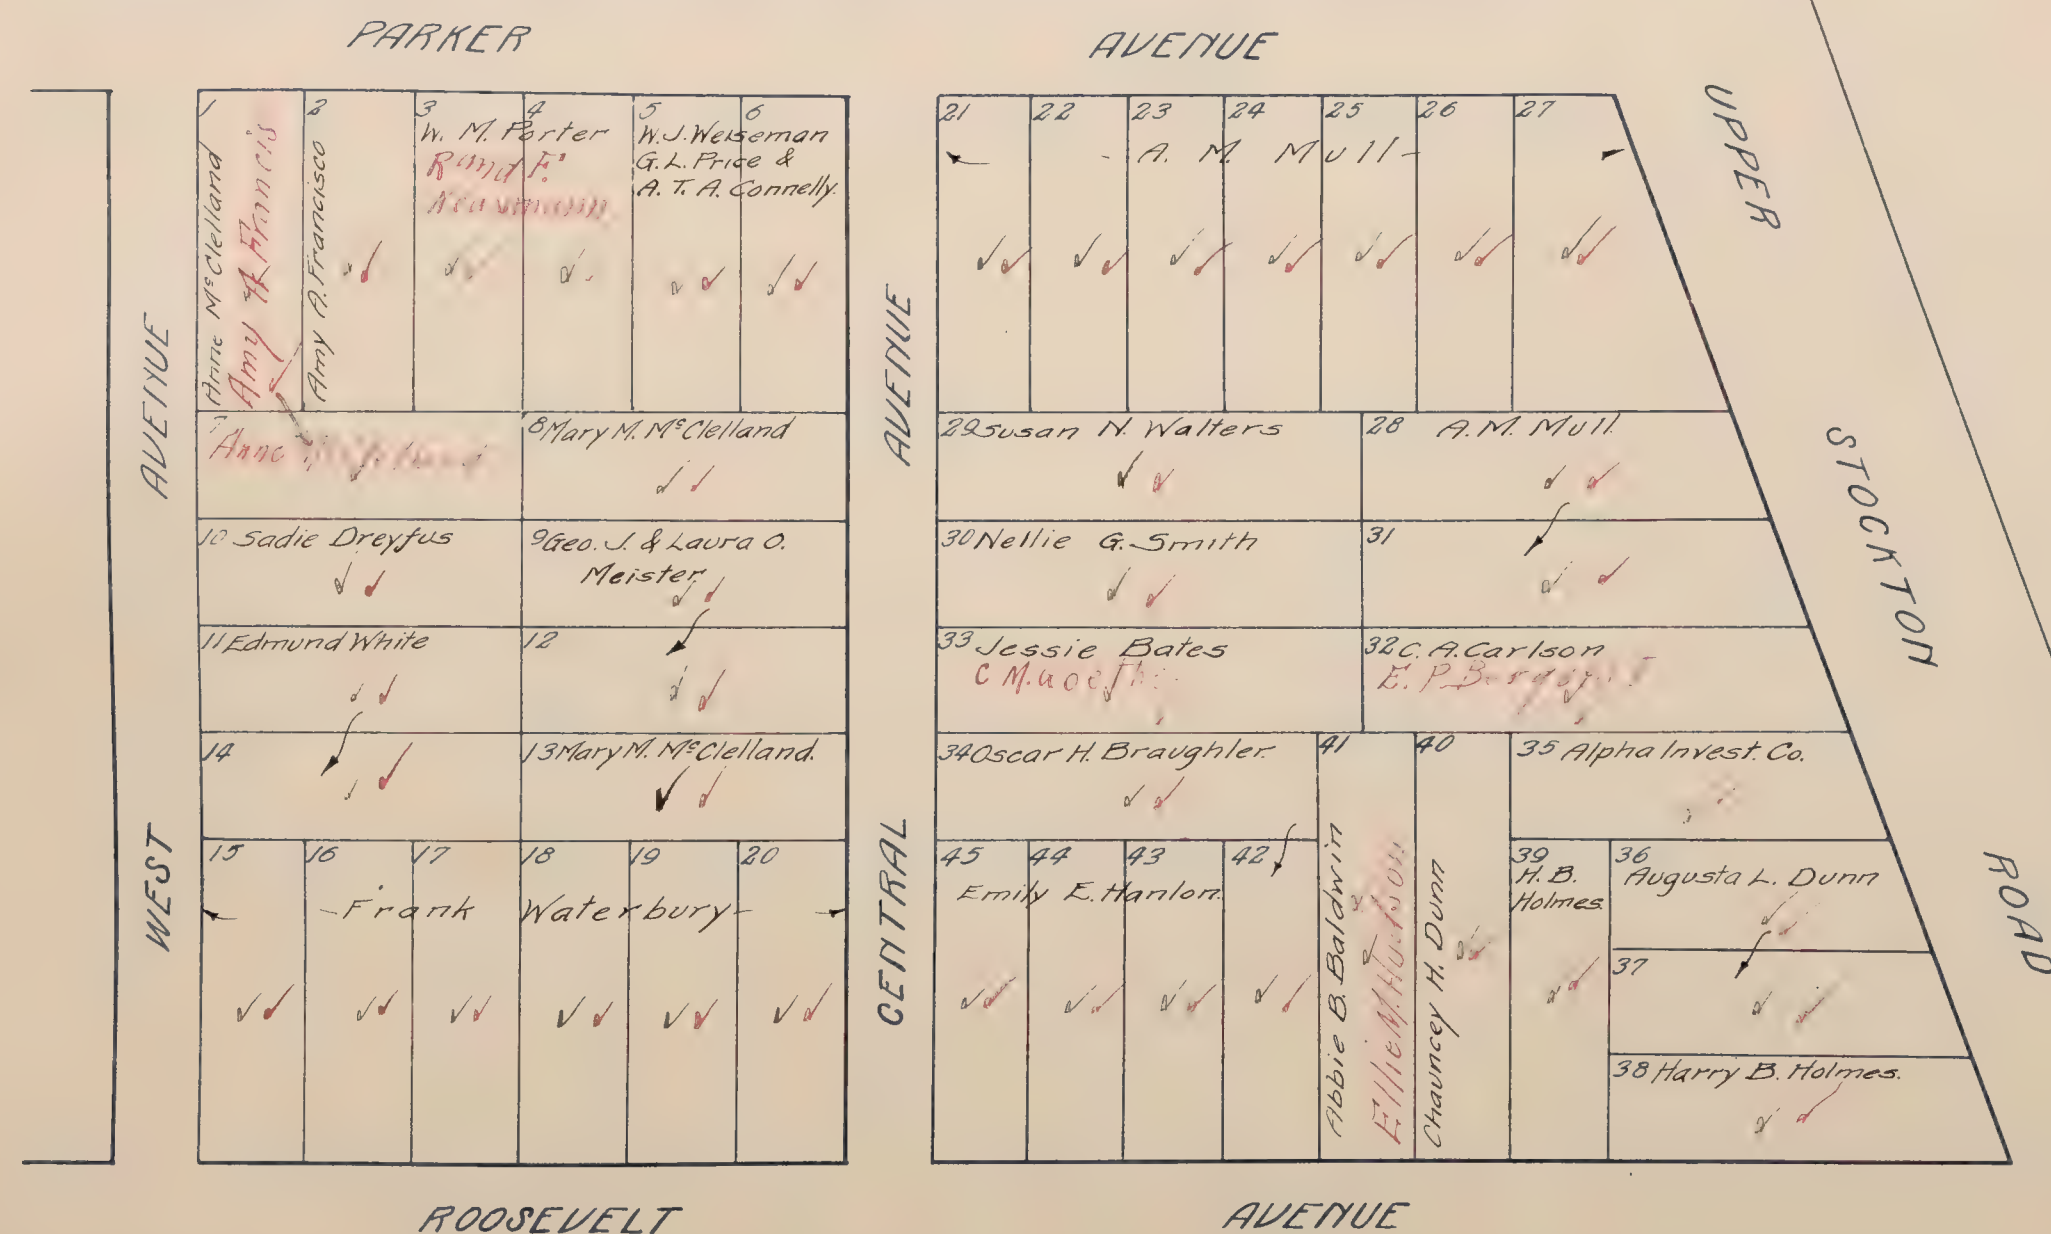

Mapped.

Black Ink-1919 Ownership
Red Ink-1920 Ownership

SACRAMENTO VALLEY IMPROVEMENT CO'S. SUBD. NO. 1

LOCATED IN AND CONSTITUTING A PART OF THE
E. 1/2 of Sec. 2, T. 5N., R. 7E.

Scale: 220' = 1"

Luganau S.D.

All Lots 2⁵⁰ Acres unless otherwise noted

1 Jarrett Charmlee <i>W.A. Brandon (orig.)</i>	2 Charmlee	3 C. Irwin Salter	4
199 A ✓	204 A ✓	205 A ✓	208 A ✓
5 H. J. Krembs	6 H. H. Born	7	8
216 A ✓	217 A ✓	218 A ✓	219 A ✓
9 Mary E. Baker	10 Vernon Baker	11 M Sacto Valley Timber & Land Co. <i>W.A. Brandenburger</i>	12
227 A ✓	228 A ✓	229 A ✓	230 A ✓
13 F. A. Harrington	14 Lawrence G. Grammer <i>Geo. J. Schenck</i>	15	16
231 A ✓	232 A ✓	233 A ✓	234 A ✓
17 E. A. Schubert	18	19	20
235 A ✓	236 A ✓	237 A ✓	238 A ✓
21 M.W. Grove	22 R.W. Collier	23	24
239 A ✓	240 A ✓	241 A ✓	242 A ✓
25 Jas. Pfleger	26 Jos. & Bertha Pfleger	27 John H. Kohl	28
243 A ✓	244 A ✓	245 A ✓	246 A ✓
29 Louisa Clausen	30	31	32
247 A ✓	248 A ✓	249 A ✓	250 A ✓
33 F. F. Wilmes	34 John W. McHenry	35	36
251 A ✓	252 A ✓	253 A ✓	254 A ✓
37 Edw. J. Zittle <i>16 Langton Land Co.</i>	38	39	40
255 A ✓	256 A ✓	257 A ✓	258 A ✓

Mapred.

SACRAMENTO VALLEY IMPROVEMENT CO'S.

SUBDIVISION NO 2.

LOCATED IN

Sec. 2, T.5N., R.7E.

Scale: 300' = 1"

Black Ink-1910 Ownership

Red Ink-1920 Ownership

Laguna S.D.

All Lots 2 Acres unless otherwise noted.

15	14	13	12	11	10	9	8	7	6	5	4	3	2	1
F. H. Schulte 10 Acres			W. A. Couch Clayton Land Co.			T. J. Kluegel				W. E. Wittig			H. H. Born	
✓	✓	✓	✓	✓	✓	✓	✓	✓	✓	✓	✓	✓	✓	✓
16	17	18	19	20	21	22	23	24	25	26	27	28	29	30
			W. Blumel & Louise Ruh	L. W. Borg- stede	C. H. Whitfield	E. H. Goetsch Clayton Land Co.	Andrew T. Dauthett	L. W. Borgstede		F. W. Leim- kuehler	Mrs. A. C. Leim- kuehler	F. W. Leim- kuehler		
✓	✓	✓	✓	✓	✓	✓	✓	✓	✓	✓	✓	✓	✓	✓
35	34	33	32	31	30	29	28	27	26	25	24	23	22	21
Louisa Ruh	Nicholas Lerch	F. Kamp- Schmidt	Lillie C. & Jno. E. Dwyer	Wm. Hohlt	M. R. Chartrand Clayton Land Co.	Louise Tott	Thos. T. Edwards	A. Edwards		Martha B. Porter	Title Insurance & Trust Co.			
✓	✓	✓	✓	✓	✓	✓	✓	✓	✓	✓	✓	✓	✓	✓
46	45	44	43	42	41	40	39	38	37	36	35	34	33	32
47	48	49	50	51	52	53	54	55	56	57	58	59	60	61
Paula & Alice F. Muench	W. H. Rowland	Albert C. Goetsch Clayton Land Co.	Geo. Schwartz	C. F. Fickey	Stella C. Dewart Clayton Land Co.	Louis & Lena Lindley			E. B. Fogg	H. T. Schulte	Frank Rodgers	Luther W. Flint W. A. Brandenburg		
✓	✓	✓	✓	✓	✓	✓	✓	✓	✓	✓	✓	✓	✓	✓
75	74	73	72	71	70	69	68	67	66	65	64	63	62	61
Sophia Billenkamp	E. C. Mettgart Clayton Land Co.	Jno. Bell									Clayton Land Co. W. A. Brandenburg	L. W. Robinson	L. F. Lange Worthy	
✓	✓	✓	✓	✓	✓	✓	✓	✓	✓	✓	✓	✓	✓	✓
76	77	78	79	80	81	82	83	84	85	86	87	88	89	90
A. H. Schulte			Clayton Land Co. Christian Timbuck	S. M. Green Clayton Land Co.		John R. Harlow		F. W. Bergman		J. M. Hampson Clayton Land Co.	Geo. L. Cook	W. H. Glassey		Wm. Jaeger
✓	✓	✓	✓	✓	✓	✓	✓	✓	✓	✓	✓	✓	✓	✓
105	104	103	102	101	100	99	98	97	96	95	94	93	92	91
Francis M. Hilby	Jas. Bishop Clayton Land Co.	Franklin H. Dewart	A. B. Conrad	S. M. Green	Clayton Land Co.	Jno. Sorentz		Dora Clausen Clayton Land Co.		J. H. Aldinger Clayton Land Co.	Adolphus Bowler Jr.	L. W. Flint	Gustav Clair Clayton Land Co.	
✓	✓	✓	✓	✓	✓	✓	✓	✓	✓	✓	✓	✓	✓	✓

Mapped.

Black Ink-1919 Ownership
Red Ink-1913 Ownership

SACRAMENTO VALLEY IMPROVEMENT CO'S.

SUBDIVISION No 2.


LOCATED IN

Sec. 2, T.5N., R.7E.

Scale: 300' = 1"

All Lots 2 A. unless otherwise marked

Laguna S.D.

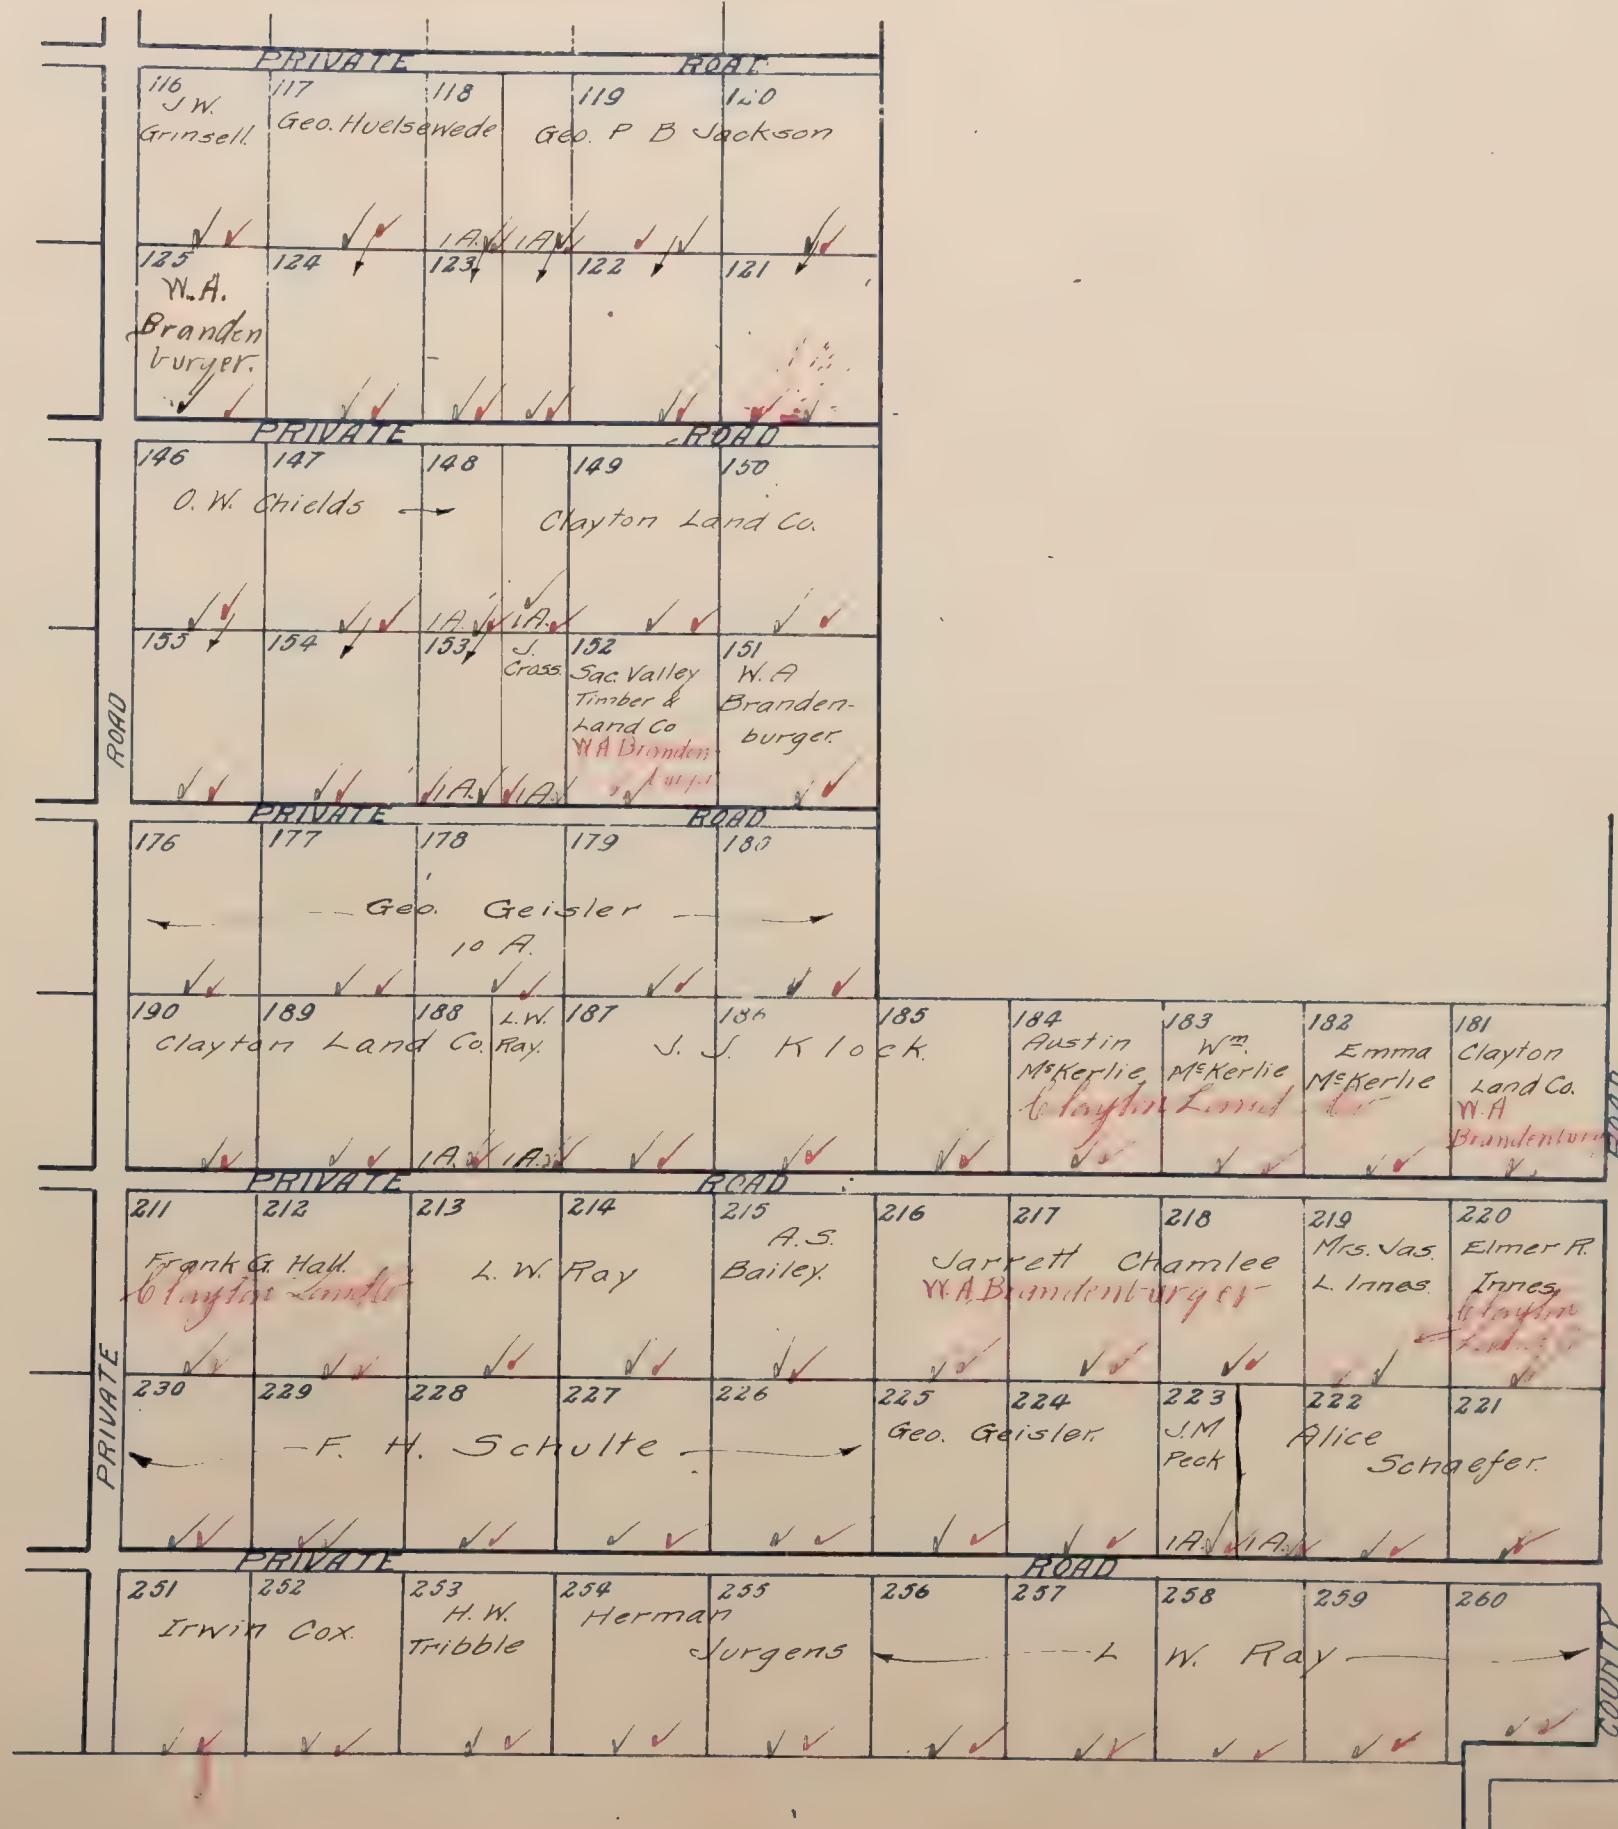

SACRAMENTO VALLEY IMPROVEMENT CO'S.

SUBDIVISION NO 3.

BEING THE
E. 1/2 of Sec. 36, T. 6 N., R. 7 E.

Scale: 6chs.=1"

Black Ink-1919 Ownership
Red Ink-1919 Ownership

CLAY

Amador Branch RR

Blanks to Clayton Land Co.
All lots 2 Acres unless otherwise noted

Laguna S.D.

COUNTY					ROAD				
10	9	8	7	6	5 Eliz. Heintze	4 F.E. Odeno	3 Roy K & Floy F Seltzer	2 Chas E. Lett	1 Sac. Valley Timber & Land Co.
11	12	13	14	15	16 Geo S Foot	17 F.W. Beinke	18 J.C. Busack	19	20
30	29	28	27	26	25 J.L. Straley	24 J.W. Baeppler	23 Mike O'Hagan	22 S.E. McDowell	21 Geo B. Corner
31	32	33	34	35	36 Emil Immenhausen	37 J.L. Straley	38 C.I. McKenzie	39 Theresa Koch	40 Geo. A. Koch
50	49	48	47	46	45 C.W. Cook	44	43 J. Eber	42 J.E. Tuesdale	41
51	52	53	54	55	56 Millie L. Morley	57	58 R.J. Gurvine	59	60
70	69	68	67	66	65 L. Gregor	64 W.T. Myers	63 Rosie P. Gordon	62	61
71 Alice M. MacDonald	72	73 W.J. MacDonald	74	75	76 Albert Ottenbacher	77 T.H. Bransford	78 Henry R. Brauer	79 W.A. Brander	80
90 Henry K. Merrit	89 Bayard Boyle	88 Adam Fox	87 D.C. Hanna	86 C.H. Dodge	85 Geo. W. & C.H. Dodge	84 Julius Hornitz	83 A.W. & F.M. Armbruster	82	81
91 Millie L. Morley	92	93 Jno. Alexander	94 L.S. Roberts	95	96 R.E. Dimmonds Jr.	97	98	99	100
110 Lillie Meyer	109 Sac. Valley Timber & Land Co.	108 A.C. Thomas	107 G.W. Donnard	106 Chas. H. Fahnestock	105 A.H. Knight	104 Geo. D. Kluegel	103 T.J. Haywood	102	101
111 J.E. Bole	112 W.A. Brander	113 Alexander Bianchi	114	115	116	117 Mrs. Jno. C. Burris	118 J. H. Higinbotham	119	120
130 F.A. Mercer	129 W.H. Gibbs	128 R.W. Steechy	127 Julian W. Steechy	126	125 W.A. Johnson	124 K. & G. Watters	123 Wm. Exner	122	121
131 Sac. Valley Timber & Land Co.	132	133 Sac. Val. Tim. & Land Co.	134 Walter Bamber	135	136 Harry E. Schroek	137 Samuel Nooney	138 M.G. Smith	139 L.J. & A.J. Harvey	140 E.H. Broadwell
150 W.S. Shepherd	149 R.D. Blaine	148	147	146	145 G.E. Harwood	144 J.A. Hewitt	143 A.L. Dergigne	142 J.E. Corcoran	141 R.H. Griffith
151 Sac. Val. Tim. & Land Co.	152	153 Thos. Conner	154	155	156	157	158 J. Hallen	159 J. Sadick	160

Mapped.

SACRAMENTO VALLEY IMPROVEMENT CO'S. SUBD. No 4

LOCATED IN THE
W. 1/2 of Sec. 6, T. 5N., R. 8E.

Scale: 6 Chs = 1"

Black Ink - 1919 Ownership
Red Ink - 1920 Ownership

All Lots & Acres unless otherwise noted.

Blanks to Clayton Land Co. ✓

PUBLIC		ROAD		PUBLIC		ROAD		PUBLIC	
9 H. P. Moore	8 R. W. Barrell	7 Eliz. A. Barrell	6 W. H. Buaschen	5 W. Wegener	4 W. T. Stroup	3 W. T. Stroup	2 C. A. Tuttle	1	
23 A ✓	✓	✓	✓	✓	✓	✓	✓	✓	✓
10 D. F. Russell	11	12	13 Godfrey Kettler	14 B. F. Parmelee	15	16 Sac. Val. Timber & Land Co.	17 C. Schuermann	18 Catherine H. Rush	
23 A ✓	✓	✓	✓	✓	✓	✓	✓	✓	✓
27	26 Richard Eddy	25 Sac. Val. Tim. & Land Co.	24 Geo. C. Henry	23 C. J. Bay	22	21 Loverine Looman	20 H. M. Thomas	19	
23 A ✓	✓	✓	✓	✓	✓	✓	✓	✓	✓
28 F. W. Schulte	29 A. A. Chaine	30 J. T. Belk	31 Fred W. & Clarence Thuston	32	33	34 Hans Fehr	35 J. E. Troutman	36 Fred H. Armbruster	
23 A ✓	✓	✓	✓	✓	✓	✓	✓	✓	✓
45 Aug. W. Dohn	44	43	42 E. Lee Renno	41 Jno. Russell	40	39	38	37	
23 A ✓	✓	✓	✓	✓	✓	✓	✓	✓	✓
46 Frank W. Brown	47	48 Ferd. Facal	49 J. H. Niemeyer	50 H. A. Conyne	51 Ida Kessler	52 L. A. Koernig	53 W. T. Hendrick	54 E. H. Lindig	
23 A ✓	✓	✓	✓	✓	✓	✓	✓	✓	✓
63 A. B. Eckles	62 Minnie S. Miller & Jennie S. Day	61 W. M. Durlap	60 G. J. Groassin	59 Geo. J. Raithel	58	57 Benj. Koernig	56 M. Kauffman	55	
23 A ✓	✓	✓	✓	✓	✓	✓	✓	✓	✓
64	65	66	67	68	69	70	71	72	
23 A ✓	✓	✓	✓	✓	✓	✓	✓	✓	✓
81	80	79	78 H. F. Meyerhart	77 M. R. Cassin	76	75	74	73	
23 A ✓	✓	✓	✓	✓	✓	✓	✓	✓	✓
82	83	84	85	86	87	88	89	90	
23 A ✓	✓	✓	✓	✓	✓	✓	✓	✓	✓
99	98	97	96	95	94	93	92	91	
23 A ✓	✓	✓	✓	✓	✓	✓	✓	✓	✓
100	101	102	103	104	105	106	107	108	
23 A ✓	✓	✓	✓	✓	✓	✓	✓	✓	✓
117	116	115	114	113	112	111	110	109	
23 A ✓	✓	✓	✓	✓	✓	✓	✓	✓	✓
118	119	120	121	122	123	124	125	126	
23 A ✓	✓	✓	✓	✓	✓	✓	✓	✓	✓
135	134	133	132	131	130	129	128	127	
23 A ✓	✓	✓	✓	✓	✓	✓	✓	✓	✓

W. A. Brandenburger

W. A. Brandenburger

W. A. Brandenburger

W. A. Brandenburger

Mapped


Black Ink-1919 Ownership
Red Ink-1927 Ownership

SAC'TO VALLEY IMP. CO'S SUBDN. NO. 6

LOCATED IN
W 1/2 of Sec. 36 T.6N.R.7E.
Scale: 6 chs.=1"

Laguna S.D.

All Lots 2 Acres unless otherwise noted

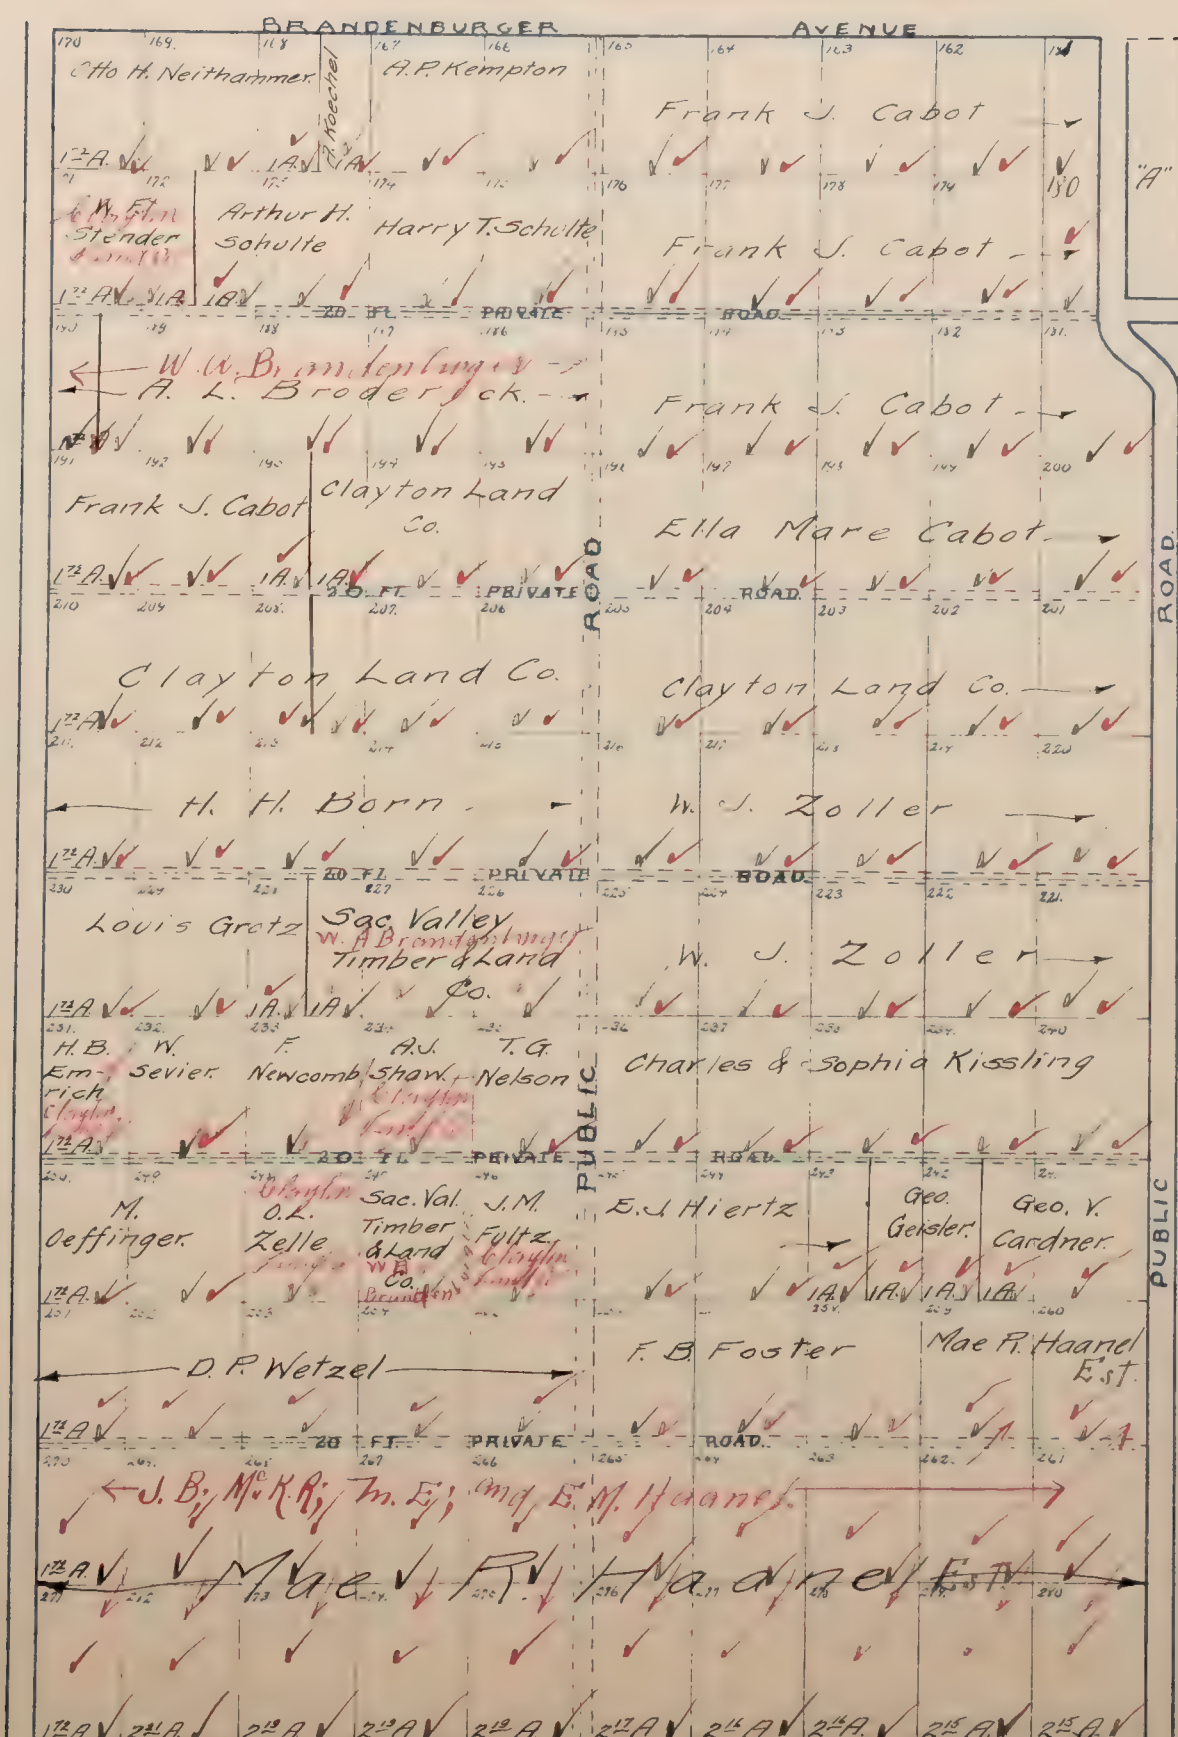

SACRAMENTO VALLEY IMPROVEMENT CO'S

SUBDIVISION NO. 7

Black Ink-1919 Ownership

located in the

Red Ink-1920 Ownership

E 1/2 of Sec. 6 T5N R8E

Laguna S.D.

Scale 1" = 60 chs

Blanks to W.A. Brandenburger / Sacramento Valley Timber & Land Co.

Note: All Lots 2 Acres unless otherwise noted

142 Susie Whitney	143	144	145	146	147	148	149	150
✓ 5 A. ✓	✓	✓	✓	✓	✓	✓	✓	✓
145	146	147	148	149	150	151	152	153
✓	✓	✓	✓	✓	✓	✓	✓	✓
A. W. Futherford				Clayton Land Co.		G. Campbell		
146	147	148	149	150	151	152	153	154
✓	✓	✓	✓	✓	✓	✓	✓	✓
T. G. Northwall		V. A. Johnson		W. W. Brandenburger				
147	148	149	150	151	152	153	154	155
✓	✓	✓	✓	✓	✓	✓	✓	✓
W. A. Brandenburger				Alfred Schmitz				
148	149	150	151	152	153	154	155	156
✓	✓	✓	✓	✓	✓	✓	✓	✓
149	150	151	152	153	154	155	156	157
✓	✓	✓	✓	✓	✓	✓	✓	✓
Ethel Reyes				Walter Hawkes		J. F. Bame		
150	151	152	153	154	155	156	157	158
✓	✓	✓	✓	✓	✓	✓	✓	✓
151	152	153	154	155	156	157	158	159
✓	✓	✓	✓	✓	✓	✓	✓	✓
H. P. Wells								
152	153	154	155	156	157	158	159	160
✓	✓	✓	✓	✓	✓	✓	✓	✓
N. J. Clarke								
153	154	155	156	157	158	159	160	161
✓	✓	✓	✓	✓	✓	✓	✓	✓
Jessie E. Verdier								
154	155	156	157	158	159	160	161	162
✓	✓	✓	✓	✓	✓	✓	✓	✓
Minnie Moss				E. L. Smith		A. G. Barker		M. S. Radigan
155	156	157	158	159	160	161	162	163
✓	✓	✓	✓	✓	✓	✓	✓	✓
A. E. Rankin				A. I. Lynch				
156	157	158	159	160	161	162	163	164
✓	✓	✓	✓	✓	✓	✓	✓	✓
W. J. A. Rankin				F. L. Atkins		H. A. Gatz		Chas. Clerc
157	158	159	160	161	162	163	164	165
✓	✓	✓	✓	✓	✓	✓	✓	✓
C. B. Atherton				F. F. Reynolds		Linda Taylor		
158	159	160	161	162	163	164	165	166
✓	✓	✓	✓	✓	✓	✓	✓	✓
Clayton Land Co.		Ferdinand Scheuch		L. M. Alexander		H. Mingo		W. S. Ross
159	160	161	162	163	164	165	166	167
✓	✓	✓	✓	✓	✓	✓	✓	✓
William S. Ross								
160	161	162	163	164	165	166	167	168
✓	✓	✓	✓	✓	✓	✓	✓	✓
N. E. Blanchard		J. G. Rosomme		Larve Seibert				
161	162	163	164	165	166	167	168	169
✓	✓	✓	✓	✓	✓	✓	✓	✓

Black Ink-1919 Ownership
Red Ink-1939 Ownership

SACRAMENTO VALLEY IMPROVEMENT CO'S
SUBDIVISION NO.8

being the
W. 1/2 Sec 31 T6N. R8E.

Scale: 1" = 8 chs.

Blanks to Sacramento Valley Timber & Land Co.
All Lots 2 Acres unless otherwise noted.

Laguna S.D.

10	9	8	7	6	5	4	3	2	1
Perley K. Myke	Myke	H. Bradford			Anna M.		Julia E. Clarke		
✓	✓	✓	✓	✓	✓	✓	✓	✓	✓
11	12	13	14	15	16	17	18	19	20
✓	✓	✓	✓	✓	✓	✓	✓	✓	✓
21	22	23	24	25	26	27	28	29	30
✓	✓	✓	✓	✓	✓	✓	✓	✓	✓
31	32	33	34	35	36	37	38	39	40
✓	✓	✓	✓	✓	✓	✓	✓	✓	✓
41	42	43	44	45	46	47	48	49	50
✓	✓	✓	✓	✓	✓	✓	✓	✓	✓
51	52	53	54	55	56	57	58	59	60
✓	✓	✓	✓	✓	✓	✓	✓	✓	✓
61	62	63	64	65	66	67	68	69	70
✓	✓	✓	✓	✓	✓	✓	✓	✓	✓
71	72	73	74	75	76	77	78	79	80
✓	✓	✓	✓	✓	✓	✓	✓	✓	✓
81	82	83	84	85	86	87	88	89	90
✓	✓	✓	✓	✓	✓	✓	✓	✓	✓
91	92	93	94	95	96	97	98	99	100
✓	✓	✓	✓	✓	✓	✓	✓	✓	✓
101	102	103	104	105	106	107	108	109	110
✓	✓	✓	✓	✓	✓	✓	✓	✓	✓
111	112	113	114	115	116	117	118	119	120
✓	✓	✓	✓	✓	✓	✓	✓	✓	✓
121	122	123	124	125	126	127	128	129	130
✓	✓	✓	✓	✓	✓	✓	✓	✓	✓
131	132	133	134	135	136	137	138	139	140
✓	✓	✓	✓	✓	✓	✓	✓	✓	✓
141	142	143	144	145	146	147	148	149	150
✓	✓	✓	✓	✓	✓	✓	✓	✓	✓
151	152	153	154	155	156	157	158	159	160
✓	✓	✓	✓	✓	✓	✓	✓	✓	✓

PH my PG
H. H. M. M. M.
W. A. B. M. M. M.

Red Ink-1920 Ownership

SUBDIVISION NO.9

being

Section 1. T5N.R7E.

Scale: 1"=8chs.

Laguna S.D.

All Lots 2 Acres unless otherwise noted

Blanks to Clayton Land Co.

1 Mary T. Baker	2 H. J. Mamman	3 J. H. Momar	4 S. M. Dickens	5 C. J. Bay	6 Frank A. Allhoff	7 C. J. Bay	8 C. J. Nicholls	9 L. Woods	10 W. C. Knost
11 James E. Baker	12 O. Voight Mer Co.	13 W. W. Kenaming	14 E. Maud Wilson	15 J. W. Wilson	16 Edw. Taylor	17 J. Russell	18 Jno A. & Helene Brandenburger	19 J. B. Ruth	20 E. Faragher
21 Jos. H. Foy	22 F. W. & Sophia Sackse	23 O. L. Maxwell	24 C. J. Bay	25 Margt. G. & G. Heid	26 W. F. Brandenburger	27 J. A. Wols-lare	28 J. A. Wols-lare	29 W. A. Brandenburger	30 S. A. Val. T. & L. Co.
31 W. A. Brandenburger	32 C. C. Dellitt	33 O. L. Blankenship	34 W. F. Morge-nau	35 Austin H. Cole	36 F. C. Weise	37 J. A. Wols-lare	38 J. A. Wols-lare	39 D. L. Hower	40 E. Dickey
41 F. M. Nuffer	42 Arthur W. Cobb	43 Emil Immen	44 Chas. Mac Gregor	45 E. E. Price	46 Julia E. Lincoln	47 J. R. Lee	48 C. L. McFar-lane	49 R. E. Bough-ton	50 R. L. Mayer
51 W. A. Brandenburger	52 A. L. Broderick	53 David Ro-tian	54 W. W. Mc-Nic-Hie	55 S. H. G. E. Faupel Nelson	56 J. H. McFarlane	57 C. H. Williams	58 Mrs. L. B. Haug	59 F. L. Kingsley	60 G. P. Rogers
61 A. D. Chapman	62 Emily Boyse	63 Florence Council Nesbit	64 Mabel & Eliz. Rippey	65 Emma L. Milbray	66 J. H. McFarlane	67 C. H. Williams	68 Mrs. L. B. Haug	69 F. L. Kingsley	70 G. P. Rogers
71 C. W. Hughes	72 Chas. E. Fuhlman	73 H. C. Phelps	74 Florence Kellett	75 S. A. Val. T. & L. Co.	76 Jas. A. Mears	77 Guy F. Carpenter	78 L. E. P. Mover	79 Alfred Paynter	80 Geo. Geisler
81 Jas. P. Joyce	82 H. L. Hall	83 E. L. Heintze	84 Sophia Schmidt	85 Thos. R. Gross	86 G. W. Pfeiffer	87 W. F. Hook	88 M. A. Dennis	89 S. A. Val. T. & L. Co.	90 J. J. Schrick
91 A. Menigott	92 J. R. Hanlon	93 Geo. Geisler	94 Lillie R. Ernest	95 C. A. & Mae E. Apper-son	96 E. Z. Leibrock	97 S. A. Val. T. & L. Co.	98 J. J. Schrick	99 I. Bruem-mer	100 A. E. O'Hara
101 M. G. Aagaard	102 L. A. Holmes	103 D. S. Little	104 Mary A. Fleming	105 S. R. H. H. Edale	106 M. W. Skurvels	107 J. H. Sackse	108 J. H. Freeman	109 B. J. Peter-son	110 W. Holz
111 F. A. Becker	112 J. J. King	113 Jay King	114 F. R. Becker	115 R. J. D. Hoover	116 H. H. Schulte	117 H. T. Schulte	118 Will Wright	119 Marie H. Perlog	120 O. C. Barrie
121 R. B. Braman	122 Eva W. Pott-hoff	123 Walter P. Brooks	124 Chas. E. Manby	125 Edw. J. Zittle	126 J. H. & Cath. Heller	127 W. L. Spang-ler	128 W. B. Holmes	129 Z. F. Lotnes	130 J. F. Lotnes
131 John W. Emery	132 W. A. Brandenburger	133 J. D. J. D.	134 Josephine Haber-strab	135 L. W. Paulsolt	136 G. F. Bellan-ey	137 S. A. Val. T. & L. Co.	138 Sam'l Rife	139 W. A. Brandenburger	140 W. A. Brandenburger

Sac. V. Im. Co. 9

Black Ink-1919 Ownership
Red Ink-1920 Ownership

SACRAMENTO VALLEY IMPROVEMENT CO'S

SUBDIVISION N^o 11.

LOCATED IN

S. $\frac{1}{2}$ of SEC. 11, T. 5 N. R., 7 E

Scale: 400' = 1"

W. A. Brandenburger ✓
Blanks to Sacto. Valley Timber & Land Co. ✓
PUBLIC ROAD

PUBLIC		PUBLIC		PUBLIC		PUBLIC		PUBLIC		PUBLIC		PUBLIC		PUBLIC	
1 Charles H. Norris	2 R. B. Parrish	J.B. Hatch 1 1/2 A ✓ L.K. Behrens 1 1/2 A ✓	3 Richard J. Scales.	Norman H. Laughlin	4	5 Leo M. Bryson	Alvin K. Meyers	6 Wm Pennis	7 W.C. Van Loon		8 H.C. Tice	C.E.A. 1 1/2 A			
10 1/2 A ✓	5 1/2 A ✓	2 1/2 A ✓	10 1/2 A ✓	✓	10 1/2 A ✓	5 1/2 A ✓	5 1/2 A ✓	5 1/2 A ✓	5 1/2 A ✓	5 1/2 A ✓	5 1/2 A ✓	5 1/2 A ✓	5 1/2 A ✓	5 1/2 A ✓	5 1/2 A ✓
16 C.G. Mendenhall	H.C. Davidson	C.P. Beale	E.M. Replogle	A.M. Spring 2 1/2 A ✓	Anna M. Spring	Guy A. Bryant	Guar.	Wm A. Christen Son	H. Brimey- er	Jno. Schaefer 1 1/2 A ✓					
5A ✓	5A ✓	10A ✓	10A ✓	8A ✓	5A ✓	5A ✓	5A ✓	5A ✓	5A ✓	5A ✓	5A ✓	5A ✓	5A ✓	5A ✓	5A ✓
17 Thos. W. Fenton	Clarence A. Merritt.	18	19 Wm Fischer	Felix P. Farrow	Jos. M. Locke	21 A. C. Cook	Nathaniel Waring Barnes	22 Christopher Stanton	23 P.A. Populorum	24 Jock Van Hout James Van Hout 2 1/2 A ✓	V.H.H. Finck 3 1/2 A ✓				
5A ✓	5A ✓	10A ✓	5A ✓	5A ✓	5A ✓	5A ✓	5A ✓	10A ✓	10A ✓	6 1/2 A ✓	6 1/2 A ✓				
32 H.M. Gragg	Leroy D Innis	31 Edw. H. Tilling head	30 Stephen L. Tabor	Jas W. Barnes.	29	28 Albert Sevenson	E.T. Erb.	27 H.L. Kinsley.	26 Mr. V.F. Kennedy						
5A ✓	5A ✓	10A ✓	5A ✓	5A ✓	10A ✓	5A ✓	5A ✓	10A ✓	10A ✓	6 1/2 A ✓	6 1/2 A ✓				

SACRAMENTO VALLEY IMPROVEMENT CO'S.

SUBDIVISION N°12.


LOCATED IN

Sec. 11 & 12. T. 5 N., R. 7 E.

Scale: 500' = 1"

Black Ink-1919 Ownership

Red Ink-1920 Ownership

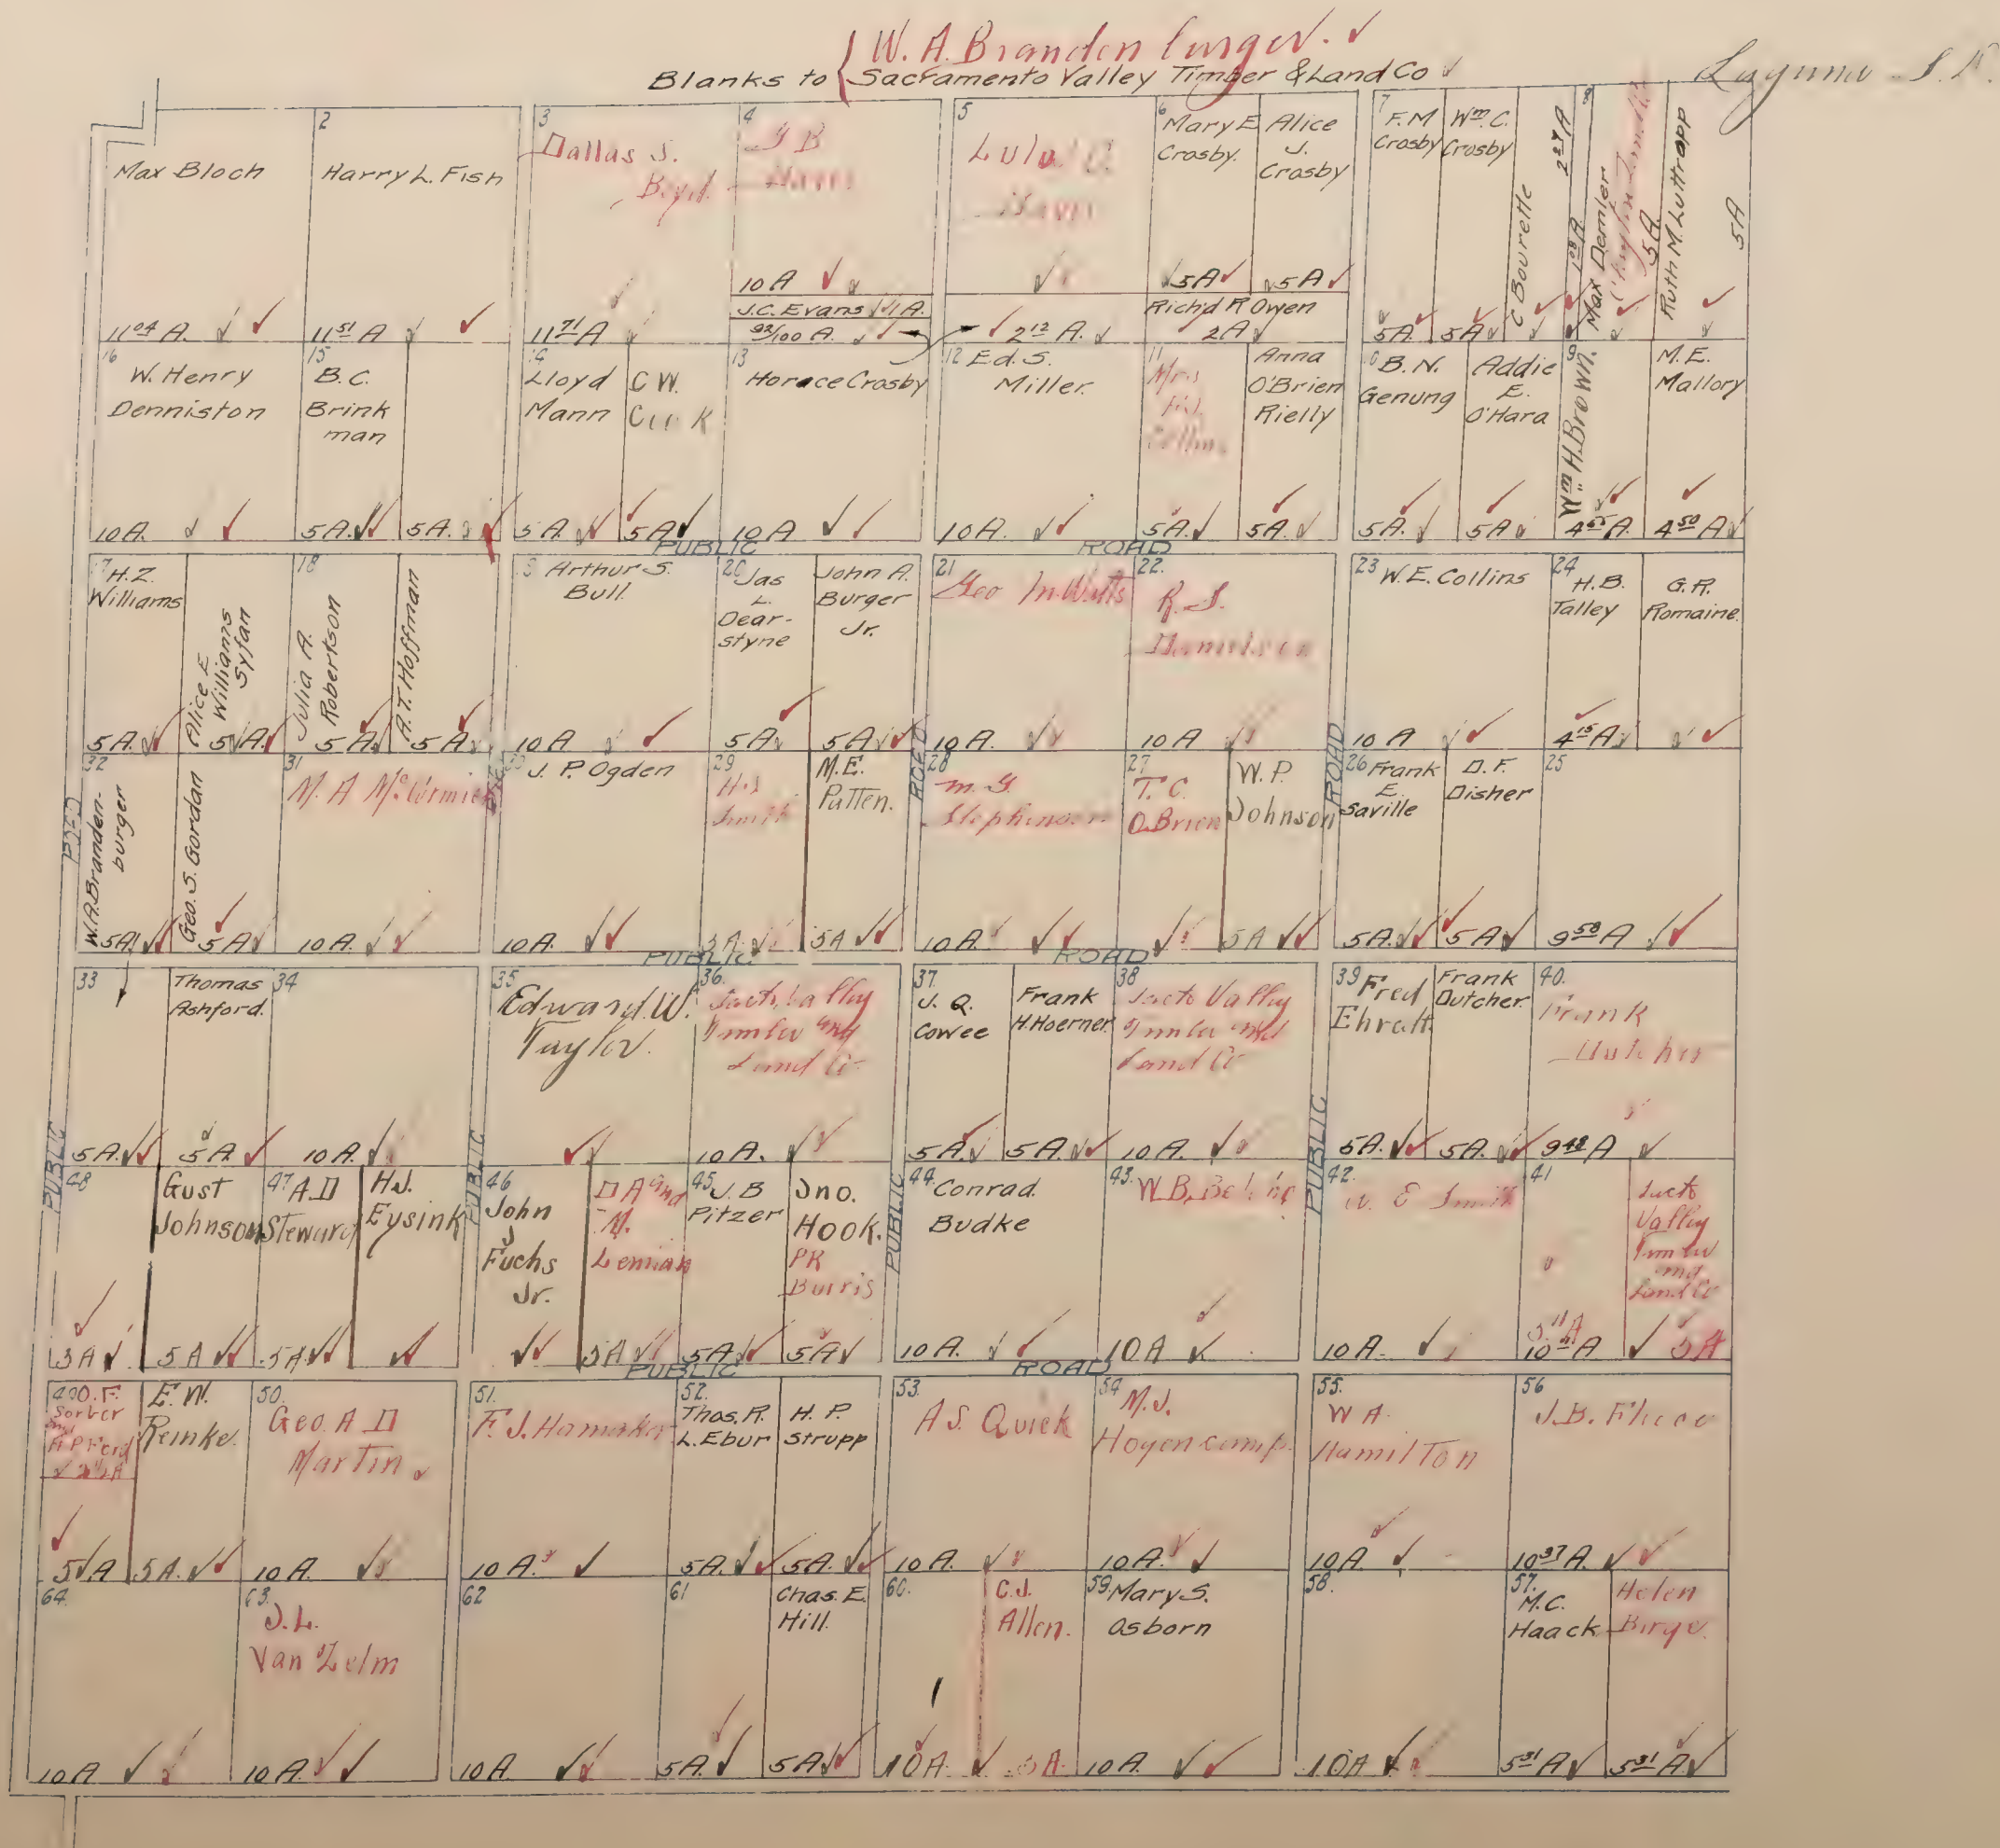

Mapped.

SACRAMENTO VALLEY IMPROVEMENT CO'S

SUBDIVISION NO. 13

being the
E 1/2 Sec. 31 T. 6 N. R. 8 E.

Scale: 1" = 60 chs.

Black Ink - 1919 Ownership

Red Ink - 1920 Ownership

L. 2070 S.D.

L. E. Richardson Tr.
Blanks to *Sacramento Valley Timber & Land Co.*

4	3	2	1
10A ✓✓	10A ✓✓	10A ✓✓	521A ✓✓
5	6	7	8
10A ✓✓	10A ✓✓	10A ✓✓	5502A ✓✓
13	12	11 E. Dora Delaney	9
10A ✓✓	10A ✓✓	5A ✓✓	5521A ✓✓
14	15	16 F. M. Mitchell	17
10A ✓✓	10A ✓✓	10A ✓✓	5551A ✓✓
22	21	20 L. E. Richardson Tr.	18
10A ✓✓	10A ✓✓	5A ✓✓	5576A ✓✓
23	24	25 Charles & Caroline Gross	26
10A ✓✓	10A ✓✓	5A ✓✓	560A ✓✓
31 L. E. Richardson Tr.	30	29 Robt. H. Hoffmeister W. A. Brandon-burger	27
10A ✓✓	10A ✓✓	5A ✓✓	5620A ✓✓
32 T. E. Turner	33	34	35
5A ✓✓	10A ✓✓	10A ✓✓	820A ✓✓


Black Ink-1919 Ownership
Red Ink-1920 Ownership

SACRAMENTO VIEW

LOCATED IN THE
S.E. 1/4 of Sec. 19, T. 8 N., R. 5 E.

Scale: 80' = 1"

Pacific S.D.

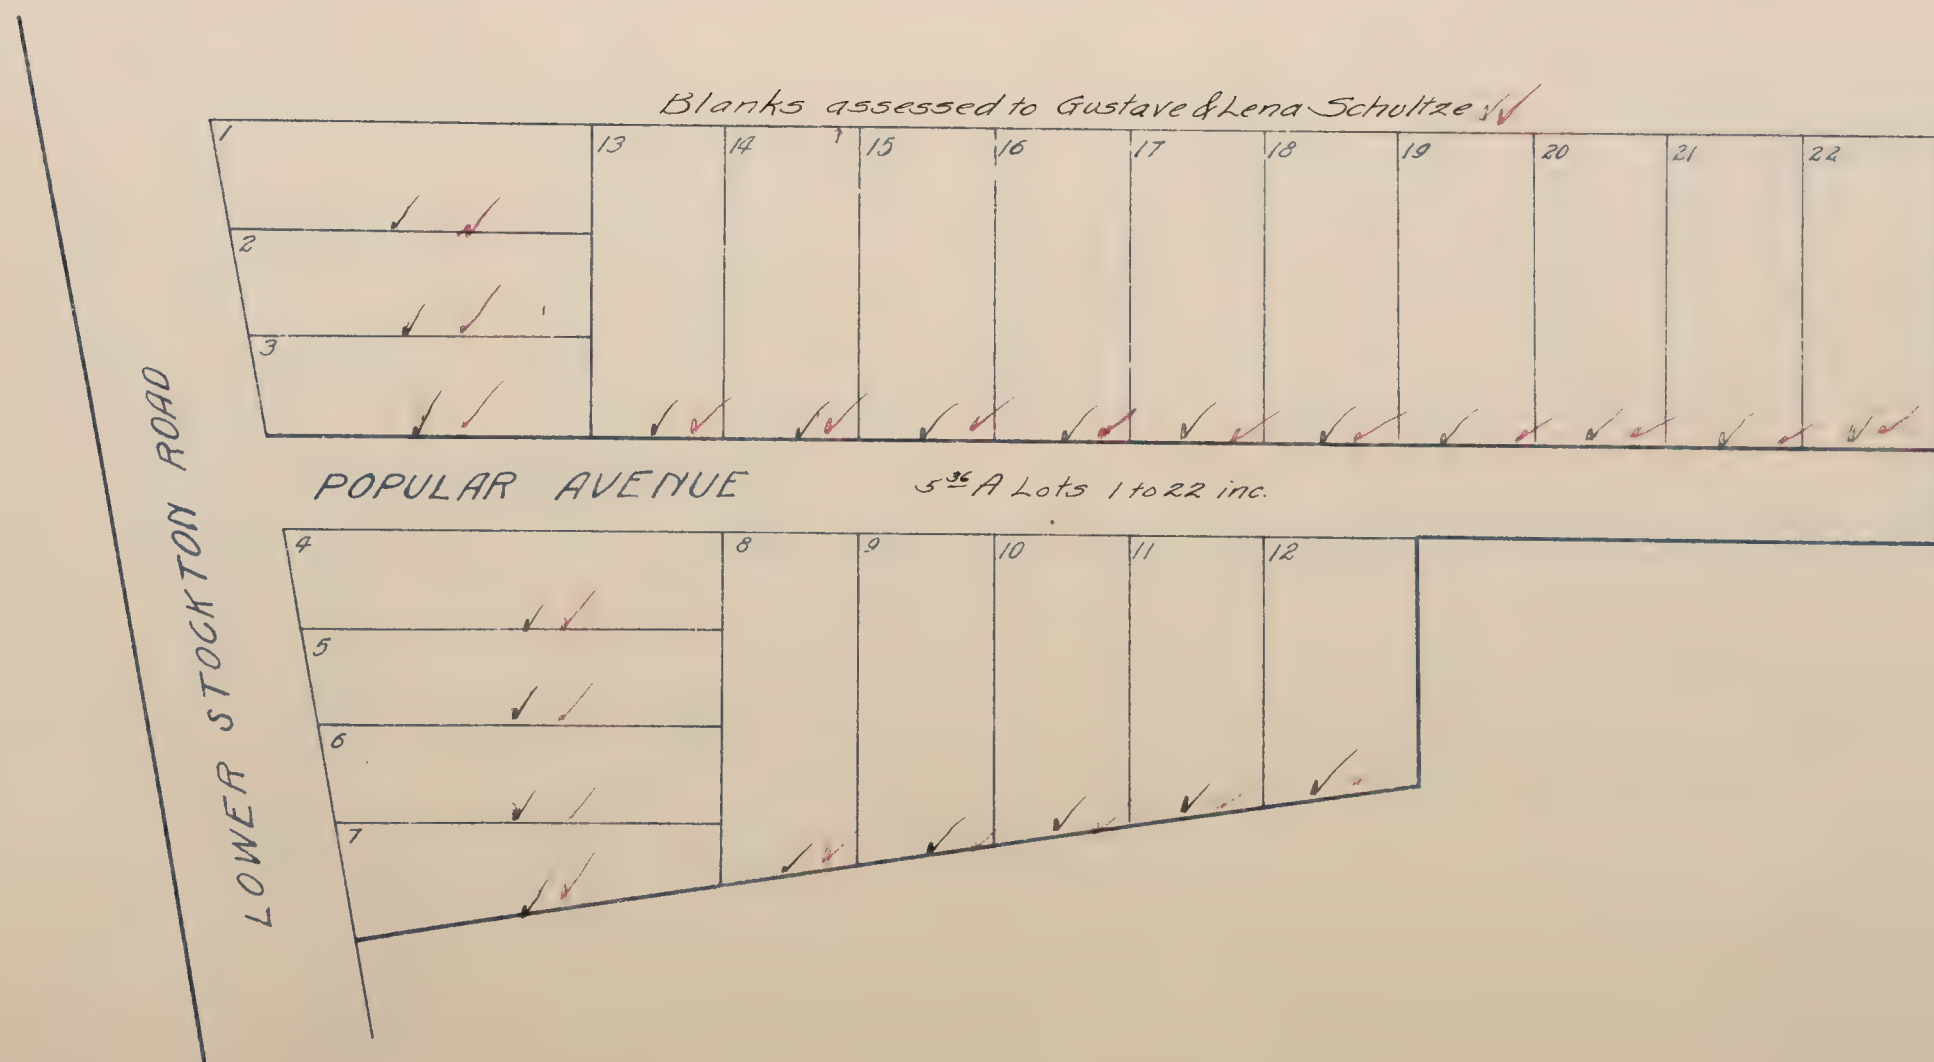


SEYMOUR CARR TRACT

located in the
S 1/2 of Section 28 T6N R7E.
Scale 1"=400'

Alabam S.D.

Black Ink-1910 Ownership
Red Ink-1920 Ownership

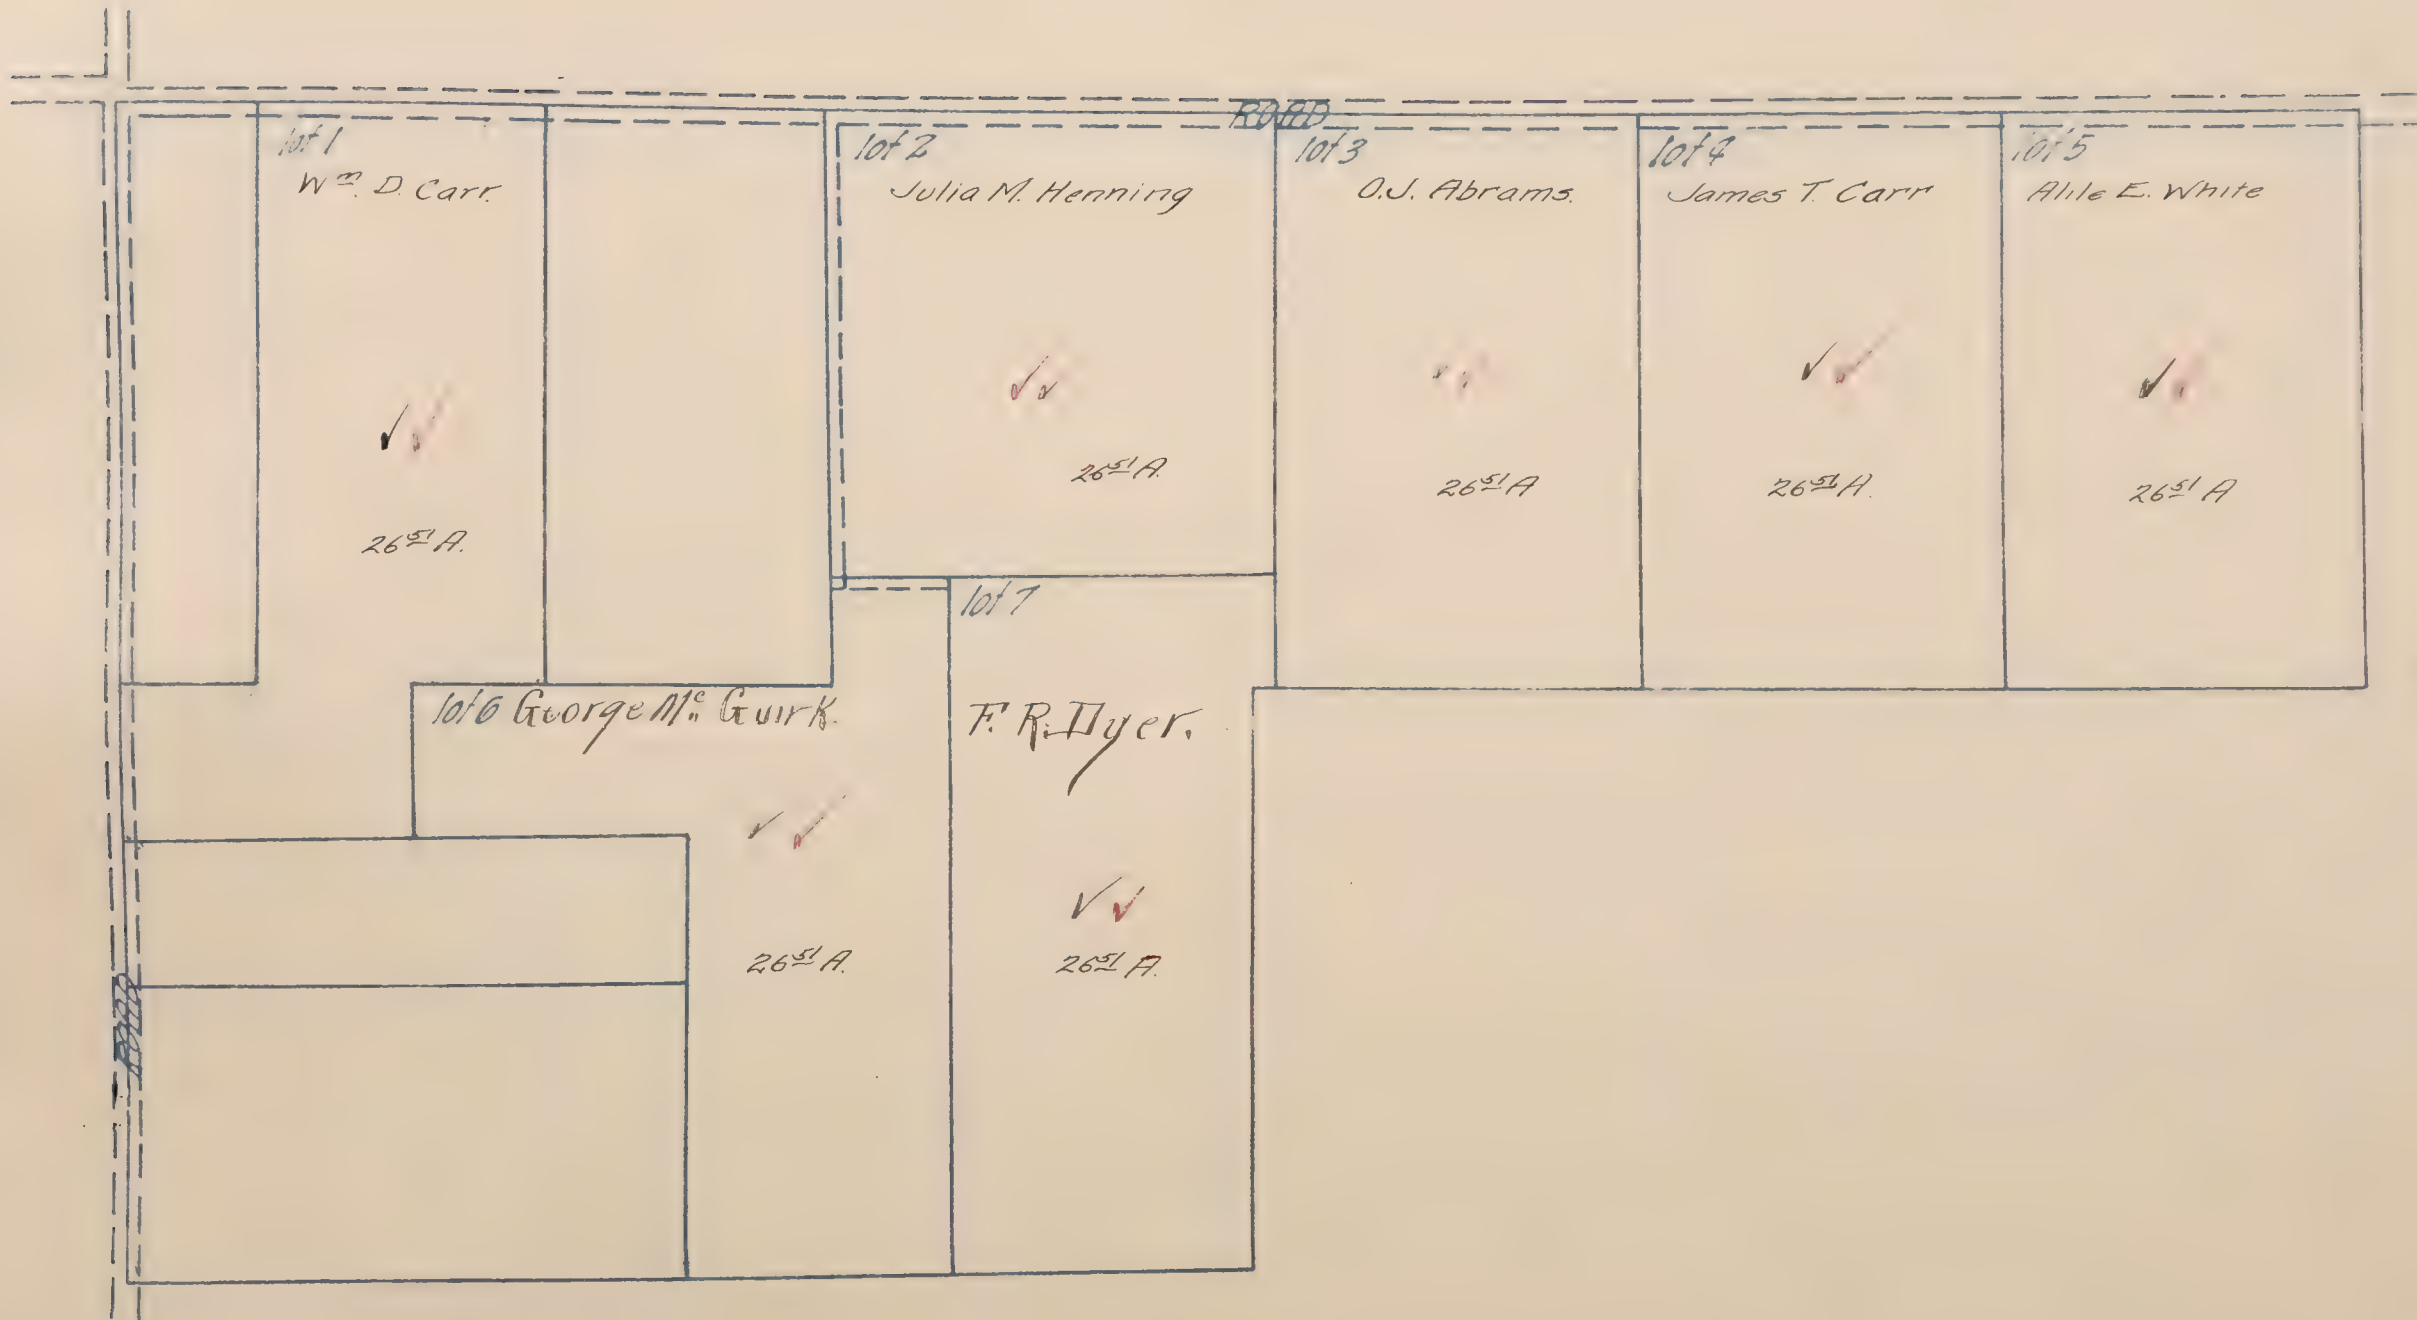

Black Ink-1919 Ownership
Red Ink-1975 Ownership

562. 1. 200

566A

95A A.

Welsey, A. Tiffy

591 A.

6²⁷ A.

$5000 \div 12 = 300 \text{ r } 8$

844 A.

GRANT

1403
Water Smelter
5000

✓ 7¹⁴ A.

849 A

9th A.

192 A.

10³⁵ A.

1082 A.

10 A.

10 A.

10 A.

75A.

951 A.

Black Ink-1919 Ownership
Red Ink-1929 Ownership

SHERWOOD HEIGHTS

List of Sutterville Heights Trees
 1901-1902

Freeman F. S. H.

[illegible]

SHERWOOD AVENUE

Mapped.

Black Ink-1919 Ownership
Red Ink-1920 Ownership

SHOPSIDE

or
BROOKE REALTY CO. SUBD. N^o 116
LOCATED IN


S.W. 1/4 of Sec. 18 & N.W. 1/4 of Sec. 19, T.8N., R.5E.

Scale: 50' = 1"

Blanks to Roy Brooke & J. L. Scholefield.

4 Paul Ridge

SHOPSIDE

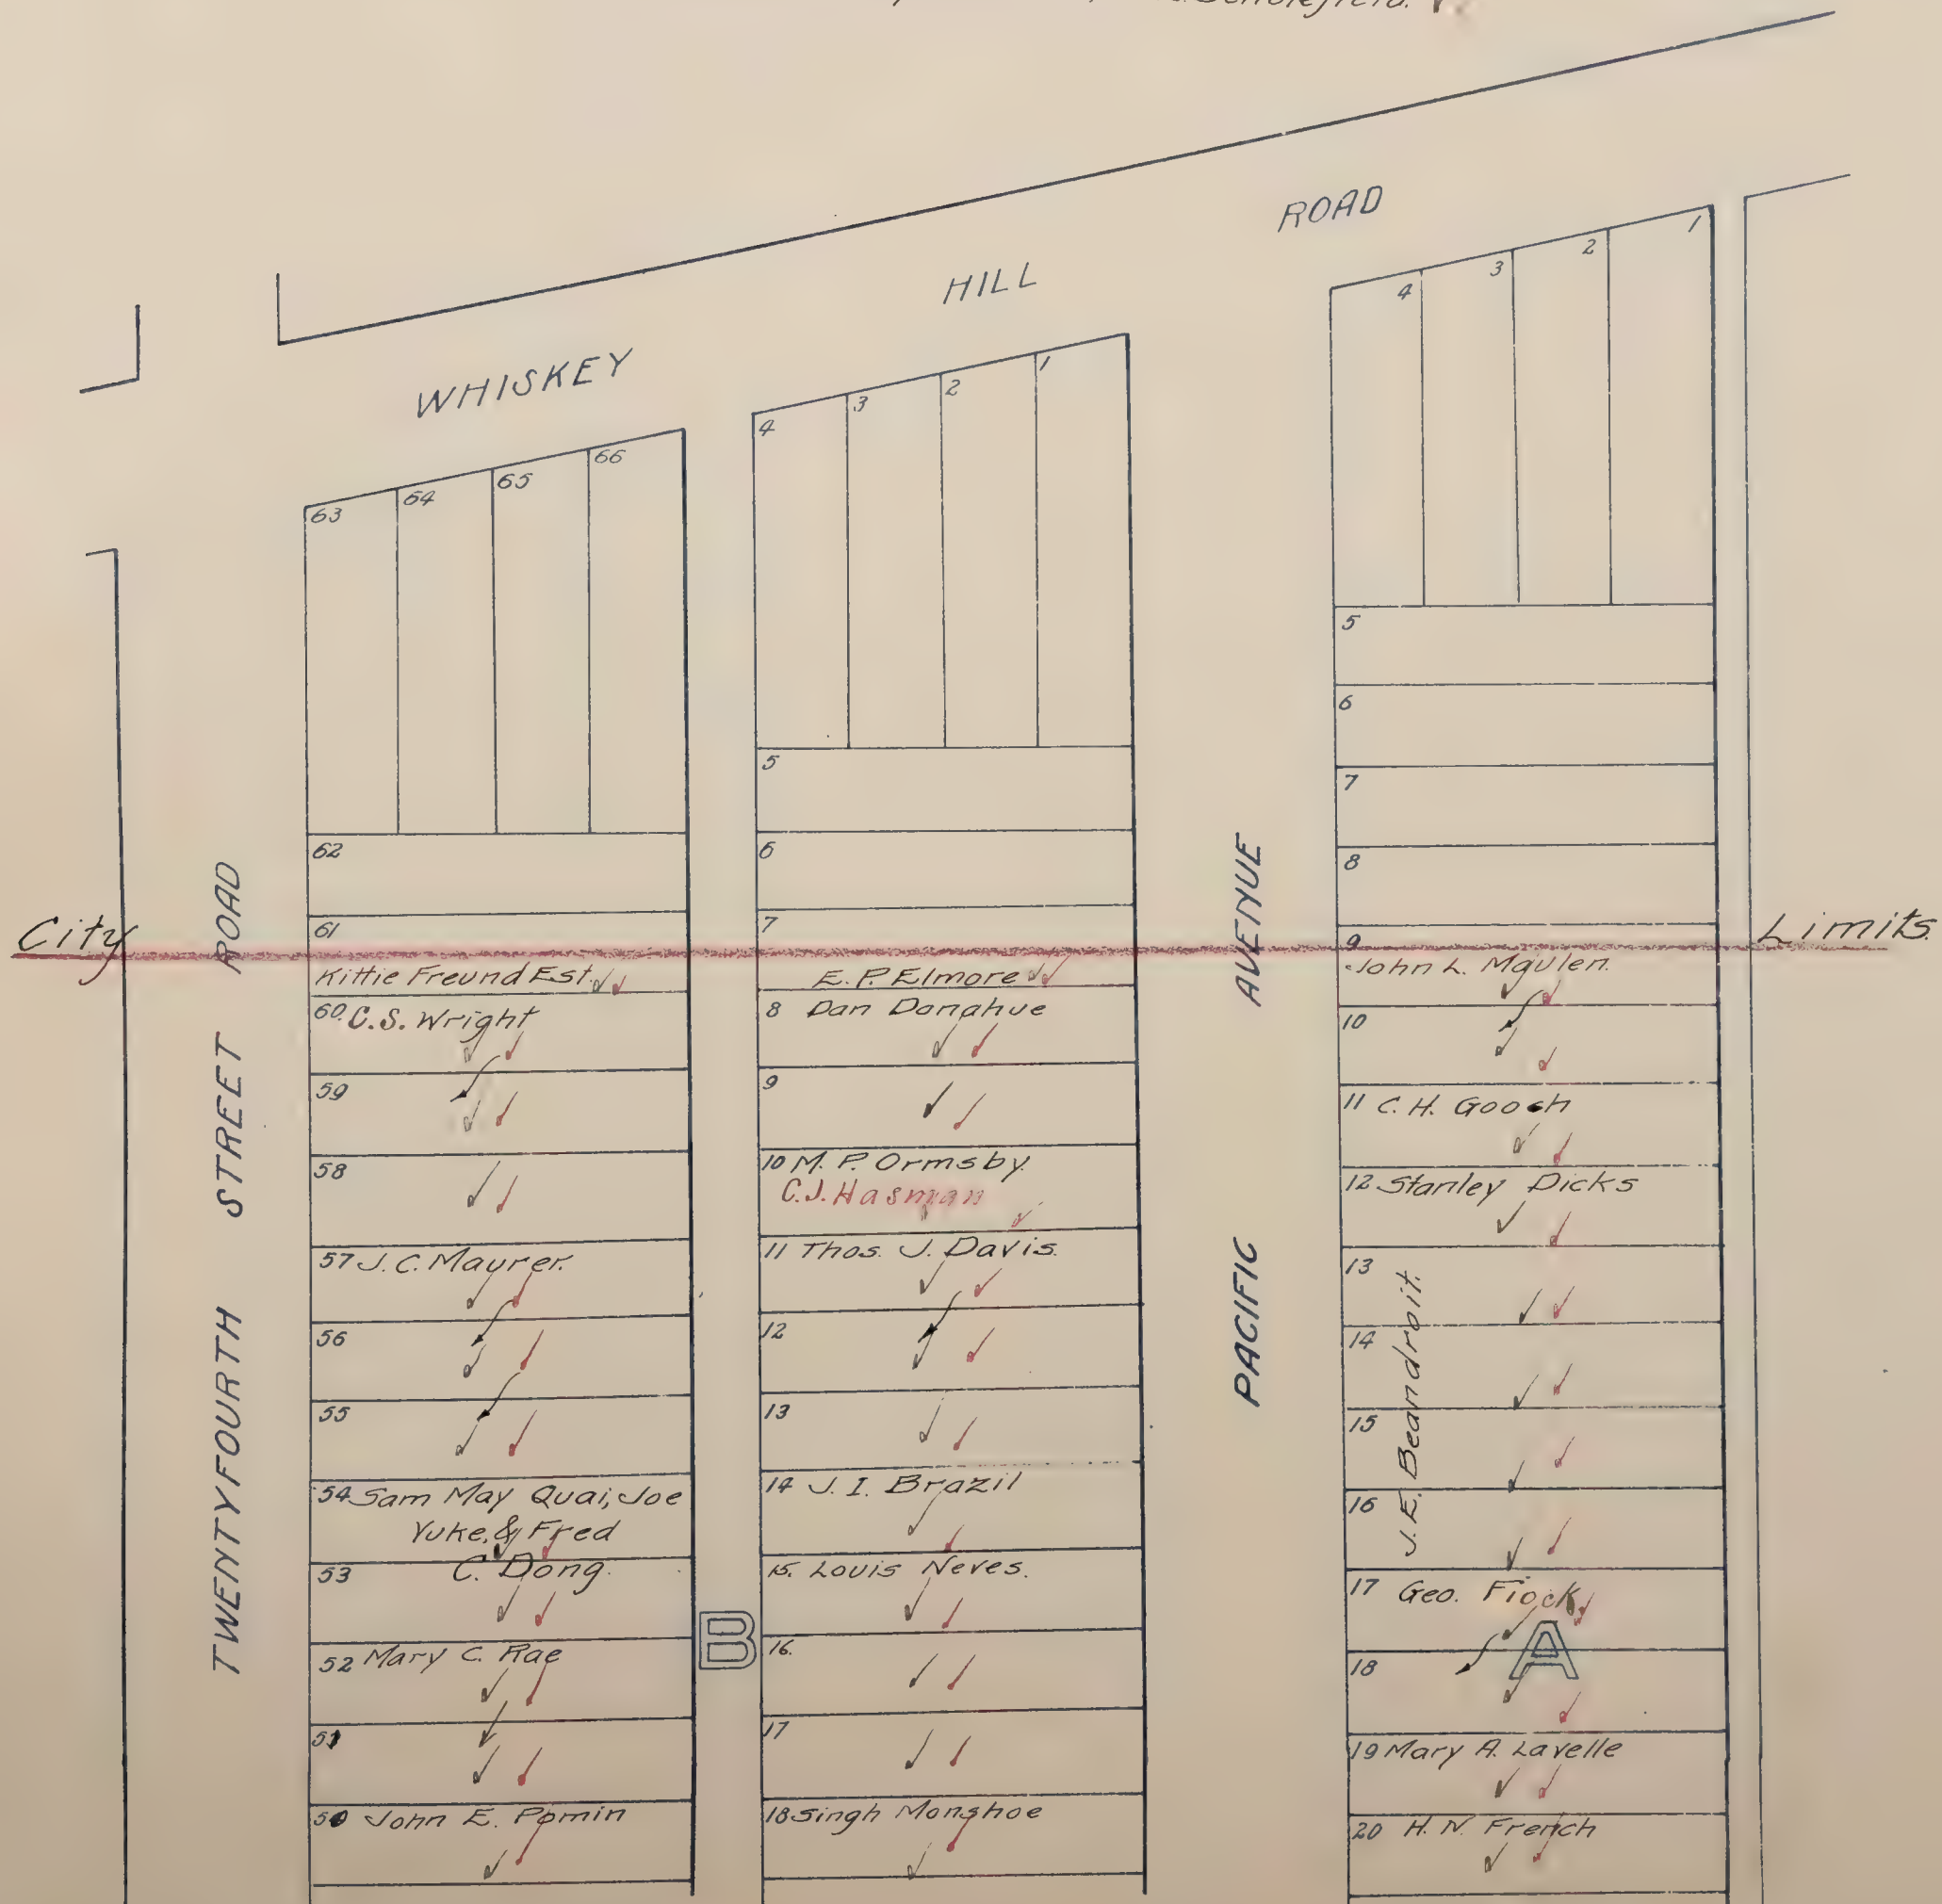

Mapped.

SHOPSIDE

or

BROOKE REALTY CO SUBD N° 116

LOCATED IN


S.W. 1/4 of Sec 18 & N.W. 1/4 of Sec 19, T.8N, R.5E.

Scale: 50' = 1"

Black Ink - 1919 Ownership
Red Ink - 1920 Ownership

Palmetto S.D.

Blanks assessed to Roy Brooks & J.L. Scholefield

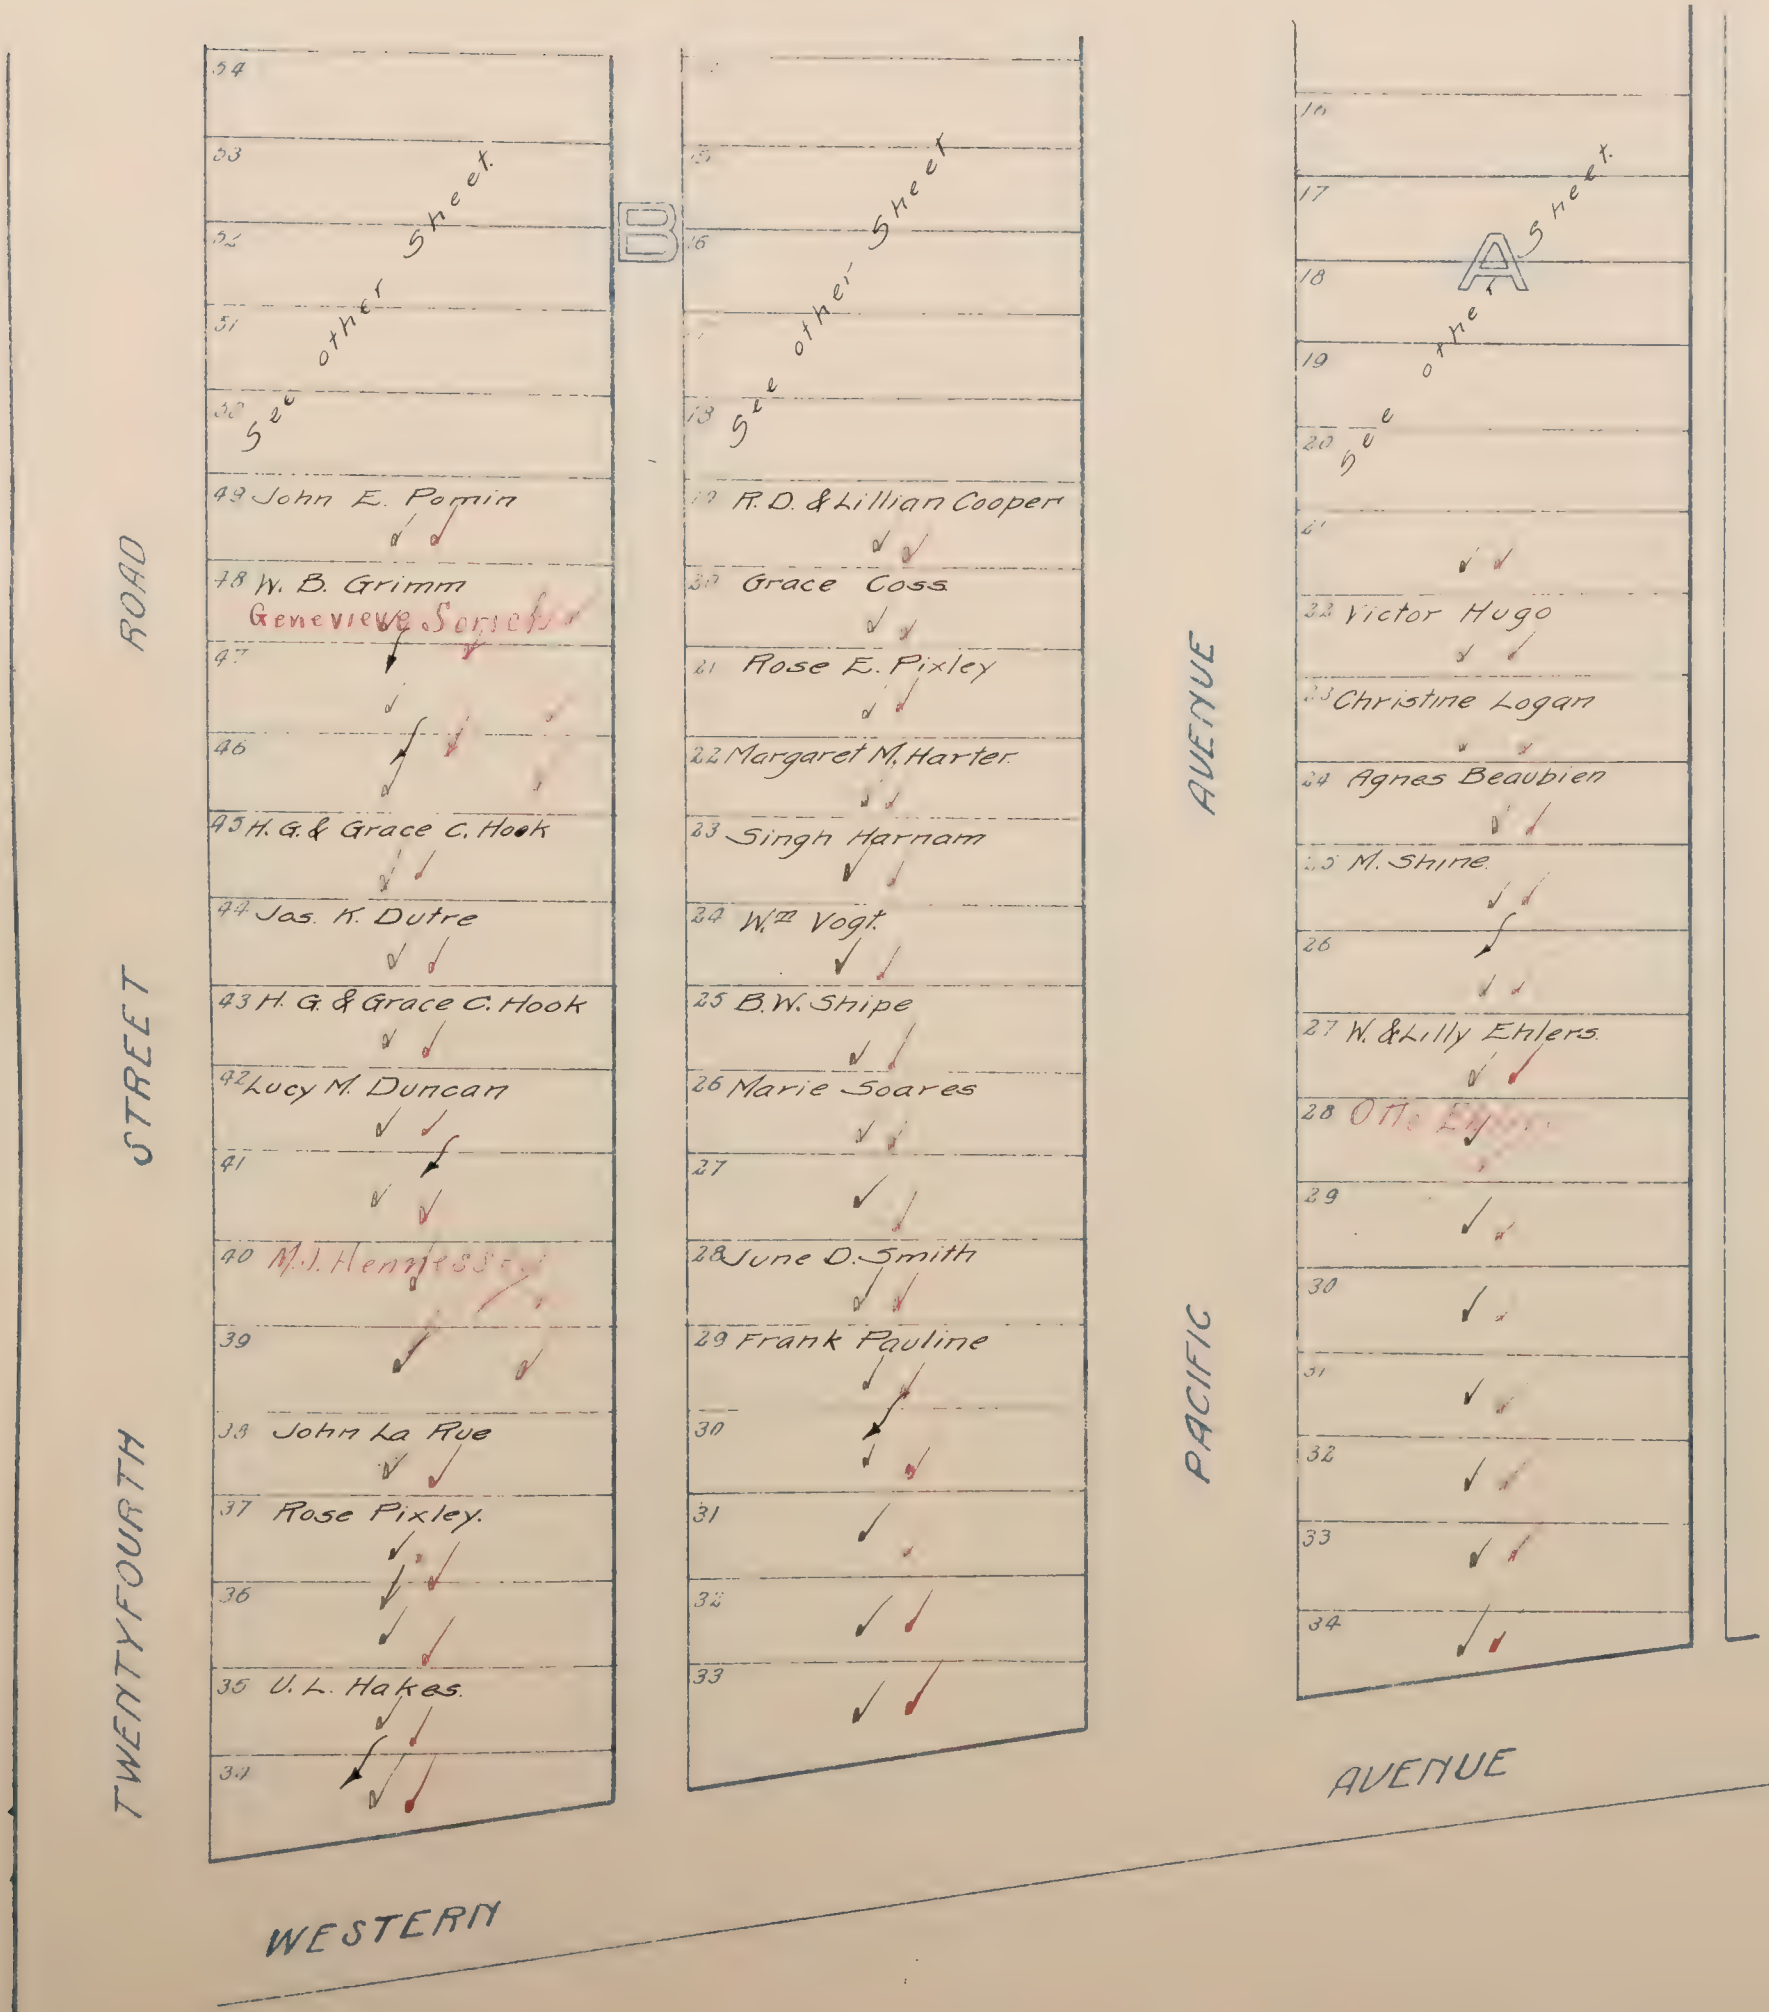

Black Ink-1919 Ownership
Red Ink-1920 Ownership


SIERRA VISTA PARK

SECTION 14
TOWNSHIP 37 NORTH RANGE 12 EAST

Sheet 1 of 2

Page 132

Blanks assessed to C.M. Goethe ✓

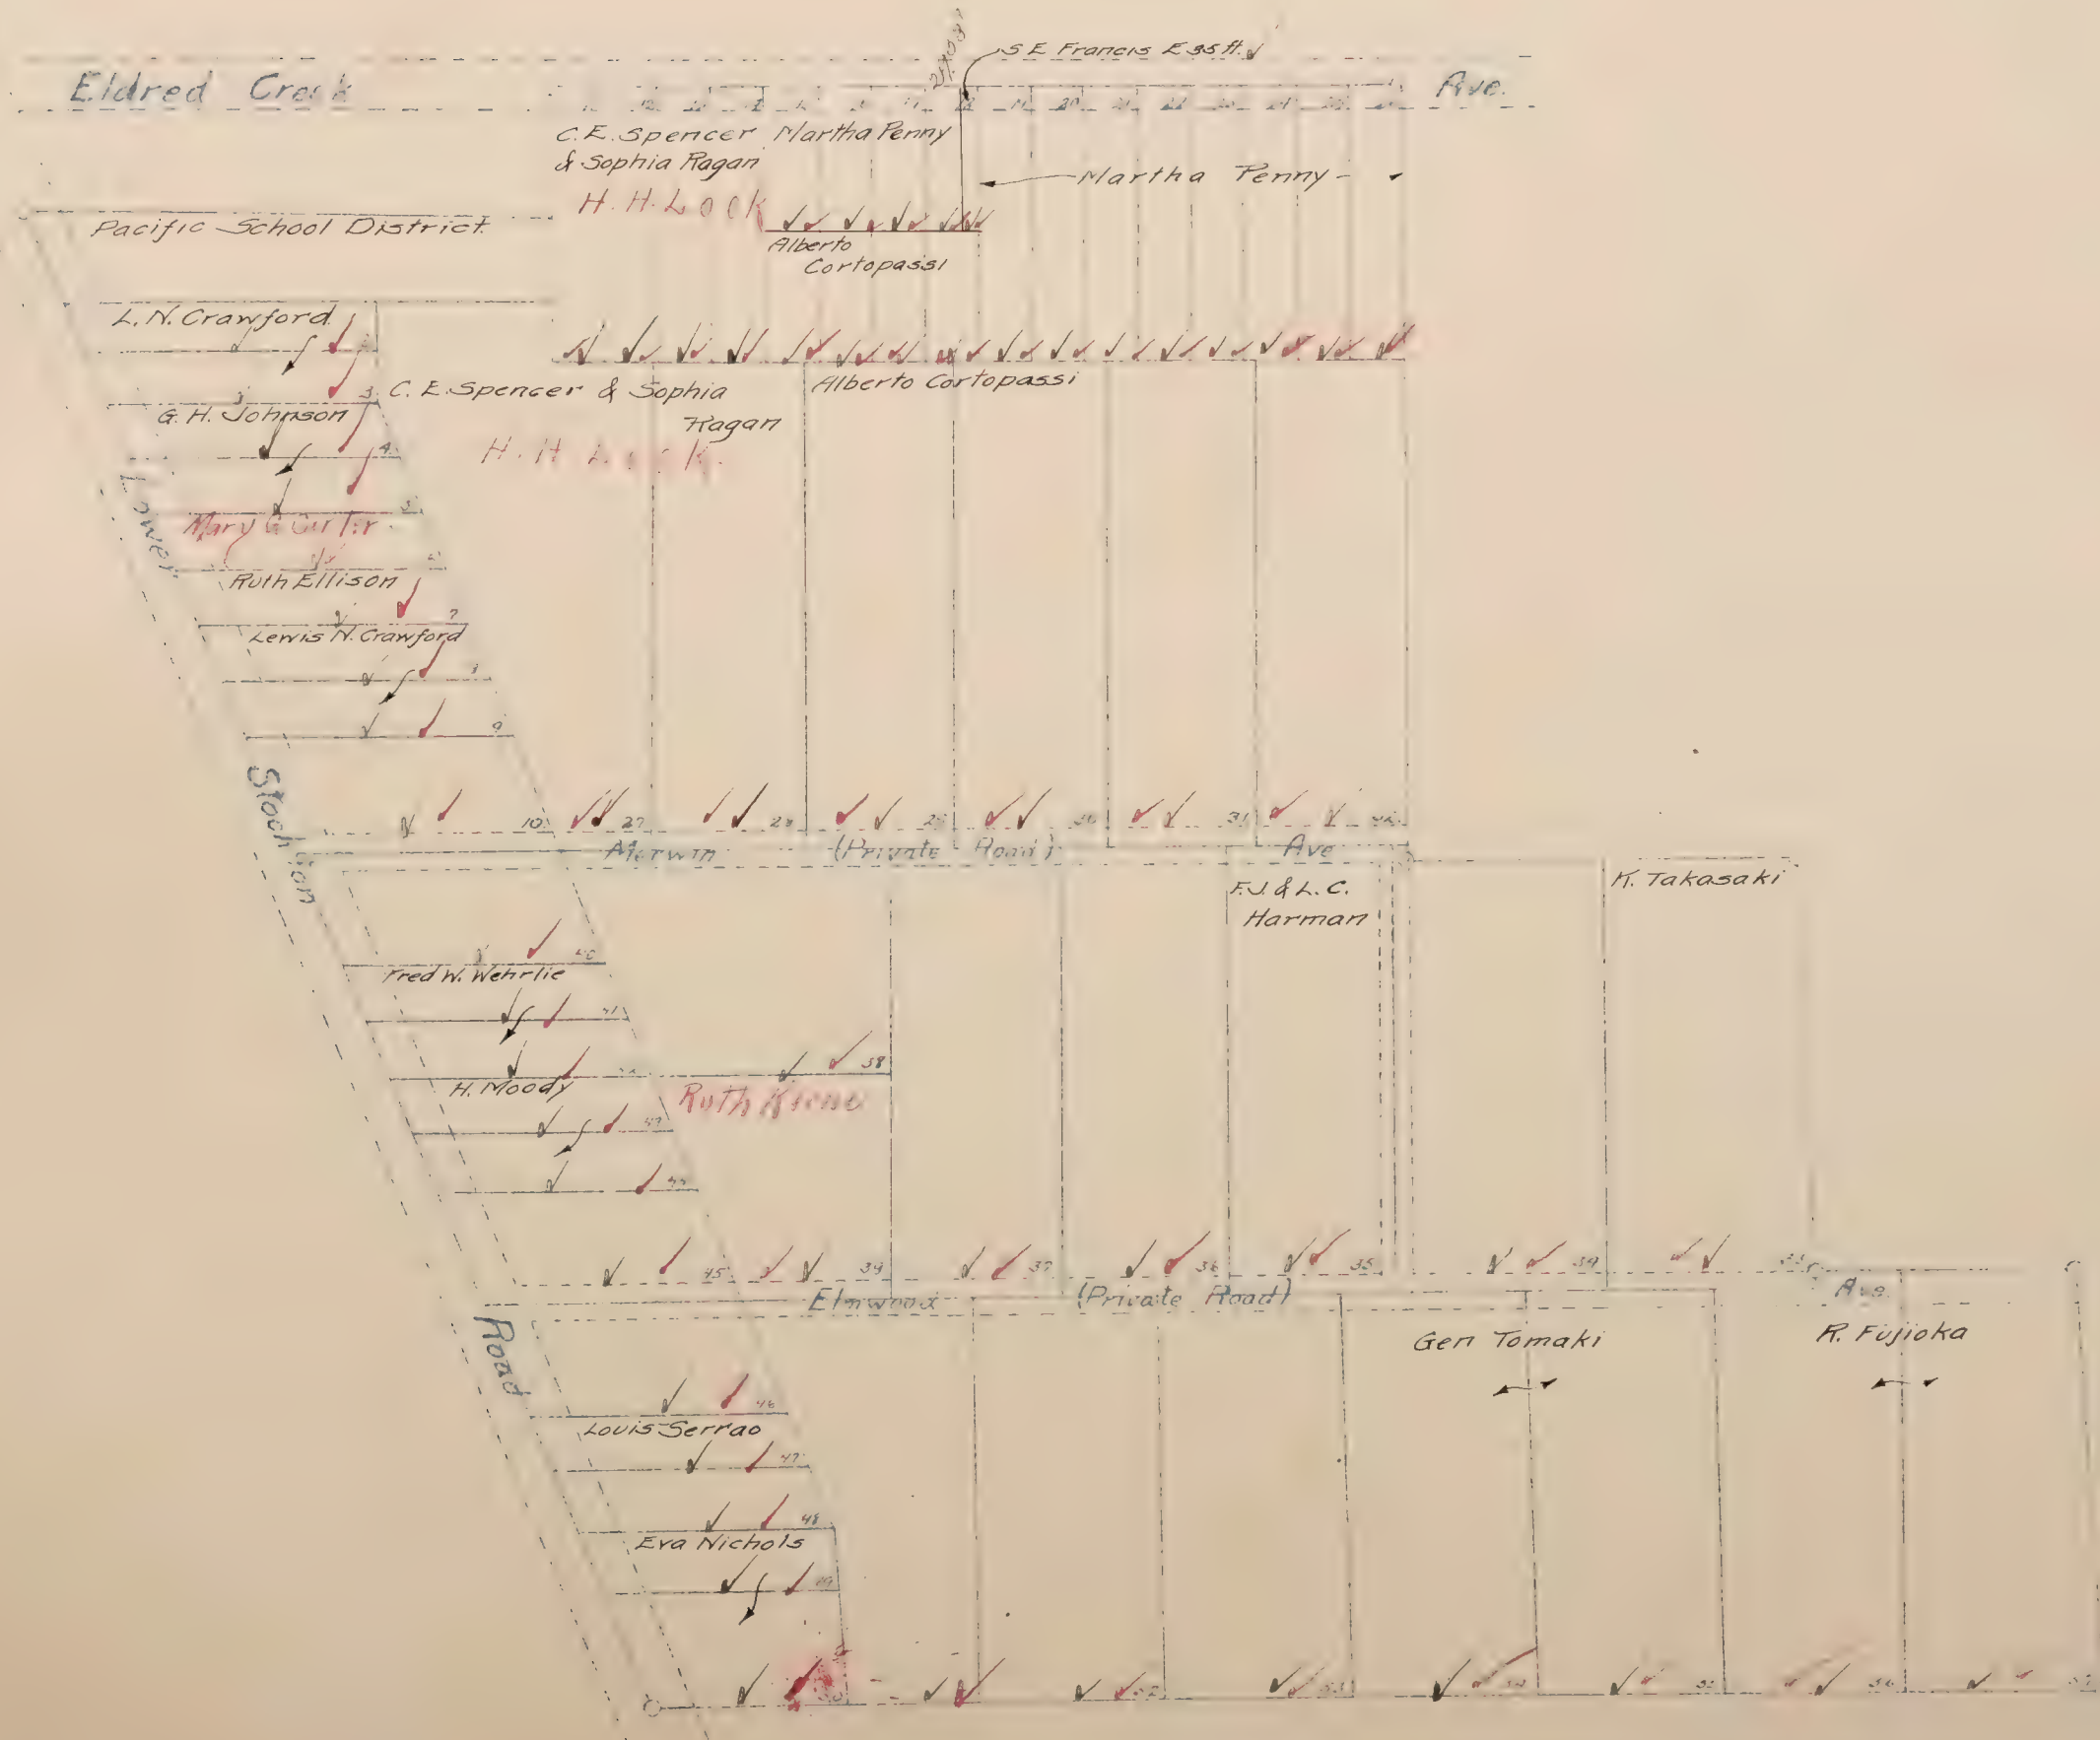

Mapped.


Black Ink-1919 Ownership
Red Ink-1913 Ownership

SIMMONS TRACT

LOCATED IN
S.E. 1/4 Section 7 T.10N.R5E.

Scale 4 chains=1 inch

Lincoln SD.

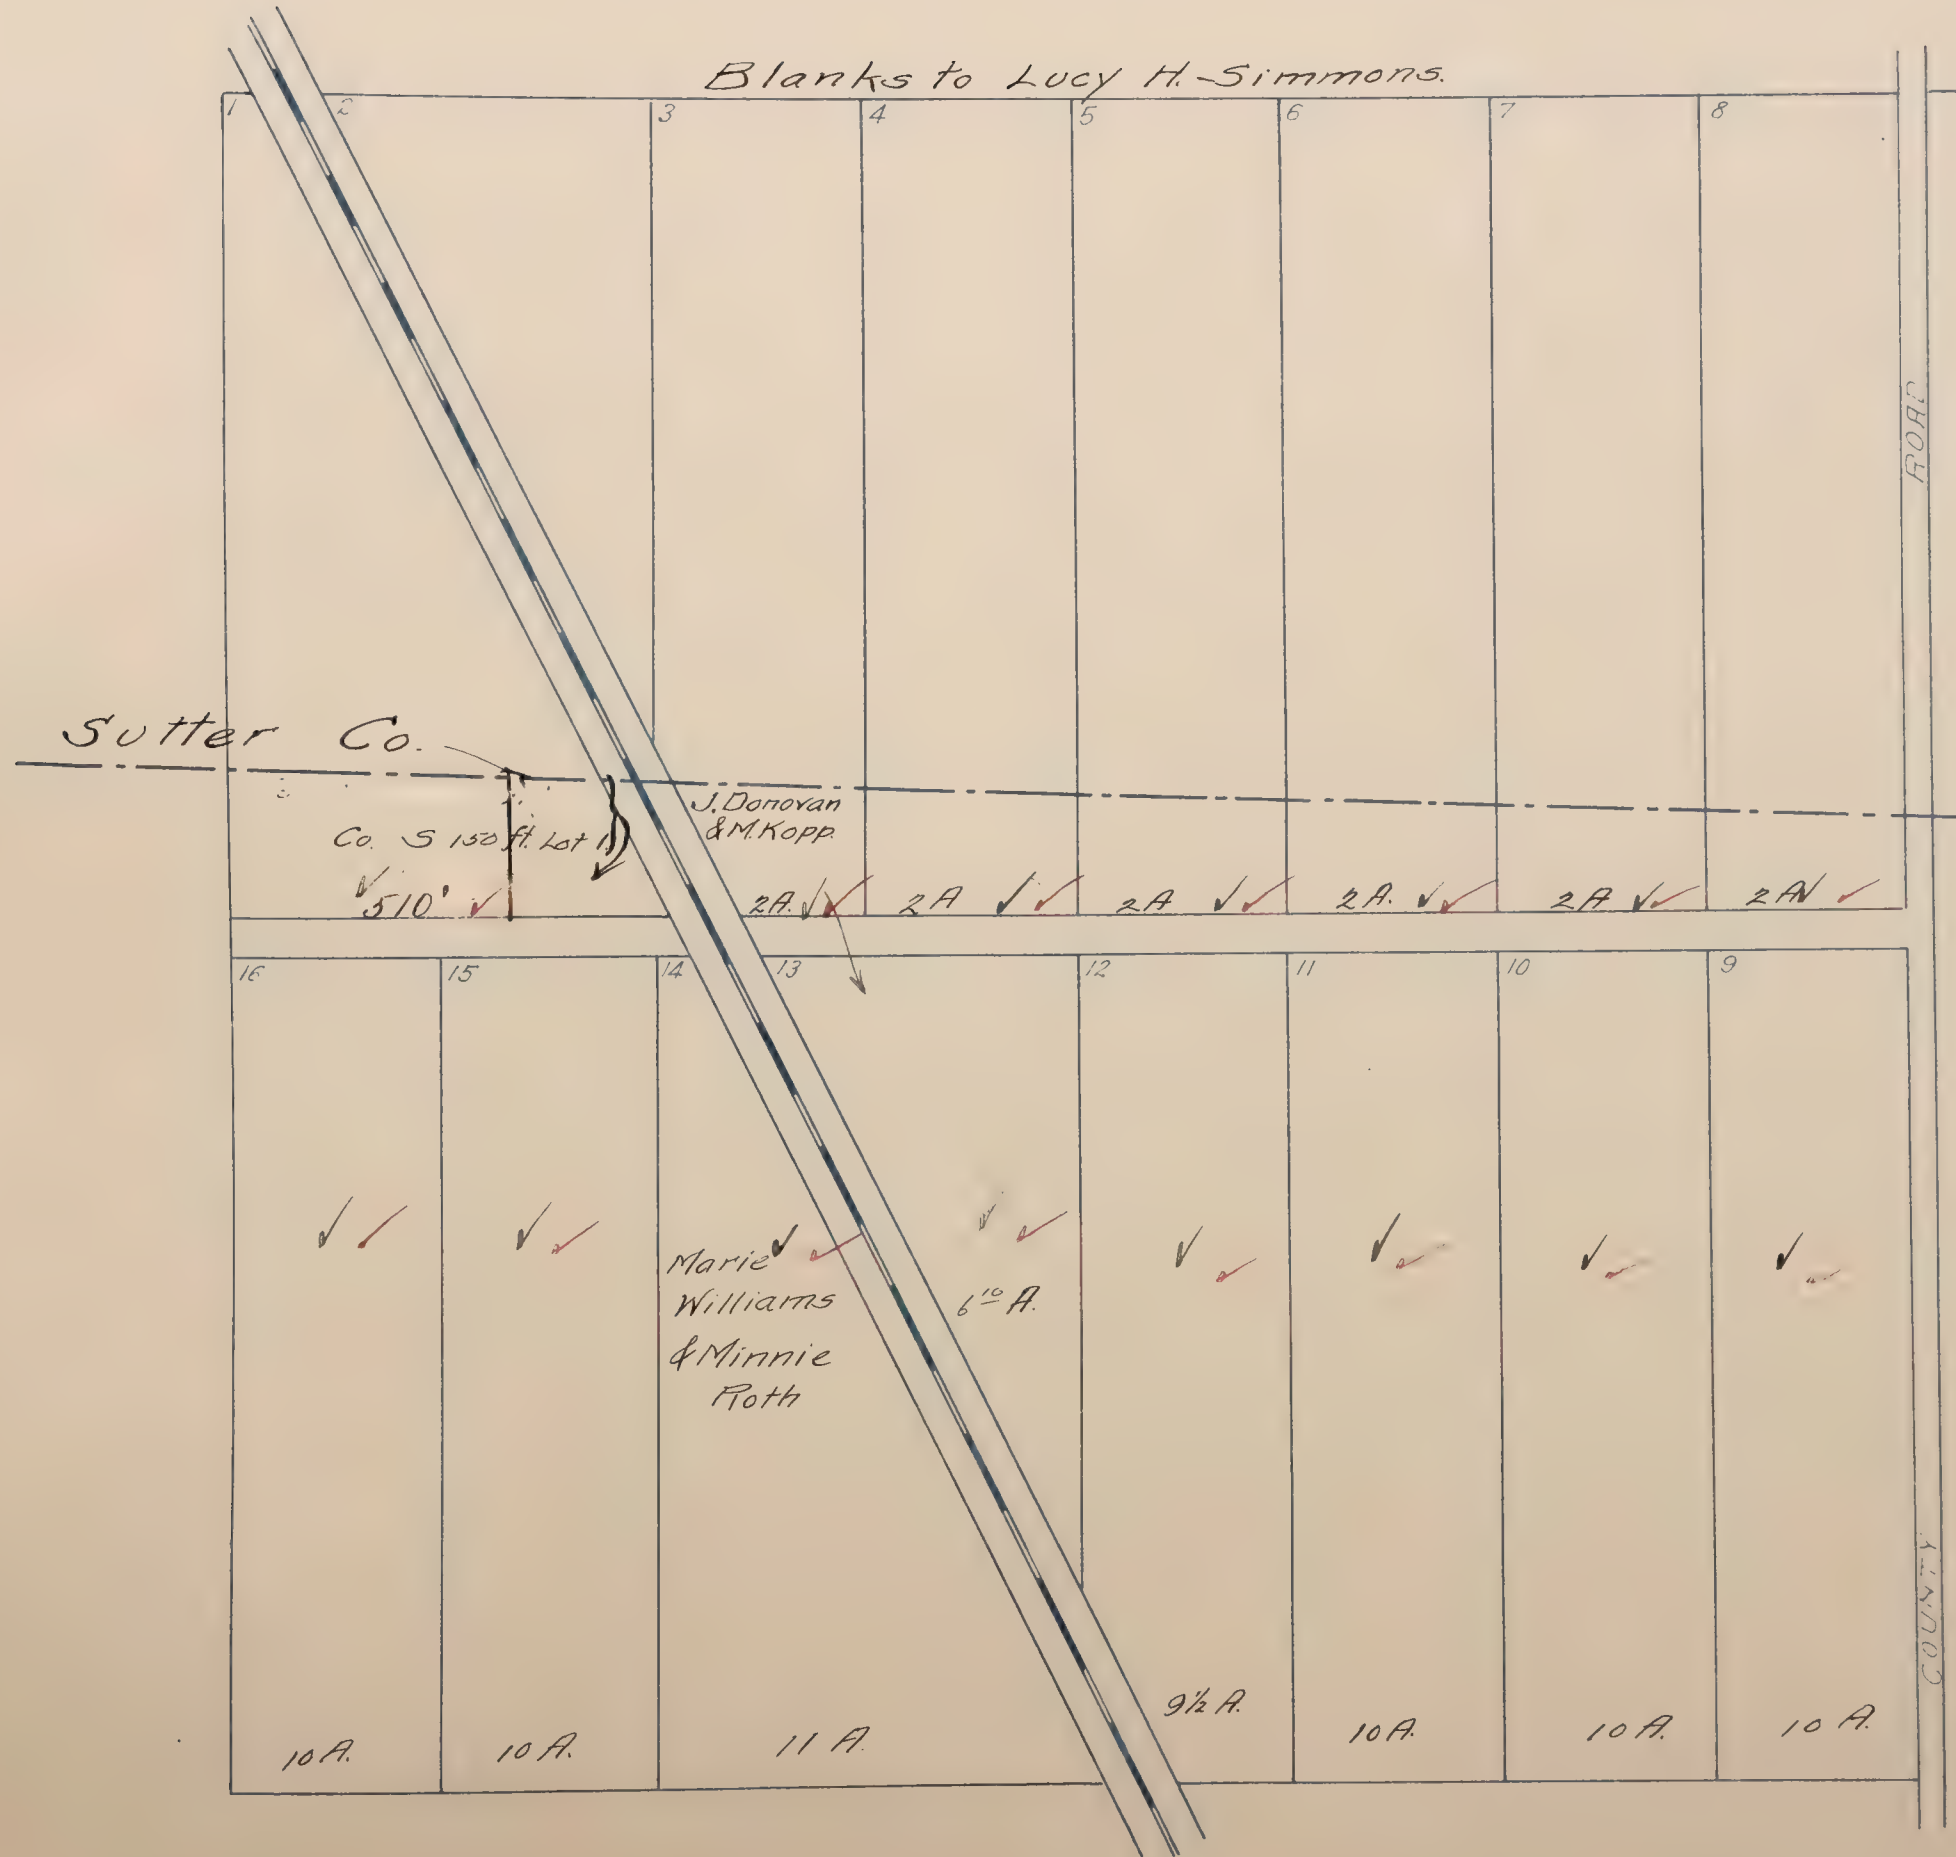

SIMMONS


SOUTH SAC'TO GARDENS

being a sudh
SE. 1/4 Sec. 27 T8N R5E.
Scale: 1" = 200 ft.

Black Ink - 1919 Ownership
Red Ink - 1900 Ownership

Elder Creek S.D.

Blanks assessed to Chas. A. Alverson. ✓✓

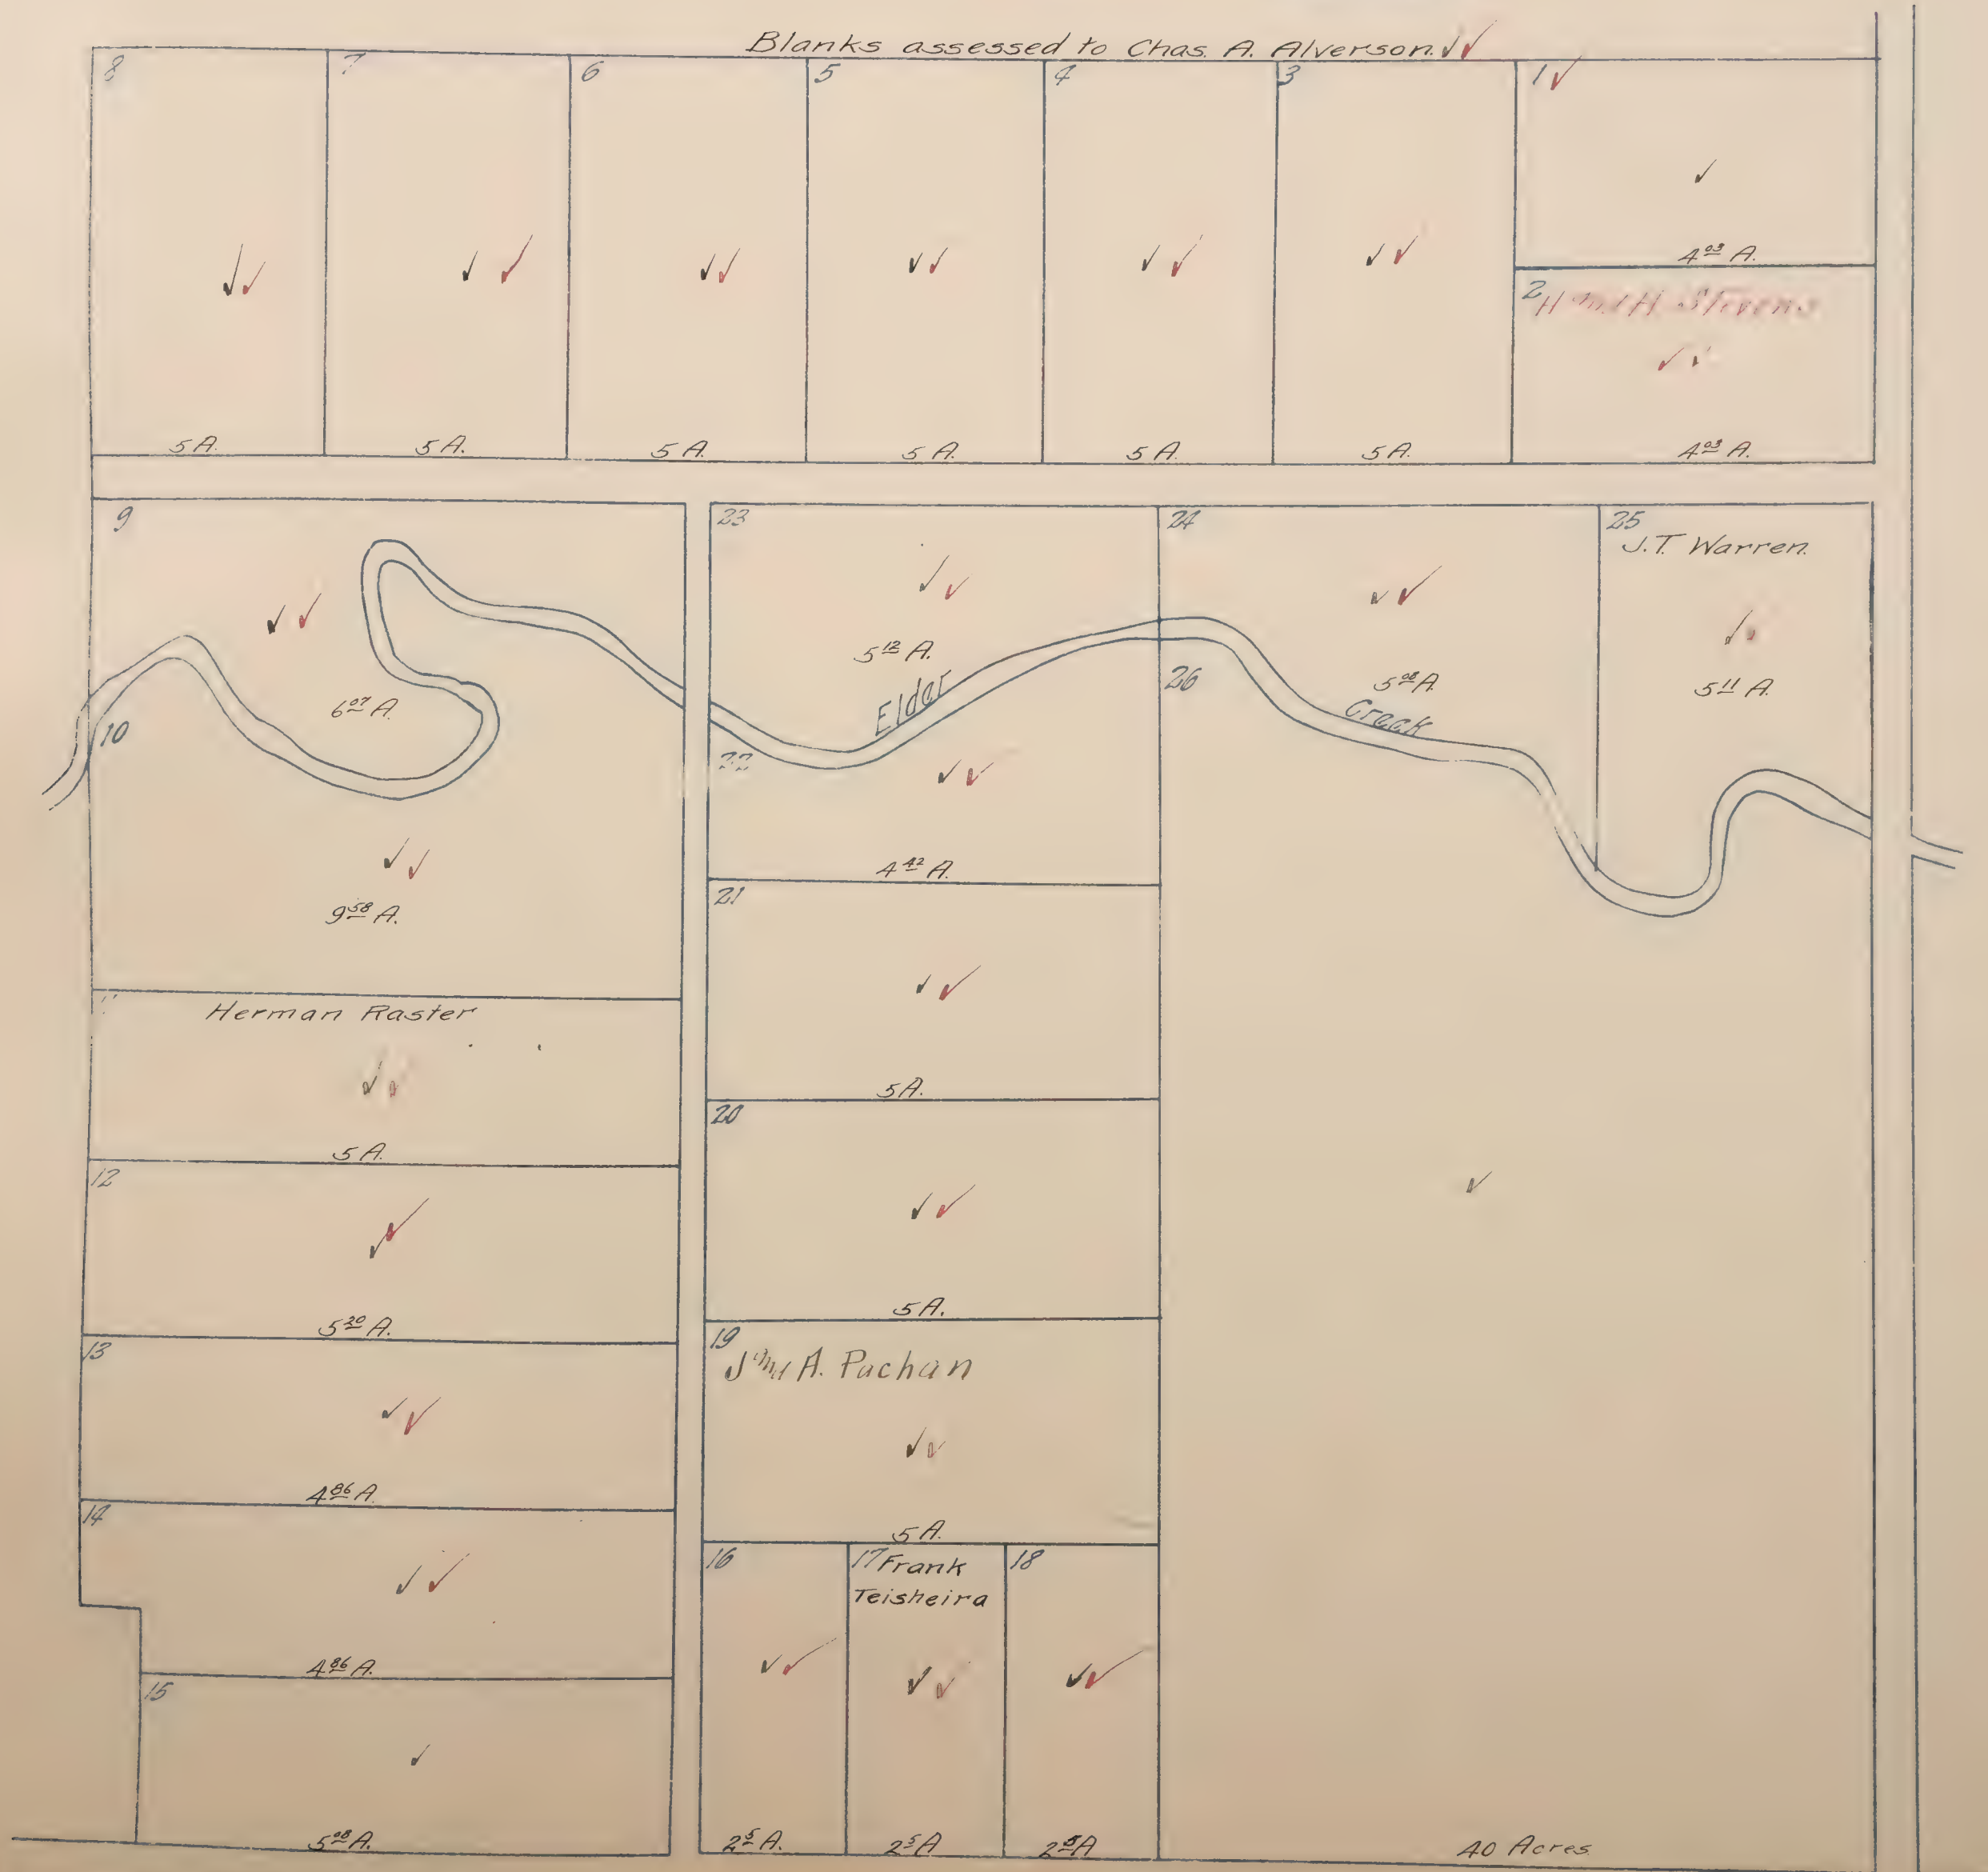

STELLA TRACT

LOCATED IN
N.W. 1/4 of Sec. 19 T.8N.R.5E.

Scale: 1" = 80'

Black Ink-1919 Ownership
Red Ink-1921 Ownership

Blanks assessed to Sam'l Ginsberg. ✓✓

Pacific L.L.

WESTERN			ARLINGTON AVENUE			AVENUE		
1	2	3				30	29	28
✓	✓	✓				Ferdinand T. Harder		
4						27		
5						26		
6						25		
7						24		
8						23		
9						22		
10						21		
11						20		
12						19		
13						18		
14						17		
15						16		

Mapped.

STEWART SUBD'N

OF

BLOCK NO. 48

SUBDIVISION NO. 1


NORTH SACRAMENTO

Scale 1" = 100'

Black Ink - 1919 Ownership

Red Ink - 1919 Ownership

Blanks to John R Hunt ✓ H. Sacto. I.D.

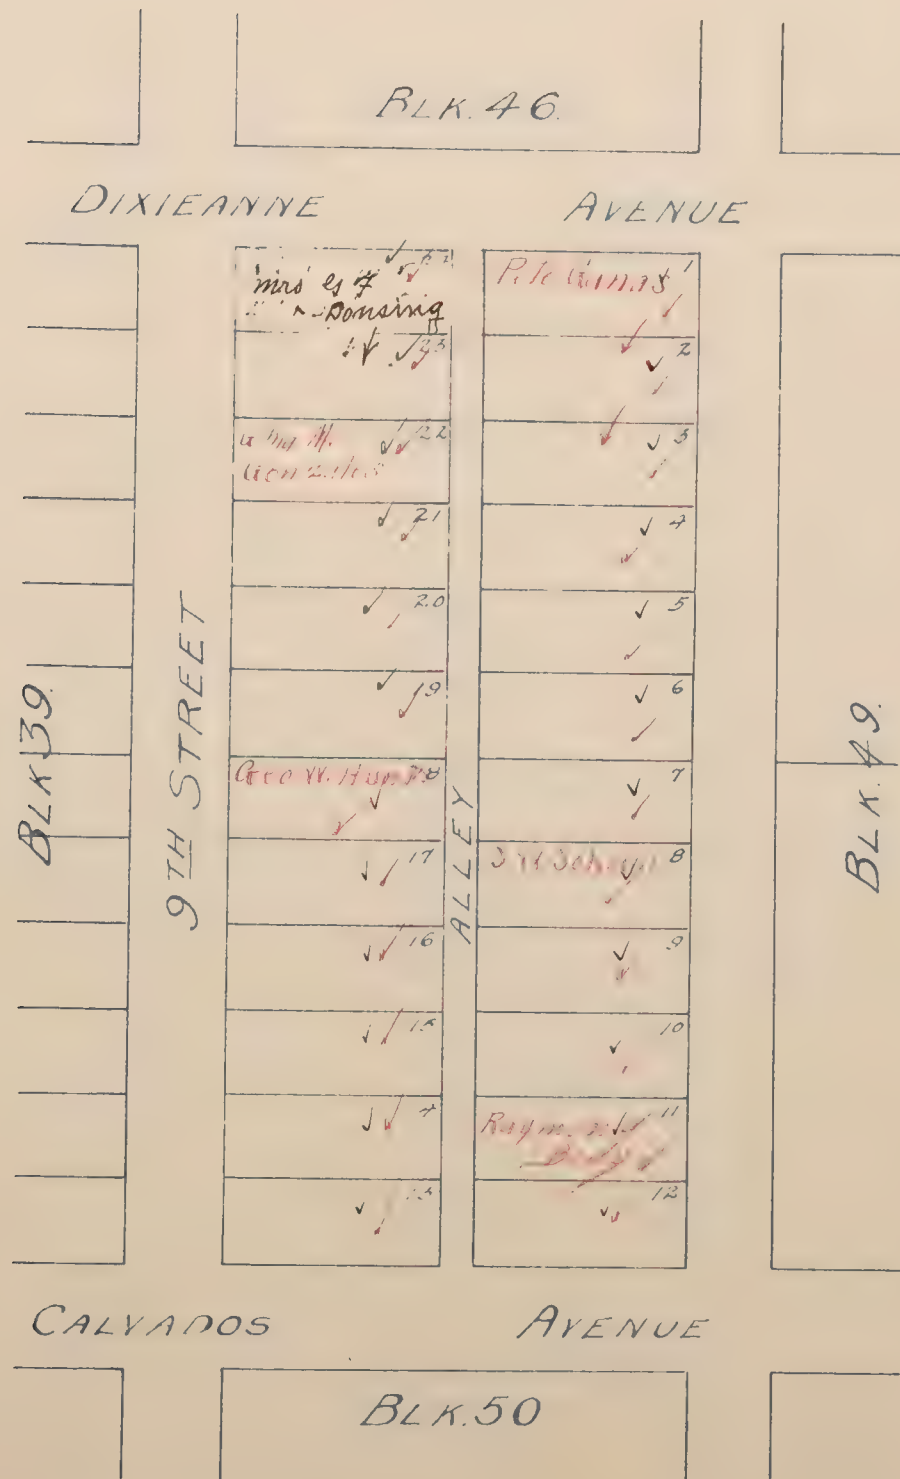

Mapped.


STROBEL TRACT.

LOCATED IN
NW 1/4 SEC 29 T. 8 N. R. 5 E.

Scale 4 chains = 1 inch.

Black Ink - 1919 Ownership
Red Ink - 1920 Ownership

Pacific S.D.

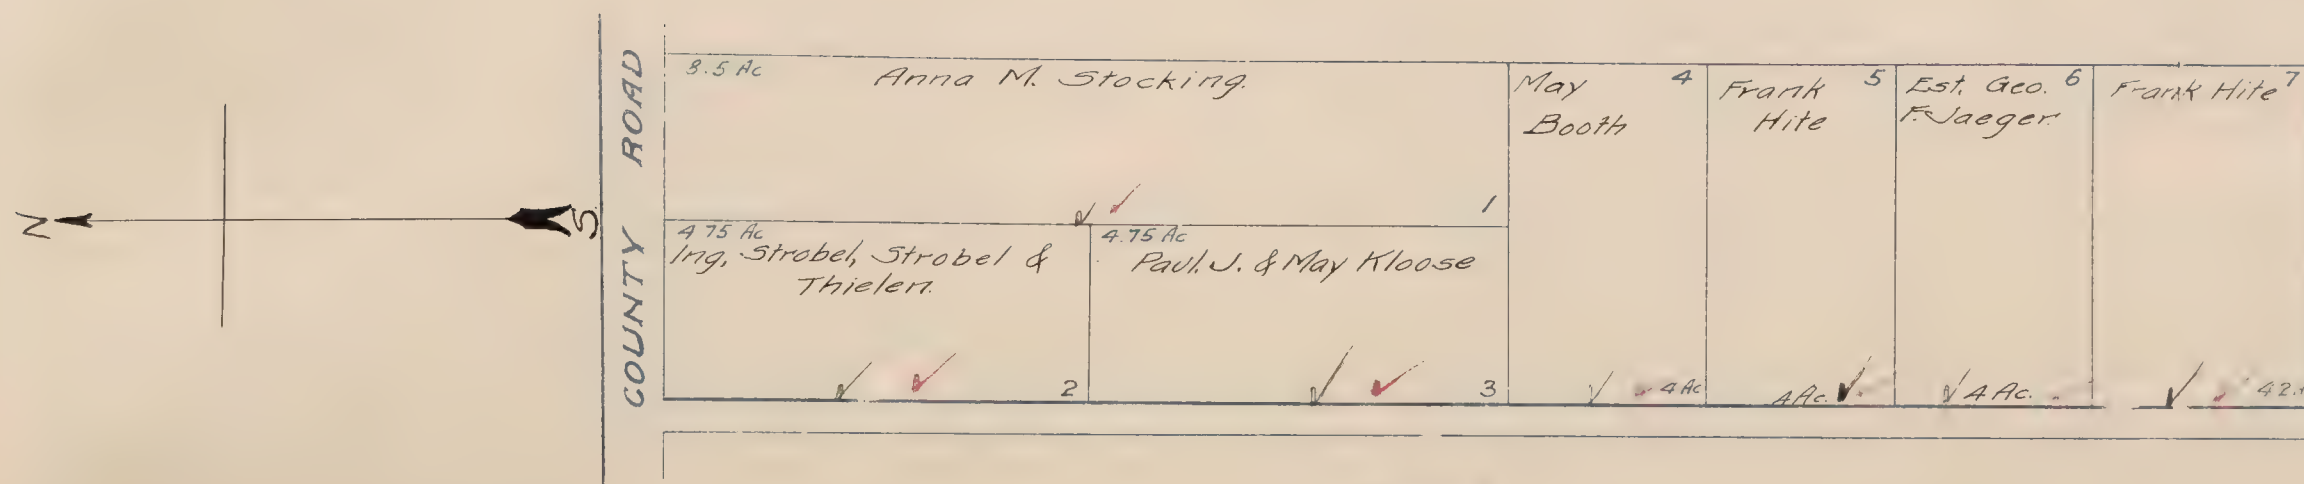

Mapped.


STROBEL TOKAY TRACT.

E 1/2 of E 1/2 SEC. 3 T. 7 N. R. 5 E.

Scale 5 chains = 1 inch

Black Ink - 1919 Ownership
Red Ink - 1920 Ownership

Florin S.D.

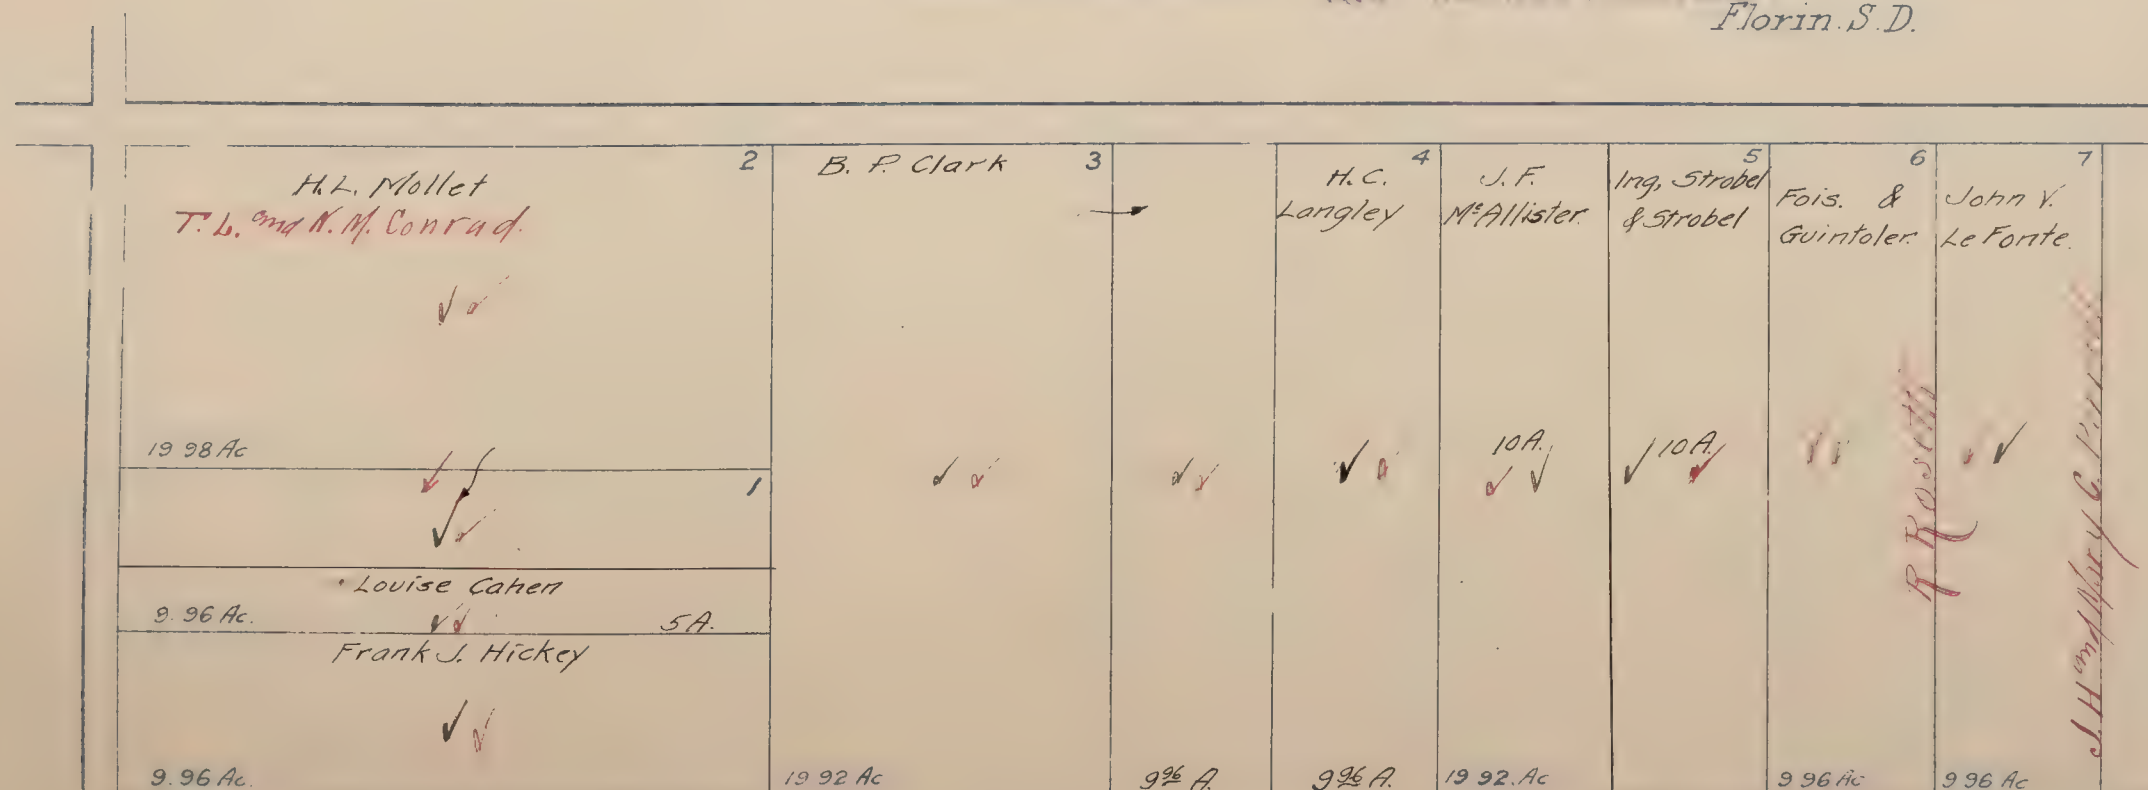

SUNNYSIDE

located in
Sec. 20 T. 8 N. R. 5 E.
Scale 1" = 60'

Black Ink - 1919 Ownership
Red Ink - 1920 Ownership


*W. H. K. 10.
G. H. 12.*

1/2 of the Sub No. 77

Blanks assessed to *Camille P White*
(T. A. Harrell)

VINE

ST

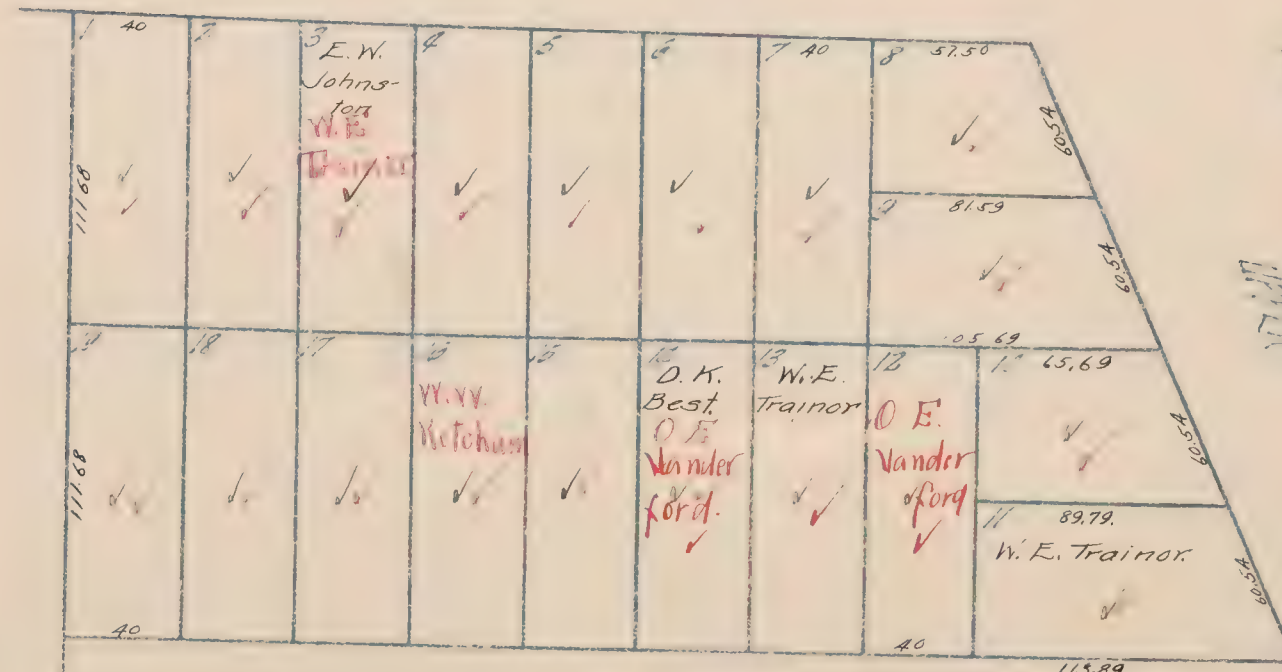

ELLIOT

AVE



CLAIRE

AVE

Mapped.

SUTTER HEIGHTS


SECTION 14 T4N R5E

Scale 60 feet = 1 inch

Black Ink - 1919 Ownership
Red Ink - 1939 Ownership

Fruit Ridge
Grove

Blanks assessed to S. Stone ✓
Calif. Natl. Bank

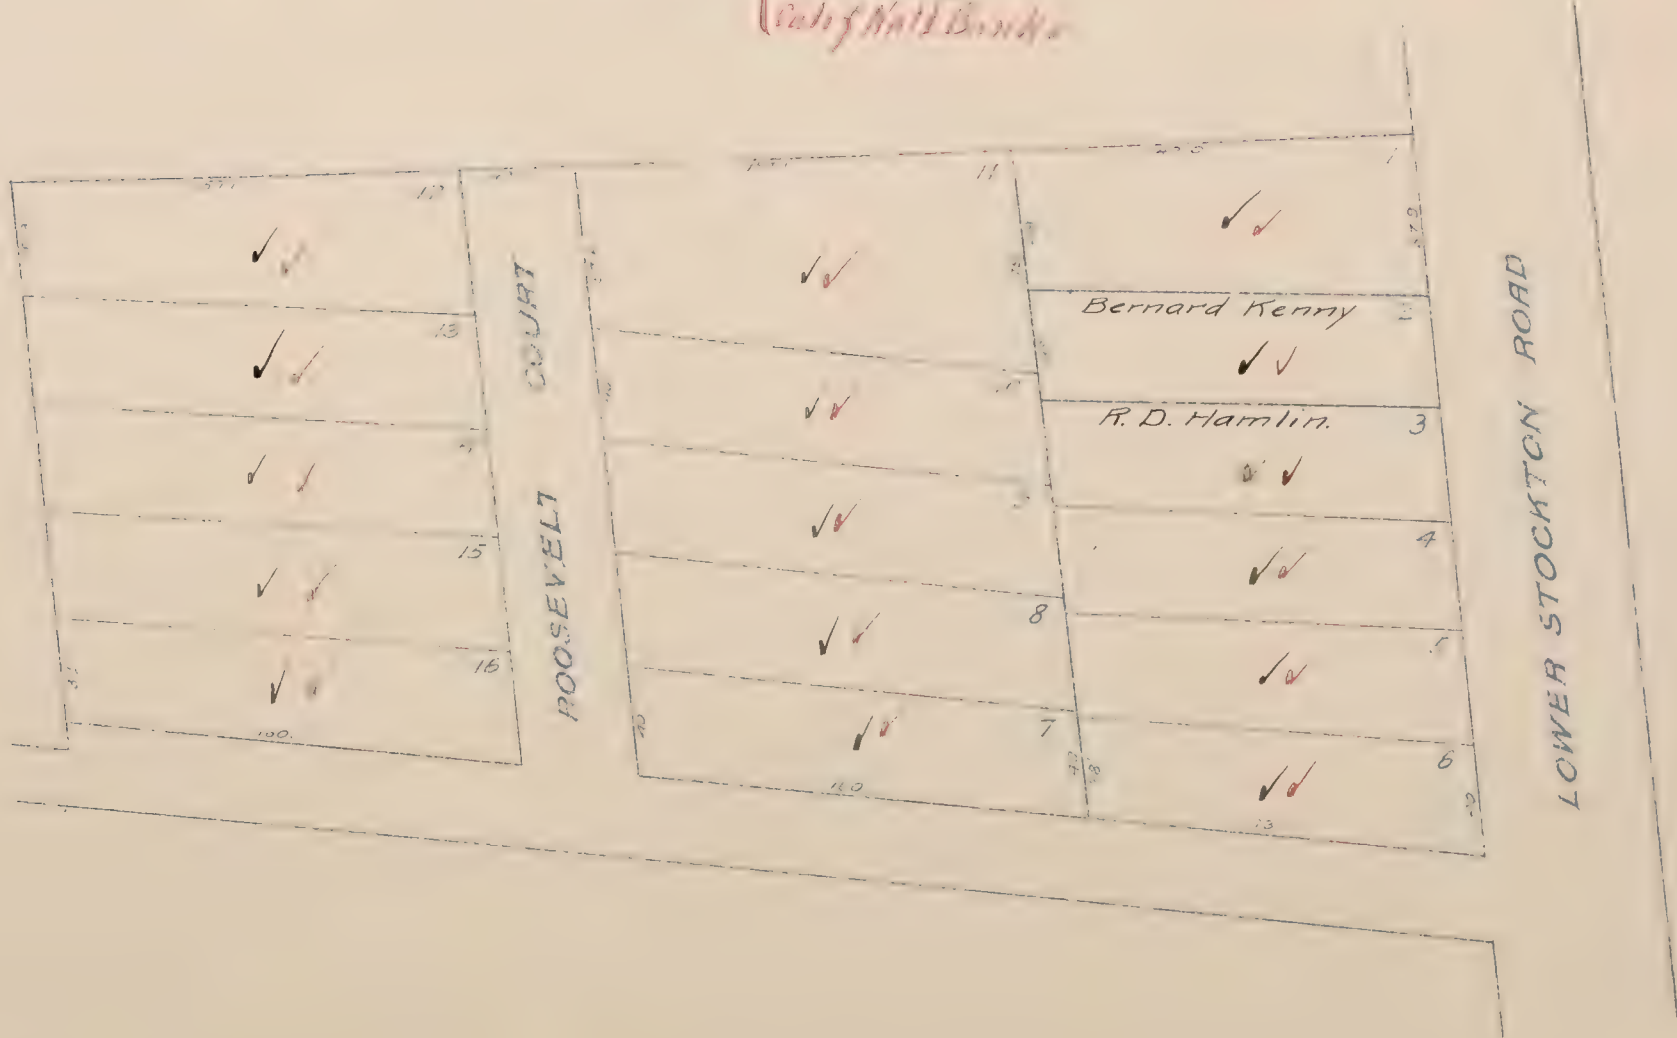

Maped


SUTTERVILLE HEIGHTS TRACT.

LOCATED IN
SECTIONS 23 & 24 T. 8 N. R. 5 E

Scale 4 chains = 1 inch

Black Ink-1919 Ownership
Red Ink-1920 Ownership

Wm. H. Sutter S.D.

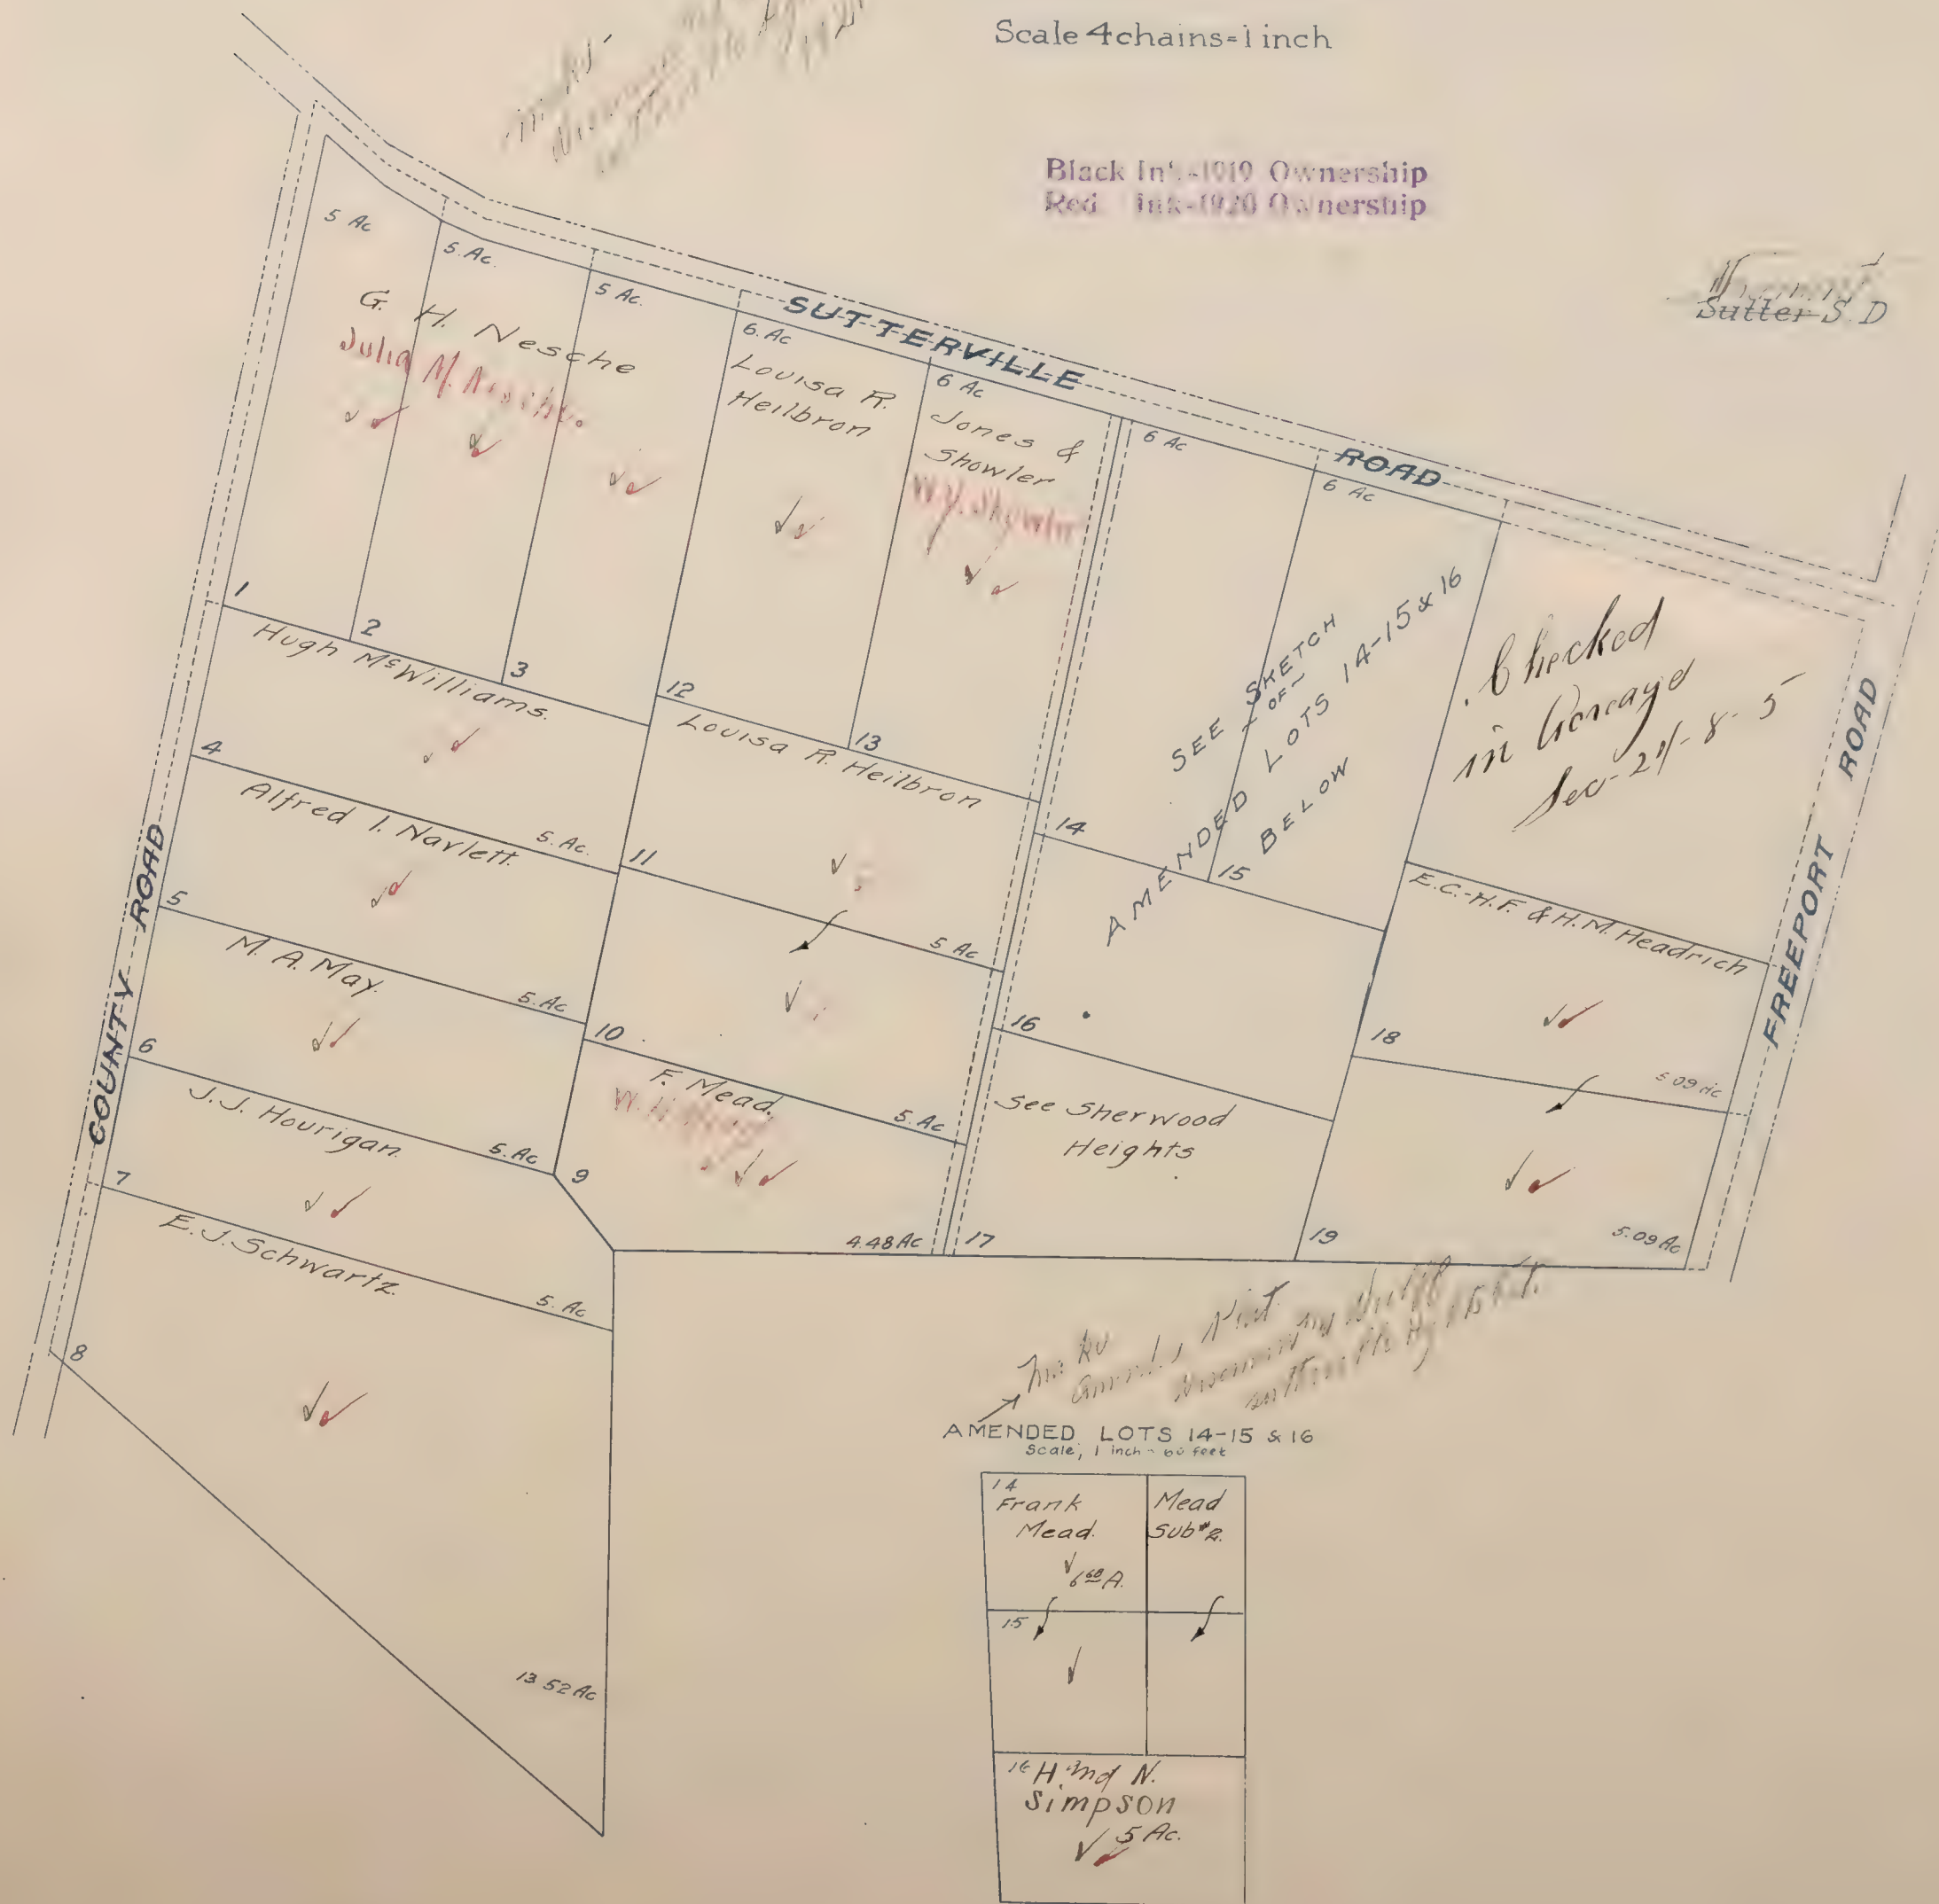


Mapped.

Black Ink-1919 Ownership
Red Ink-1920 Ownership

SWISLER TRACT

LOCATED IN
Sec's 13, 14, & 15 T. 7N R. 5E.
Scale: 800' = 1" Jackson SD.

Blanks assessed to S.D. Seavey ✓✓
All Lots 10 Acres except where otherwise noted.

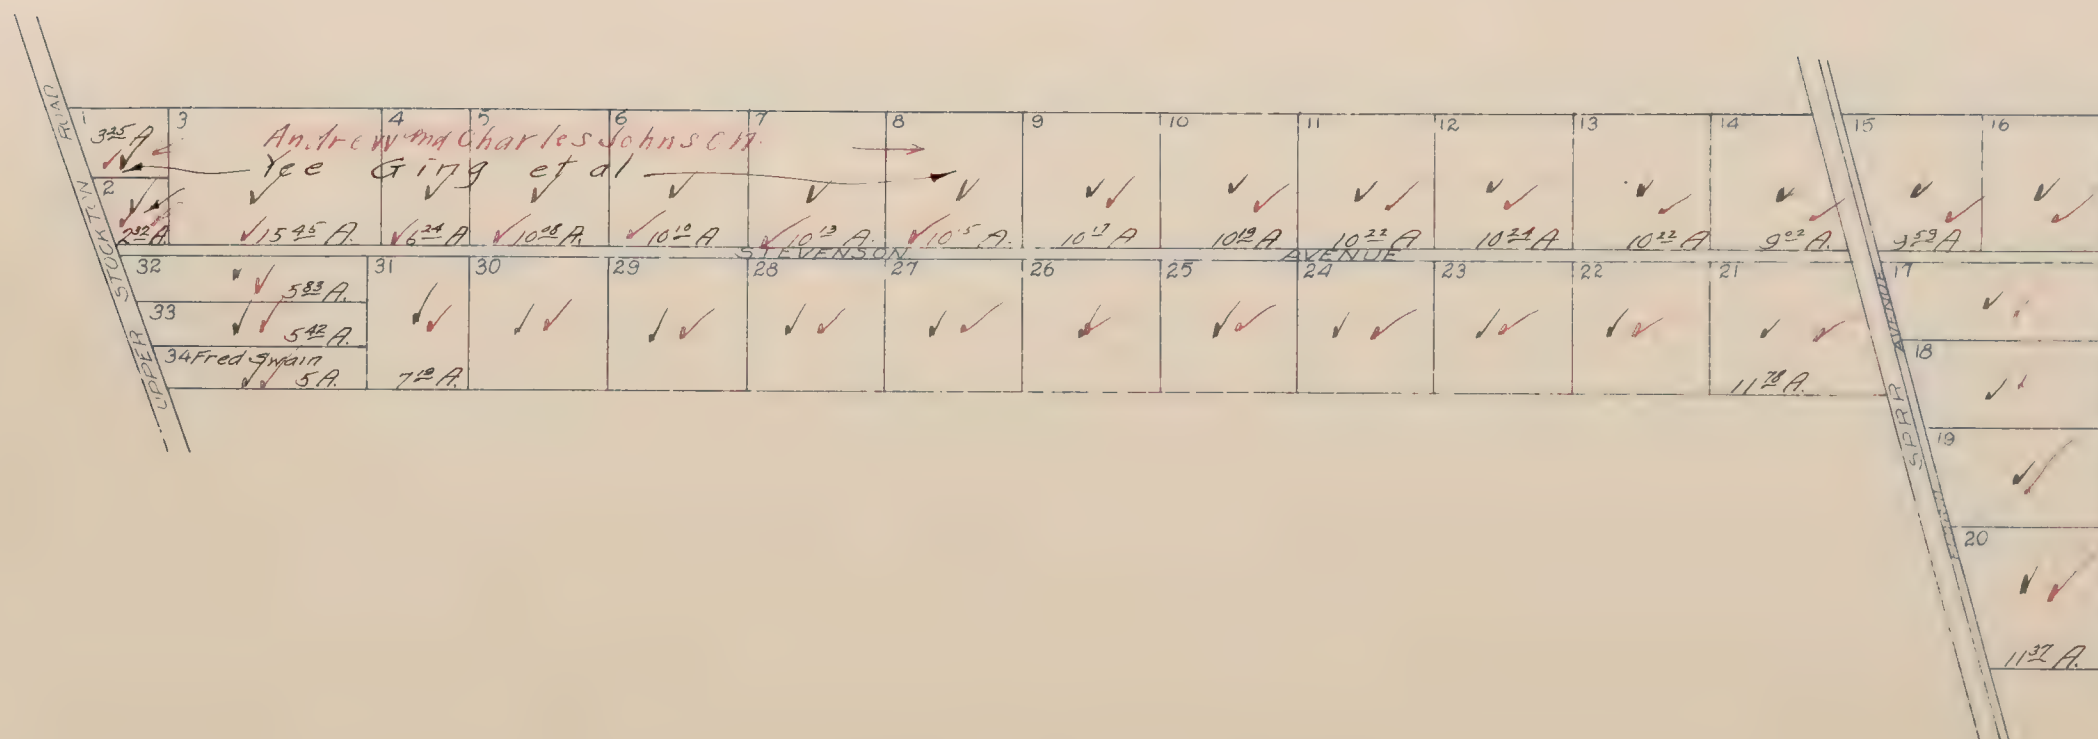

Blanks to J. H. Atkins. ✓

TERMINAL

T

Mapped.

Black Ink-1919 Ownership
Red Ink-1920 Ownership

TOKAY COLONY

LOCATED IN
Sections 13 & 14 T.7 N. R. 5 E.
Scale: 1 inch = 4 chains

Blanks assessed to C.M. Goethe ✓

Jackson S.D.

All Lots 10 Acres, except where otherwise noted.

9 Carl Huber & Chas. K. Baldwin. ✓✓ 7 ¹² A		10 ✓✓ 9 ¹² A
8 ✓✓ 7 ¹² A		11 Chris Malos Grand & Criviano. ✓✓
7 ✓✓		12 ✓✓
6 ✓✓		13 ✓✓
5 Martin Weckerly ✓✓	4 ✓✓	3 ✓✓
		2 ✓✓
		1 ✓✓
	SCHOOL HOUSE	


TOKAY MEADOWS

located in
Section 30 T4N R02E
Scale 1"=200'

Black Ink-1910 Ownership
Red Ink-1975 Ownership

Sheet 60

Blanks assessed to Annie F. Peterson ✓

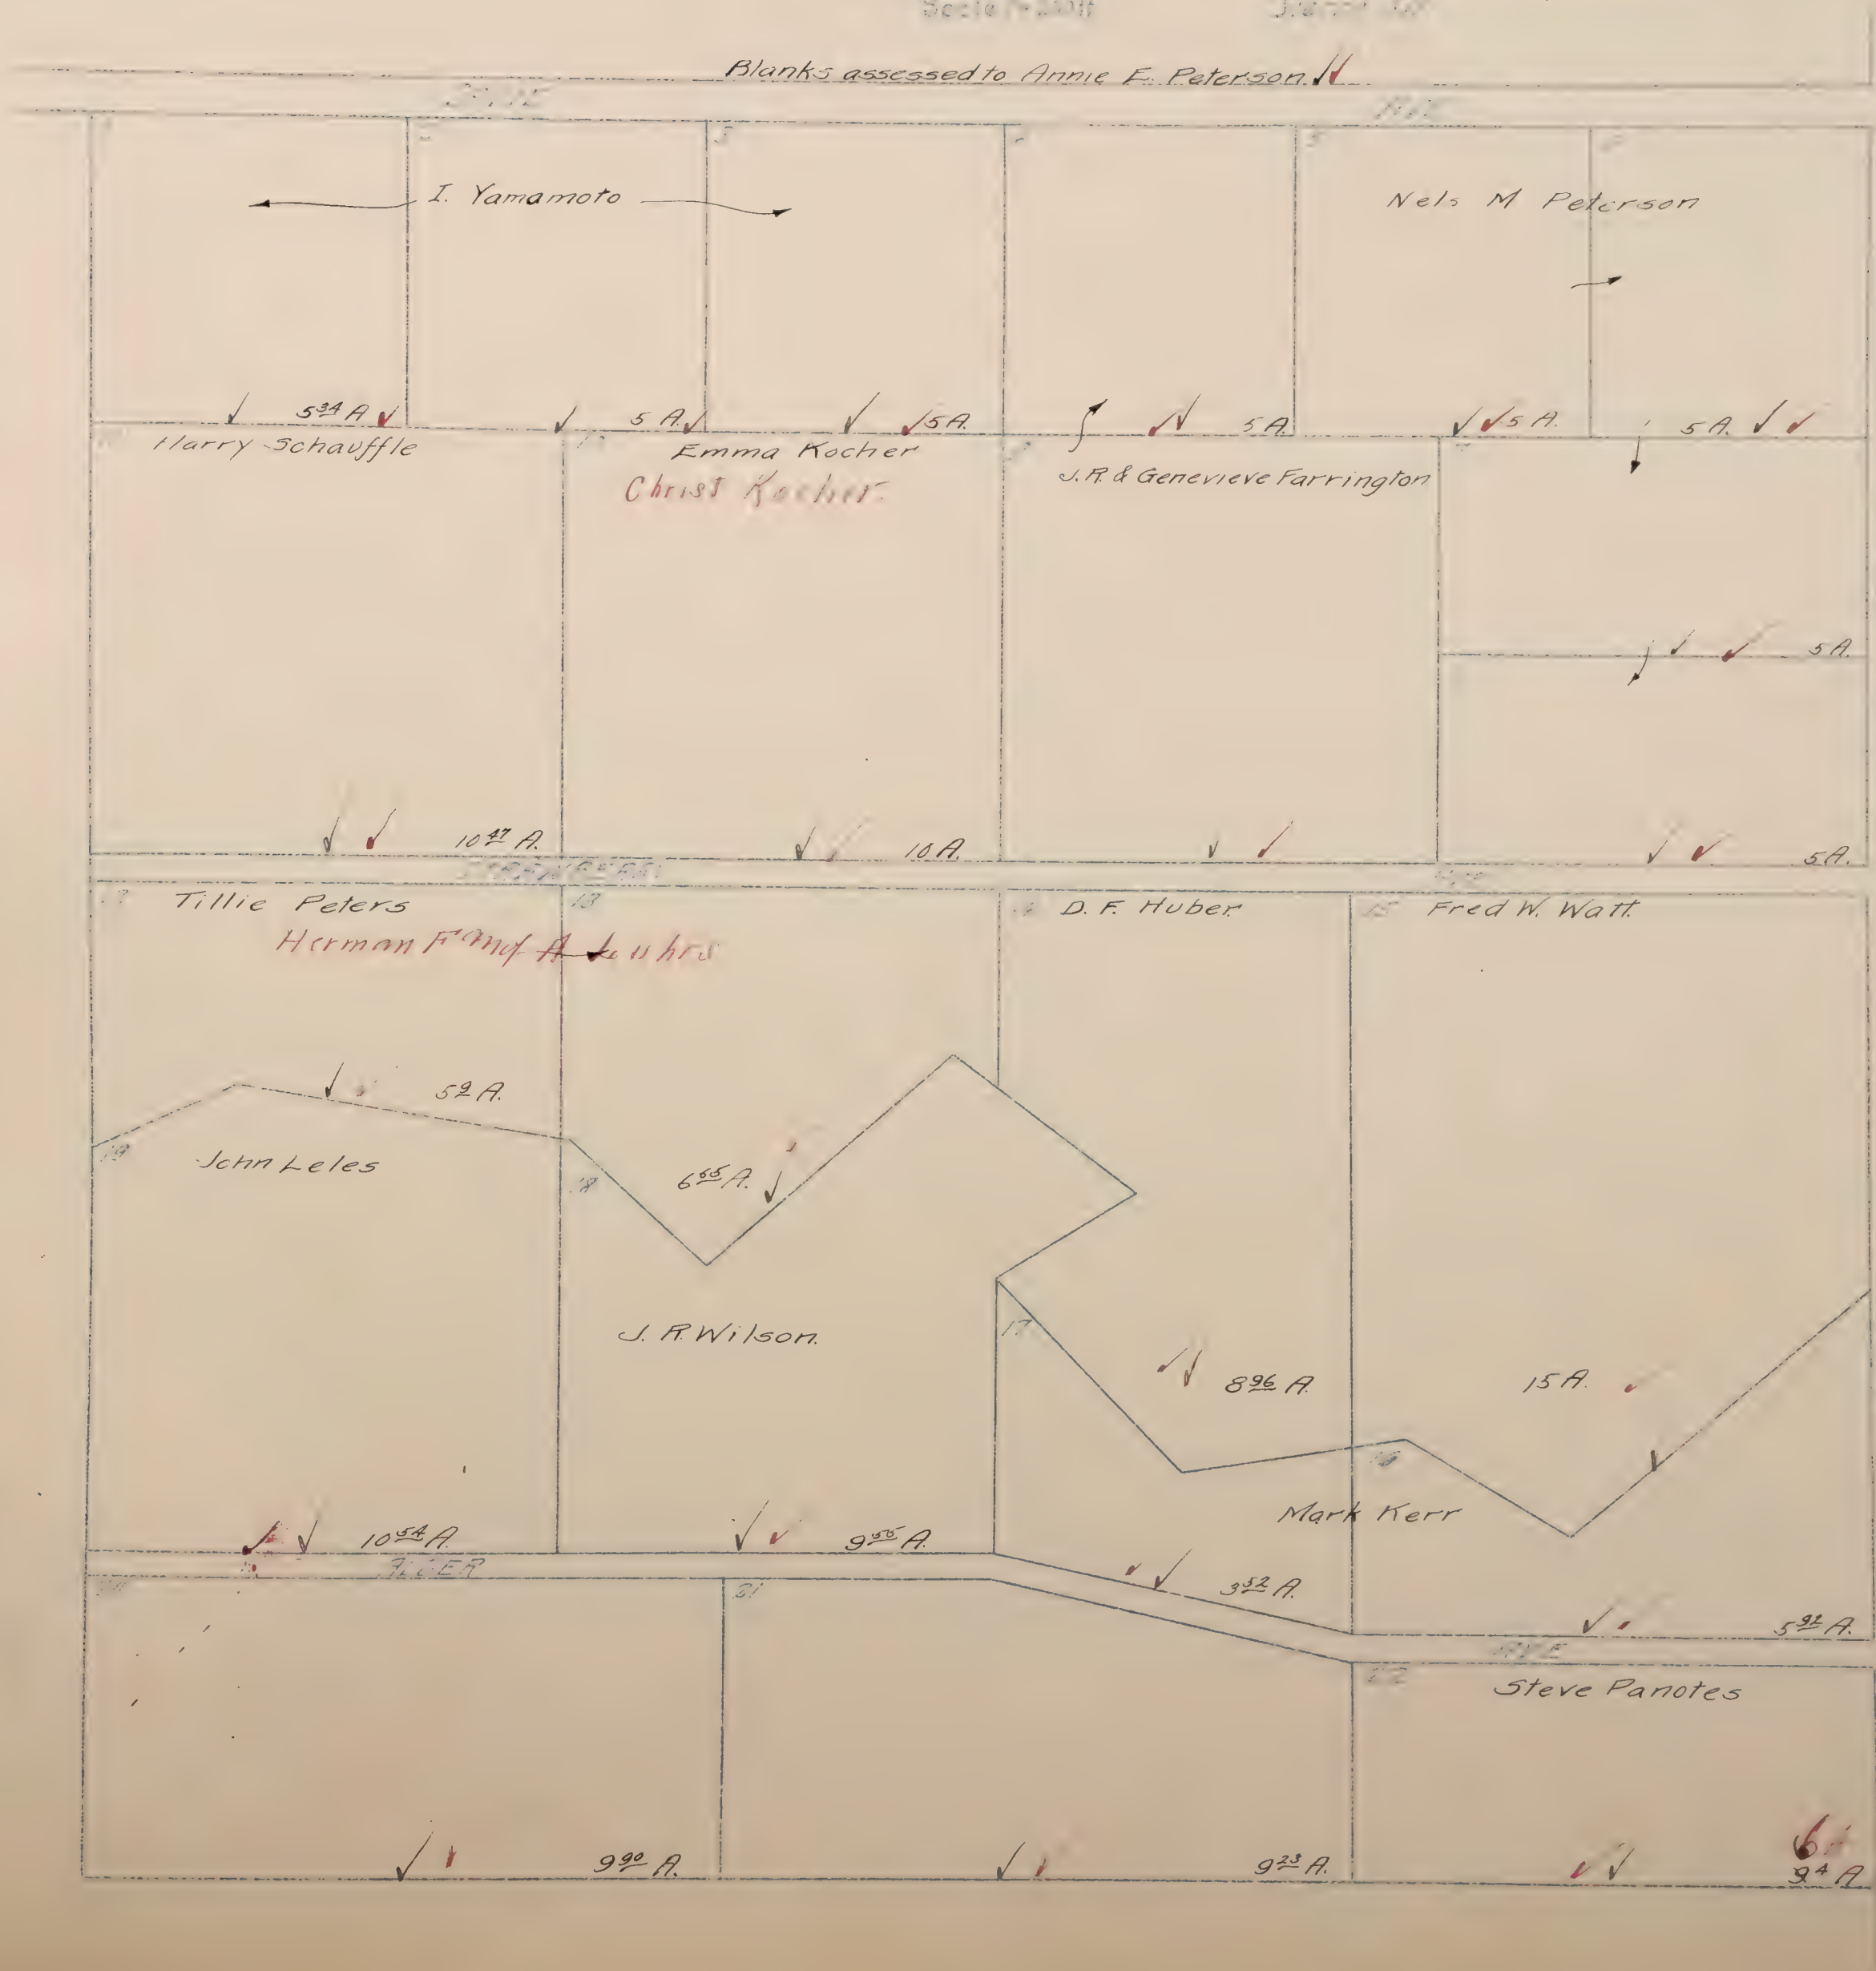

Black Ink-1919 Ownership
Red Ink-1920 Ownership

TRACTION ADDITION

BEING

Lots 2816 & 2817 Sacramento Heights

LOCATED IN

N.E. 1/4 of Sec. 20, T. 8 N. R. 5 E.

Scale: 1" = 60'

Fruit Ridge, I.D.
Blanks assessed to B.F. Driver. ✓

PARKER				AVENUE				
SUTTER	AVENUE		2	19	20	21	22	PARKER AVENUE TRACT
		✓	✓	✓	✓	✓	✓	
		3		18		23		
		4		17		24		
		5		16		25		
		6		15		26		
		7		14		27		
		8		13		28		
		9	10	11	12	29	30	
		✓	✓	✓	✓	✓	✓	
ROOSEVELT				AVENUE				

Mapped.

Black Ink-1919 Ownership
Red Ink-1929 Ownership


TWIN CITIES COLONY No 2

LOCATED IN THE
N $\frac{1}{2}$ of Sec. 13, T5N, R.6E
Scale: 400' = 1"

NW COR SEC. 13

Blanks to Alexander Marengo.

Twin Cities S.D.

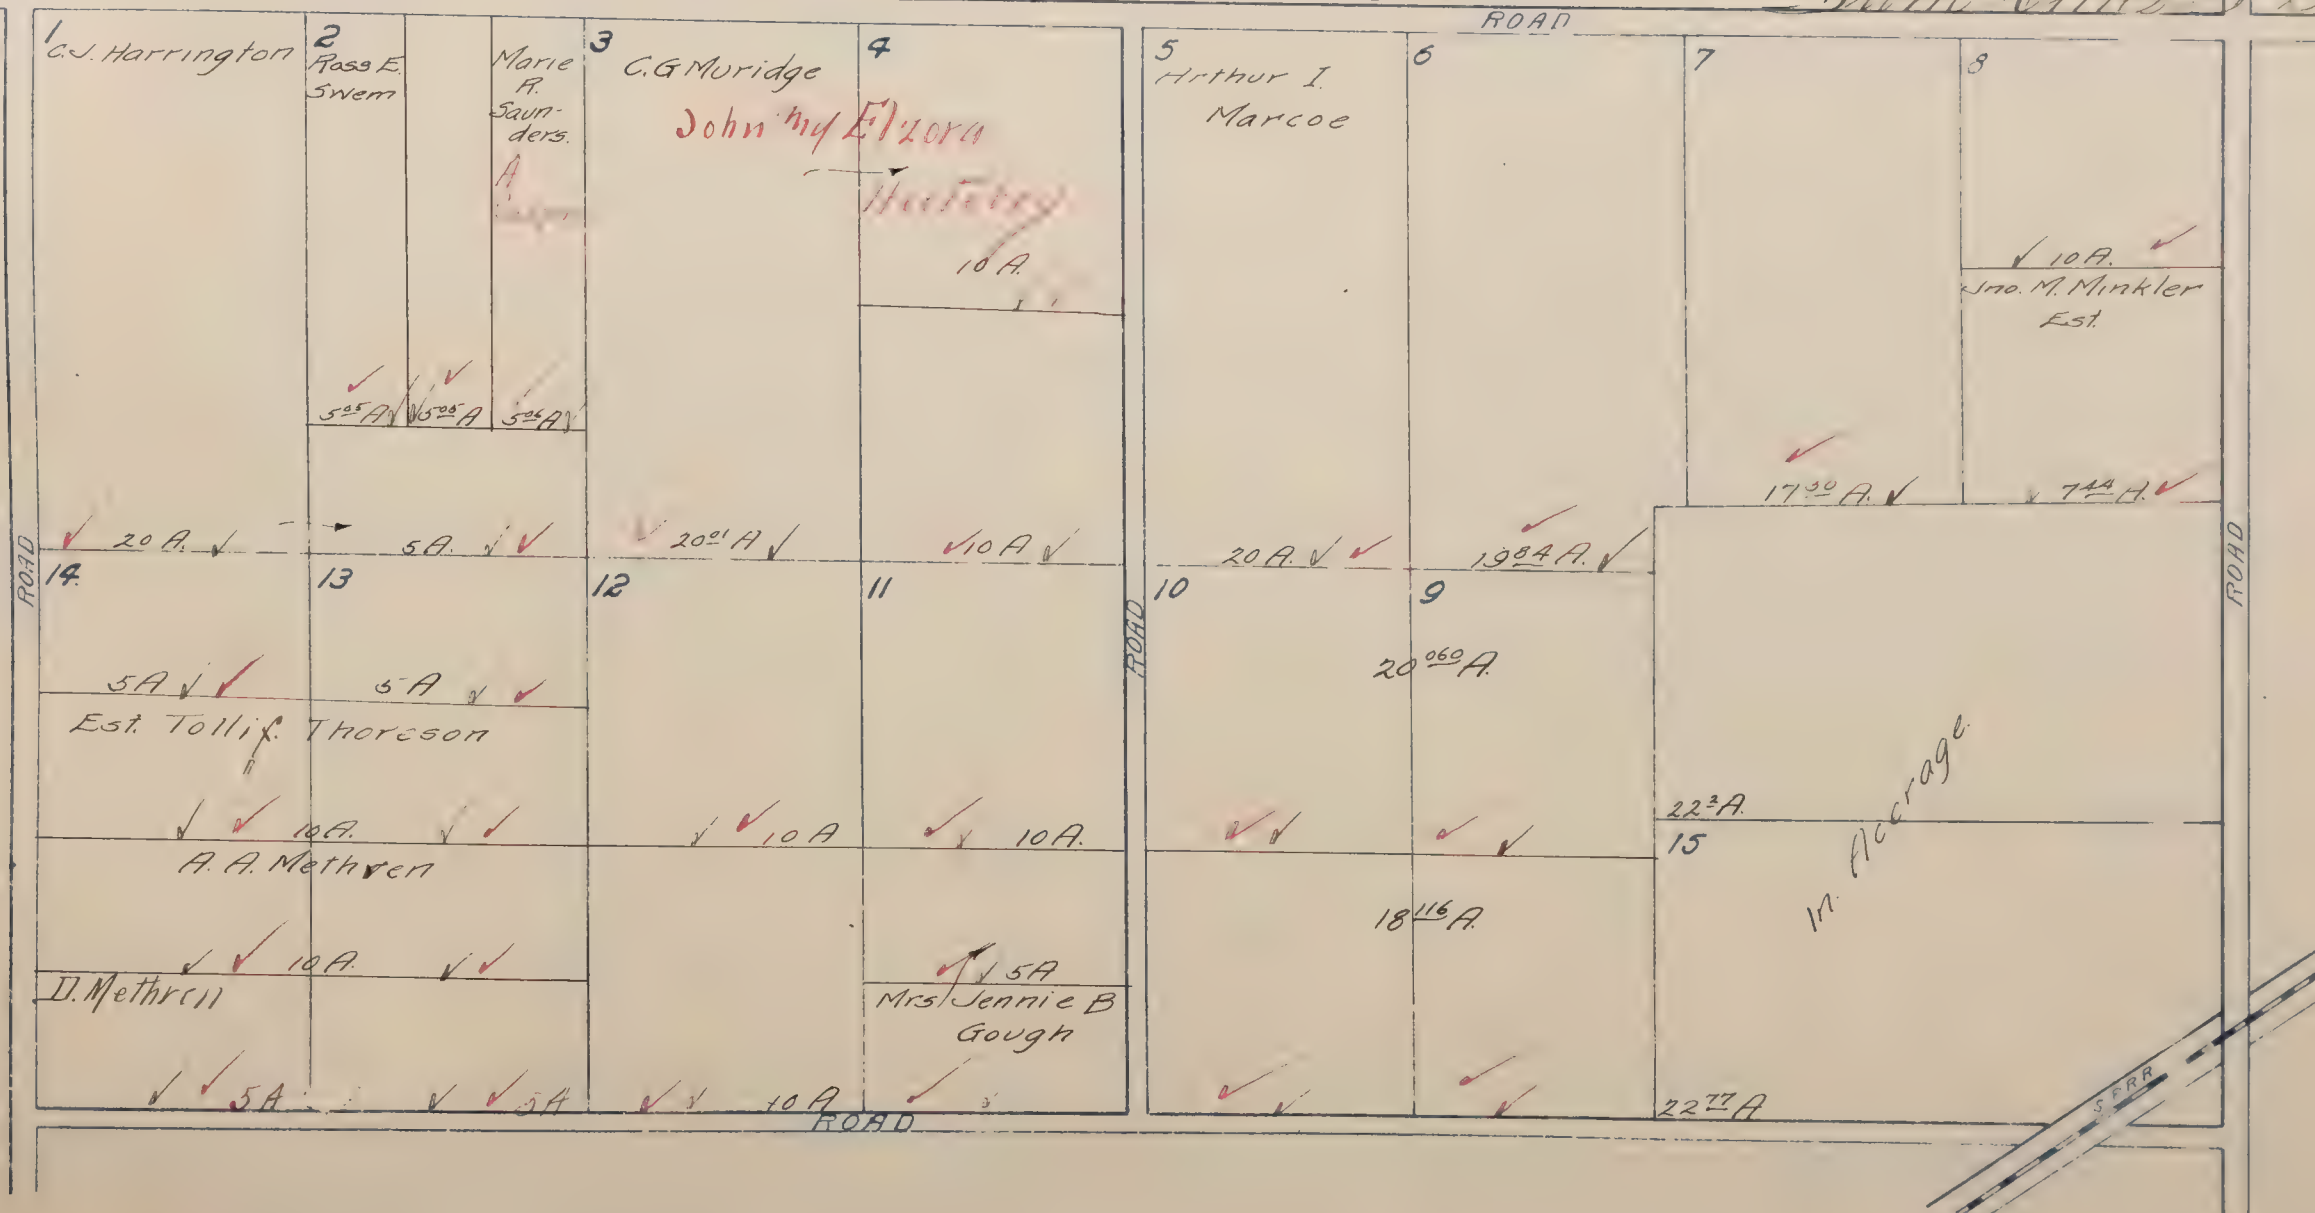

Twin Cities

Black Ink-1919 Ownership
Red Ink-1920 Ownership

TWIN CITIES COLONY No 3


BEING

Sec. 18, T. 5N., R. 7E.

Scale: 400' = 1"

Blairama S.D.

Blanksto.
L.L. & T. L. Quiggle & C.B. Baltimore & M. M. Warren 1920

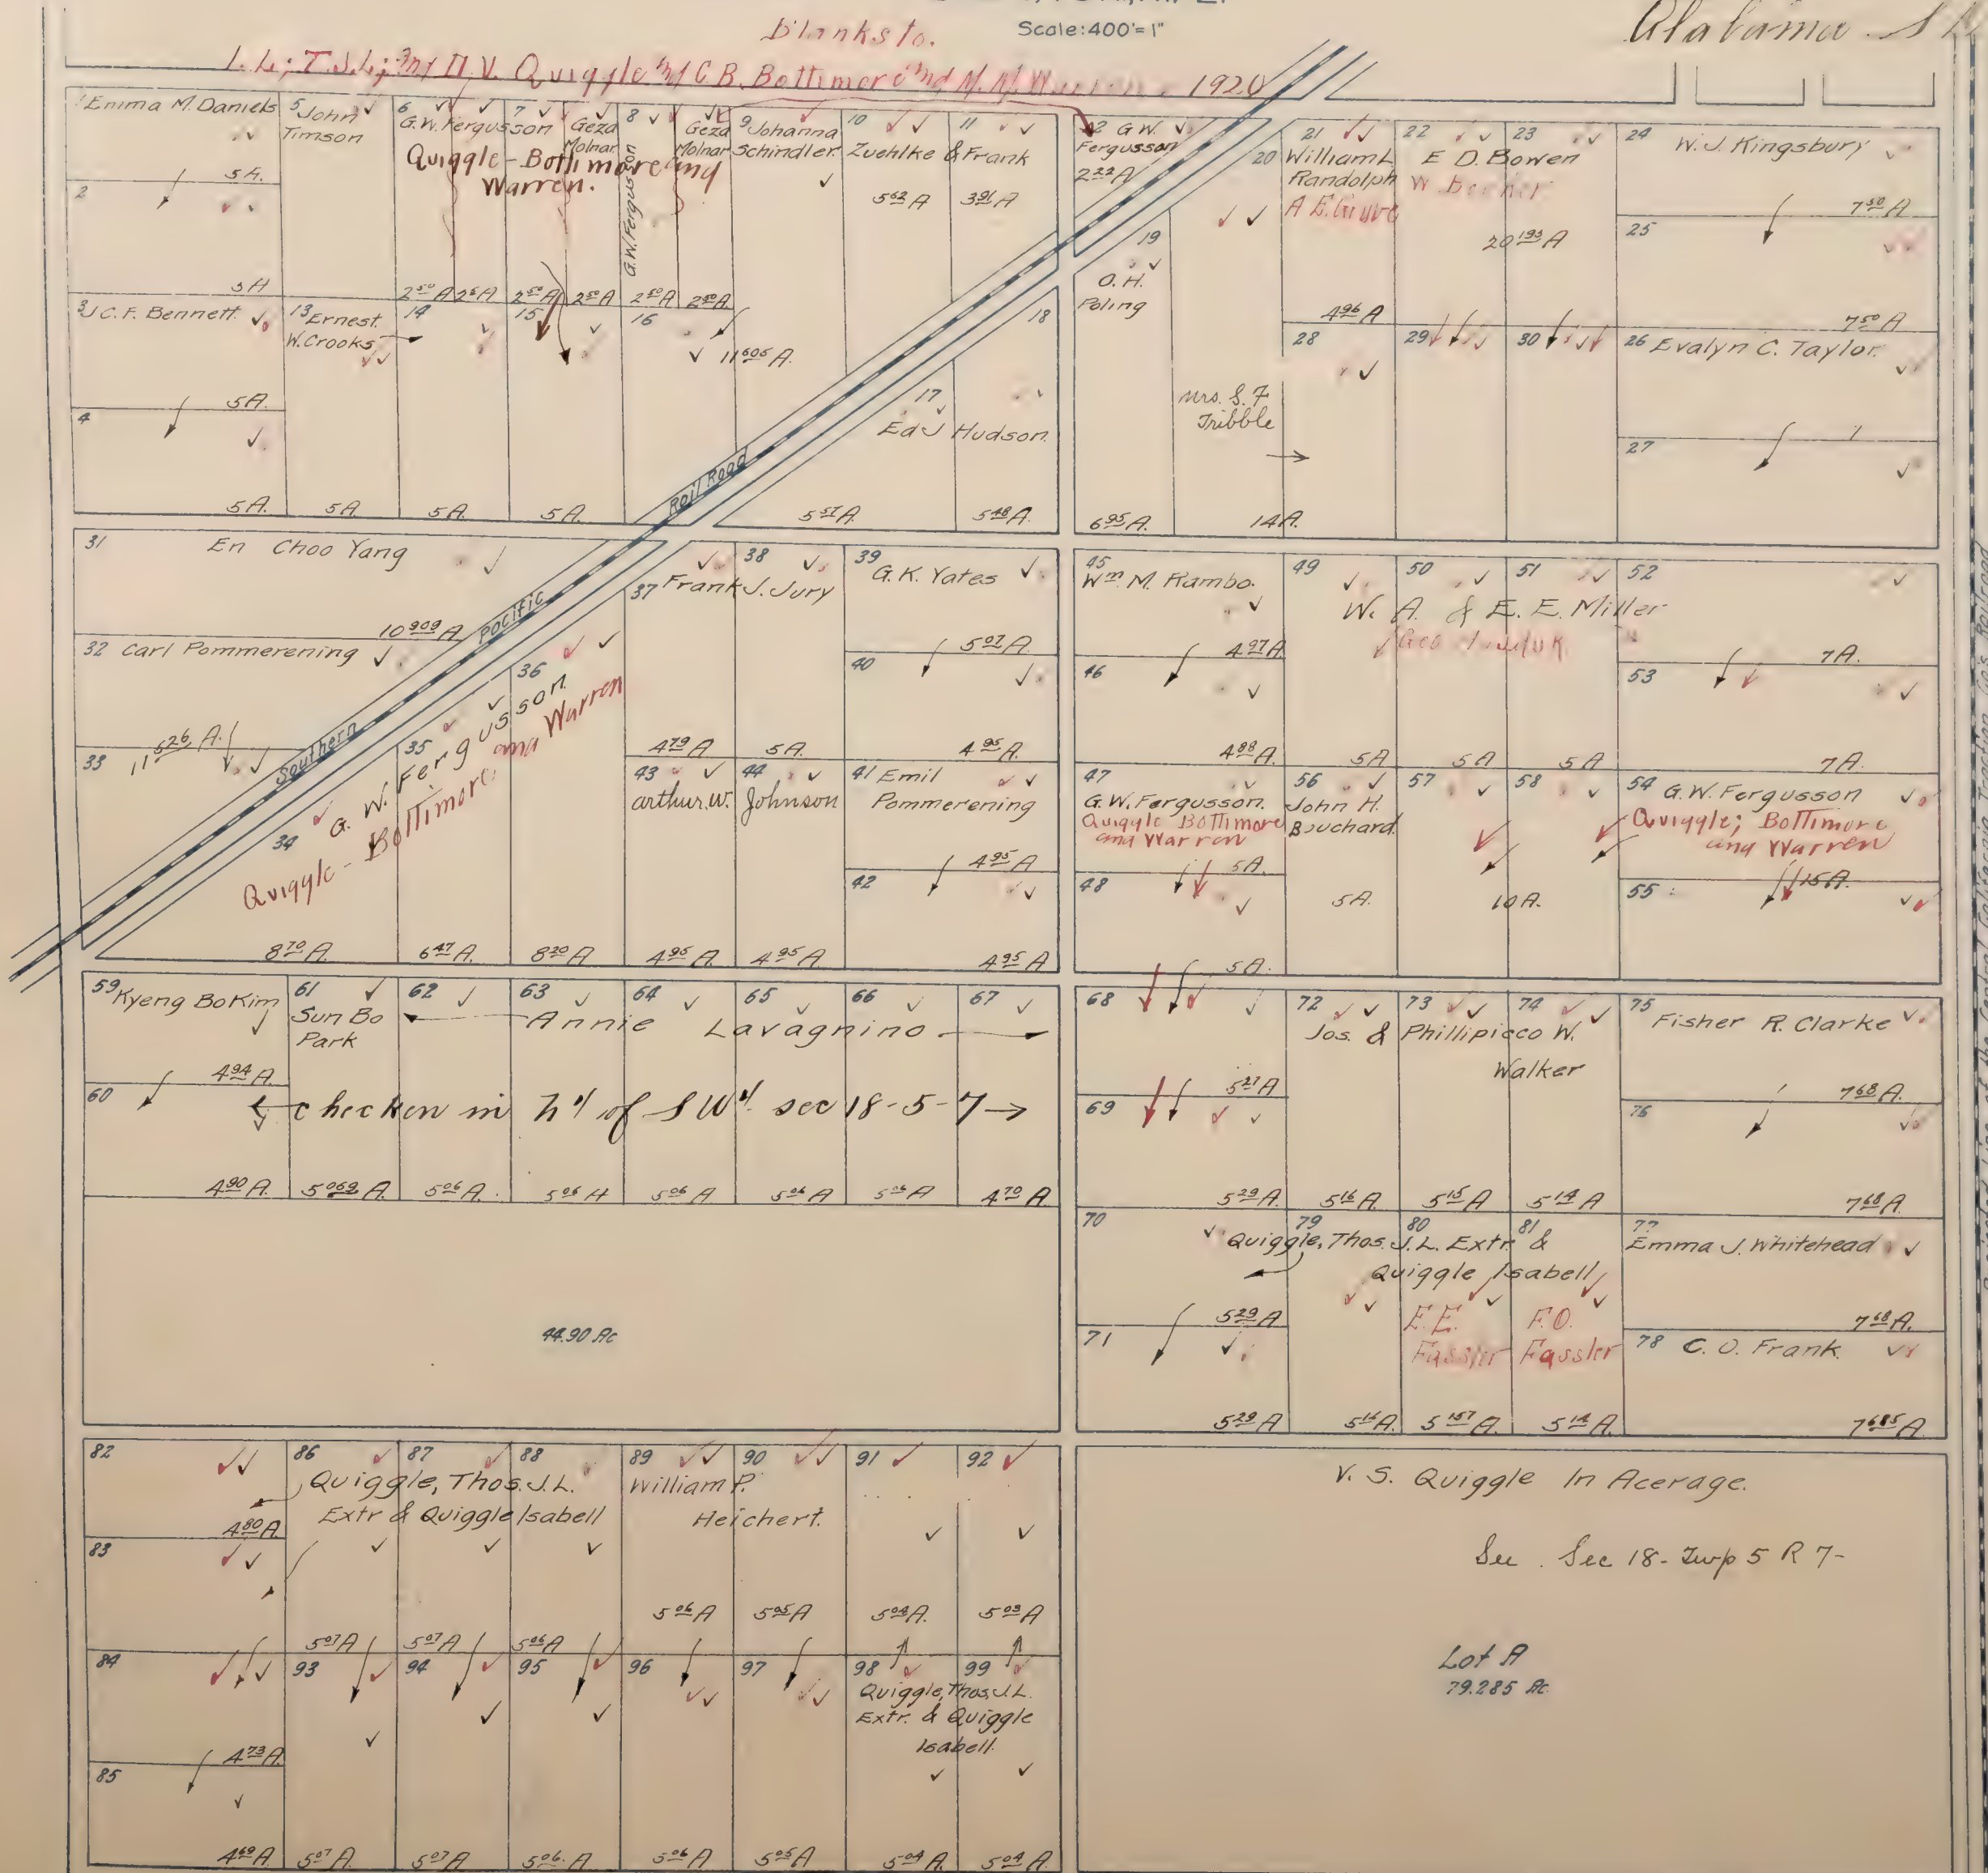

Mapped.

Black Ink-1919 Ownership
Red Ink-1920 Ownership

Blanks to Golden Valley Land Co.
All Lots 10 Acres unless otherwise noted

VALENSIN COLONY

LOCATED IN

Arno, Alameda, Colony S.D.

Subs. 2, 3, 4, 999, 1000

11 ²⁵ A. 28	11 ²⁷ A. 27	11 ²⁷ A. 26	11 ²⁷ A. 25	11 ²⁷ A. 24	11 ²⁷ A. 23	11 ²⁷ A. 22	11 ²⁷ A. 21	11 ²⁷ A. 20	11 ²⁸ A. 19
10 ²⁵ A. 29	10 ²⁵ A. 28	10 ²⁵ A. 27	10 ²⁵ A. 26	10 ²⁵ A. 25	10 ²⁵ A. 24	10 ²⁵ A. 23	10 ²⁵ A. 22	10 ²⁵ A. 21	10 ²⁵ A. 20
10 ²⁶ A. 41	10 ²⁶ A. 40	10 ²⁶ A. 39	10 ²⁶ A. 38	10 ²⁶ A. 37	10 ²⁶ A. 36	10 ²⁶ A. 35	10 ²⁶ A. 34	10 ²⁶ A. 33	10 ²⁶ A. 32
8 ²⁵ A. 49	8 ²⁵ A. 50	8 ²⁵ A. 51	8 ²⁵ A. 52	8 ²⁵ A. 53	8 ²⁵ A. 54	8 ²⁵ A. 55	8 ²⁵ A. 56	8 ²⁵ A. 57	8 ²⁵ A. 58

Arno. S.D.

Colony S.D.

Chas. F. & May Gilbert.	17 ²⁵ A. 81	17 ²⁵ A. 80	17 ²⁵ A. 79	17 ²⁵ A. 78	17 ²⁵ A. 77	16 ²⁵ A. 76	16 ²⁵ A. 75	16 ²⁵ A. 74	16 ²⁵ A. 73
Norman E. Hubbard	105	106	107	108	109	110	111	112	113
Robert B. Davy	126	125	124	123	122	121	120	119	118
Harry E. Barton	149	150	151	152	153	154	155	156	157
H.R. Reynolds	170	169	168	167	166	165	164	163	162

VALENSIN

Black Ink-199 Ownership
Red Ink-1920 Ownership

VALENSIN COLONY

LOCATED IN
SEC'S 35 & 36 T6N R6E
Scale 1" = 600'

A + H₂O = D.

Blanks to Golden Valley Land Co.
All Lots 1 Acre unless otherwise marked

Baker & Wade	Annie Veach					Nathan Basin									
✓	✓	✓	✓	✓	✓	✓	✓	✓	✓	✓	✓	✓	✓	✓	✓
1896 A 93	1892 A 92	1899 A 91	1898 A 90	1895 A 89	1898 A 88	1893 A 87	1896 A 86	1891 A 85	1894 A 84	1893 A 83	1895 A 82	1891 A 81			
Anna D & Paul J. Ziegler		James & Margaret Dahlstrom													
✓	✓	✓	✓	✓	✓	✓	✓	✓	✓	✓	✓	✓	✓	✓	✓
1044 A 94	95	96	97	98	99	100	101	102	103	104	105	106			
Chas E. Jackson				Charles M Halberstade											
✓	✓	✓	✓	✓	✓	✓	✓	✓	✓	✓	✓	✓	✓	✓	✓
1044 A 137	136	135	134	133	132	131	130	129	128	127	126	125			
	R.C. Hillen		Sadie Cordill	C.L. Shipley											
✓	✓	✓	✓	✓	✓	✓	✓	✓	✓	✓	✓	✓	✓	✓	✓
1027 A 138	139	140	141	142	143	144	145	146	147	148	149	150			
Mary A. Mason				A.E. and H. Dought		John B. Antoniolli	A. Genovese								
✓	✓	✓	✓	✓	✓	✓	✓	✓	✓	✓	✓	✓	✓	✓	✓
151	150	149	148	147	146	145	144	143	142	141	140	139	138	137	136

Black Ink-1919 Ownership
Red Ink-1920 Ownership

VALENSIN TOWNSITE

LOCATED IN
Sec 30 T6N R7E
Scale 133 1/3' = 1"

Colony 50

All Blanks to Golden Valley Land Co. ✓



Black Ink 1919 Ownership
Red Ink 1929 Ownership


VALENSIN TOWNSITE

LOCATED IN
Sec. 30. T.6 N. R. 7 E.

Scale: 1" = 133 1/3'

Blanks to Golden Valley Land Co. ✓


Colony, SD

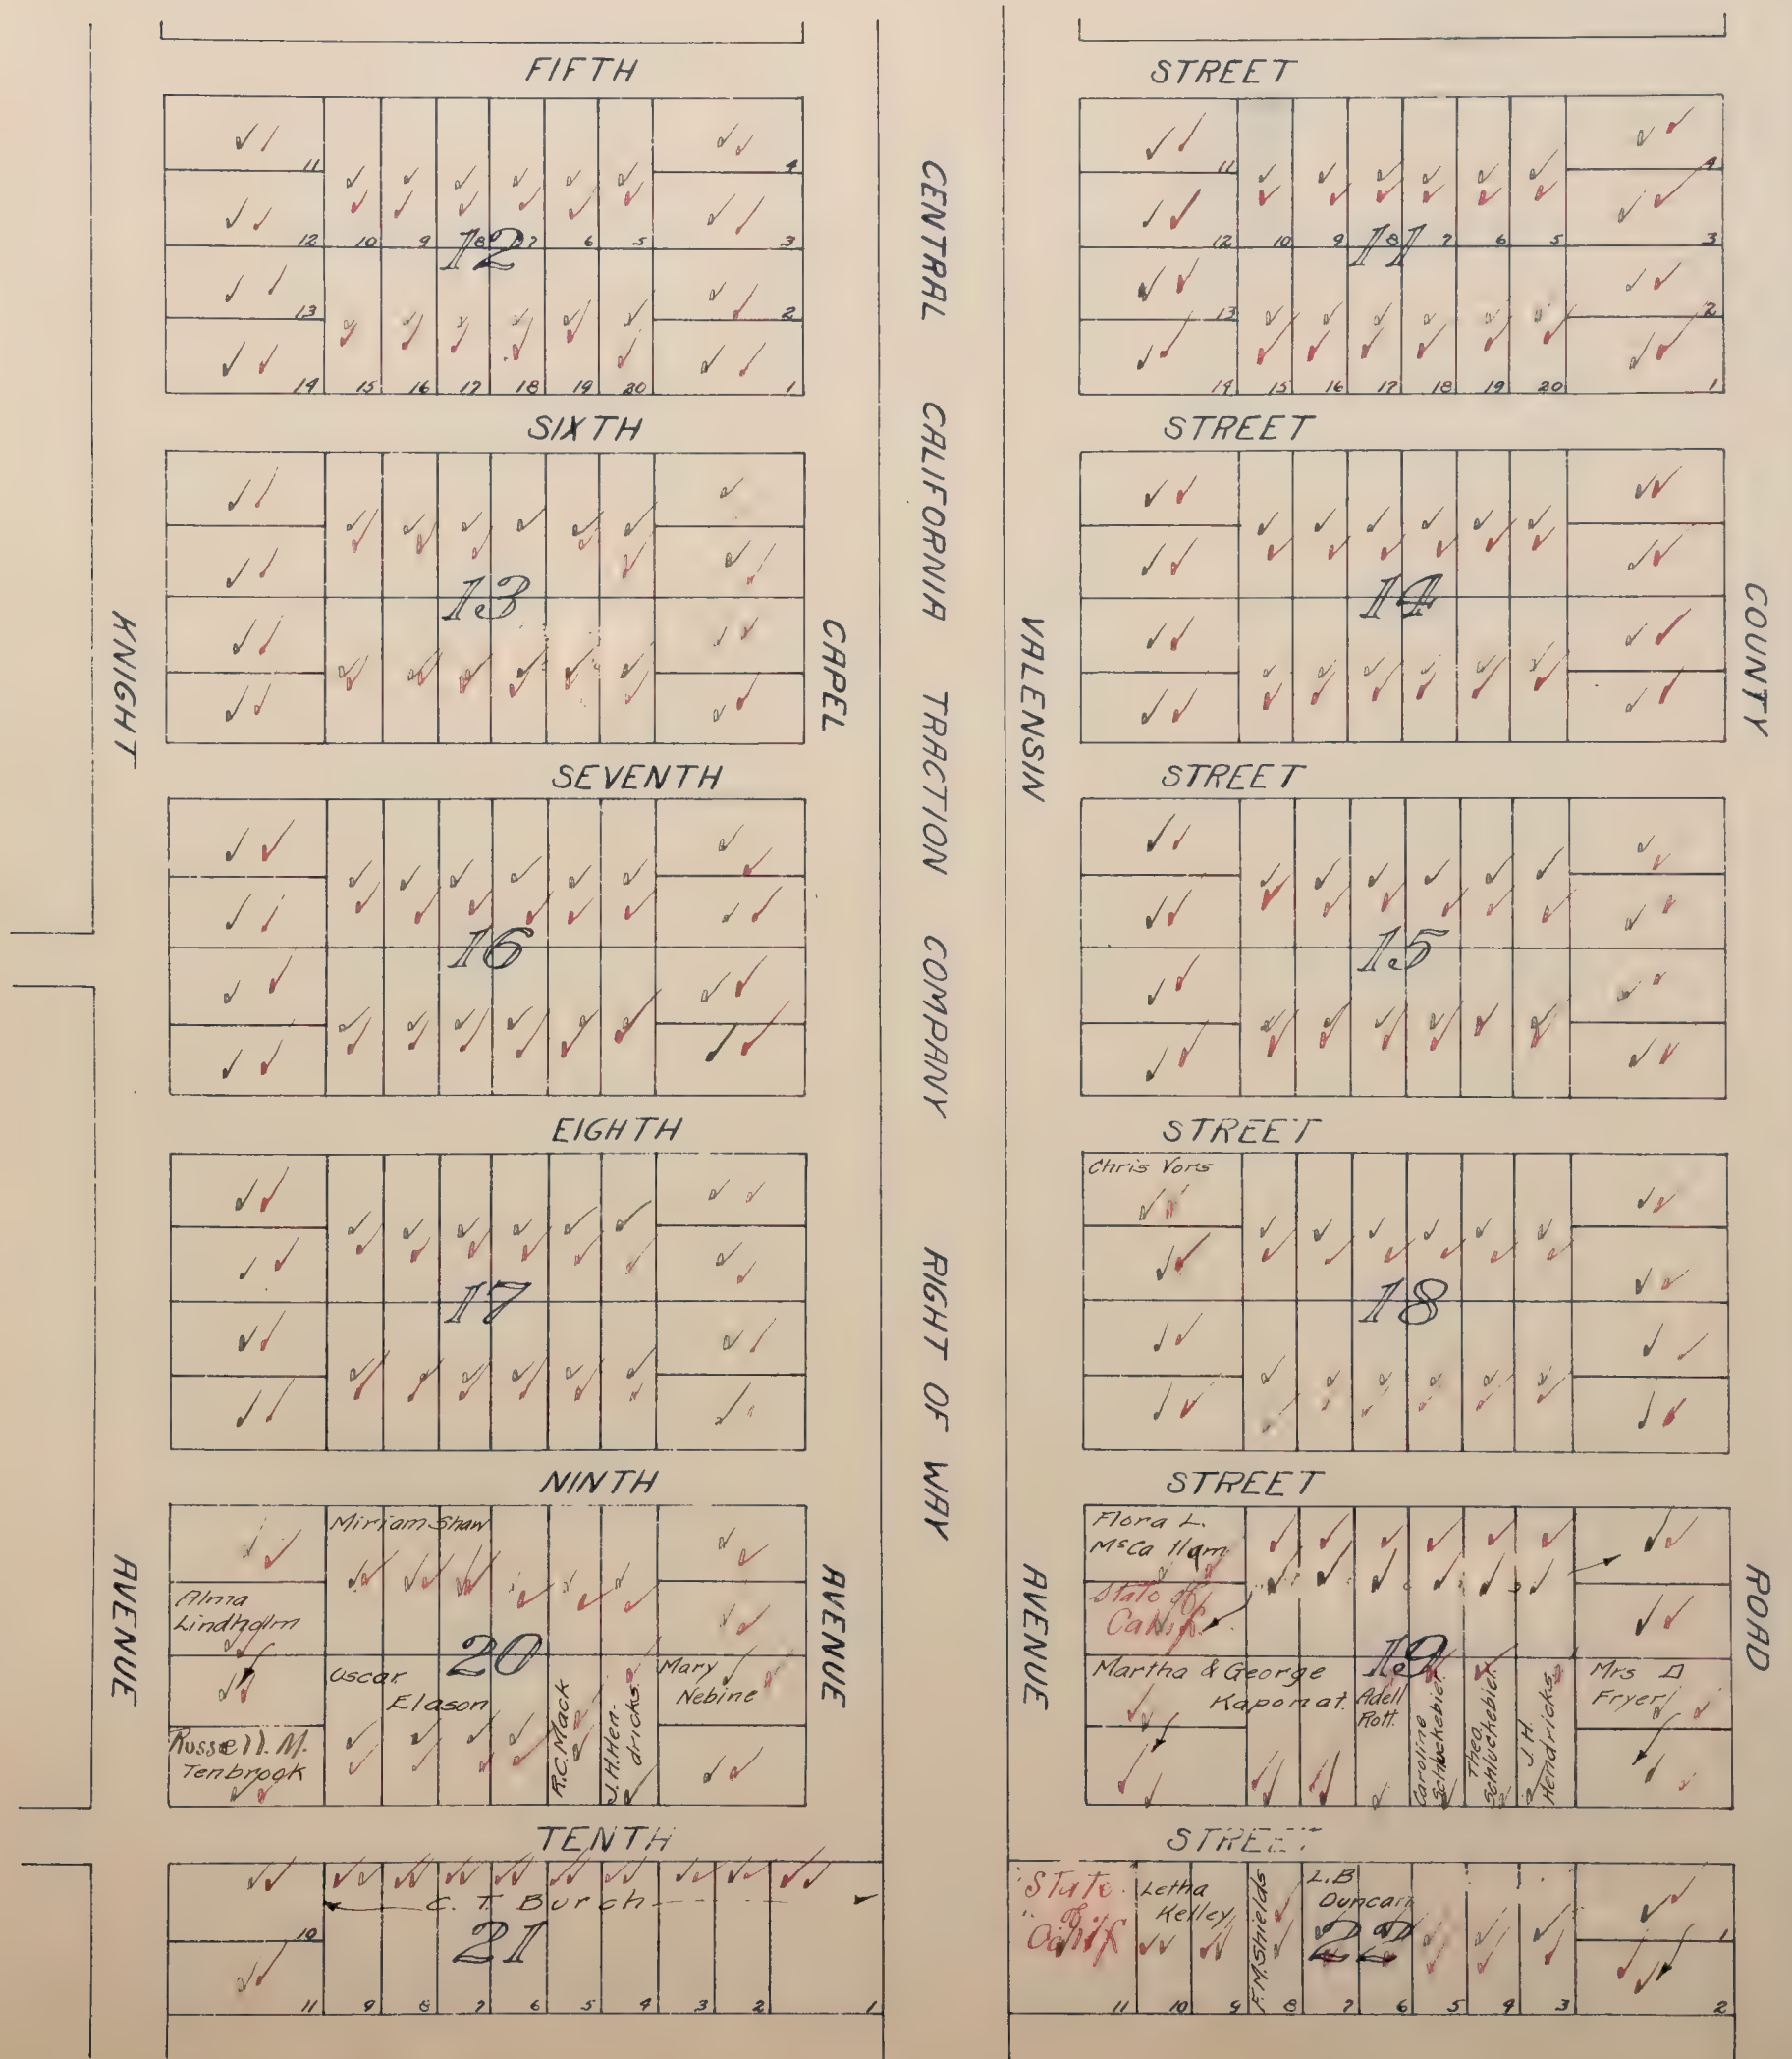

Black Ink-1919 Ownership
Red Ink-1920 Ownership

located near
Galt
Scale 1" = 7 1/2 chs.

Blanks to Harvey Larna Co. ✓ Galt SD.
All Lots 5 Acres unless otherwise noted.

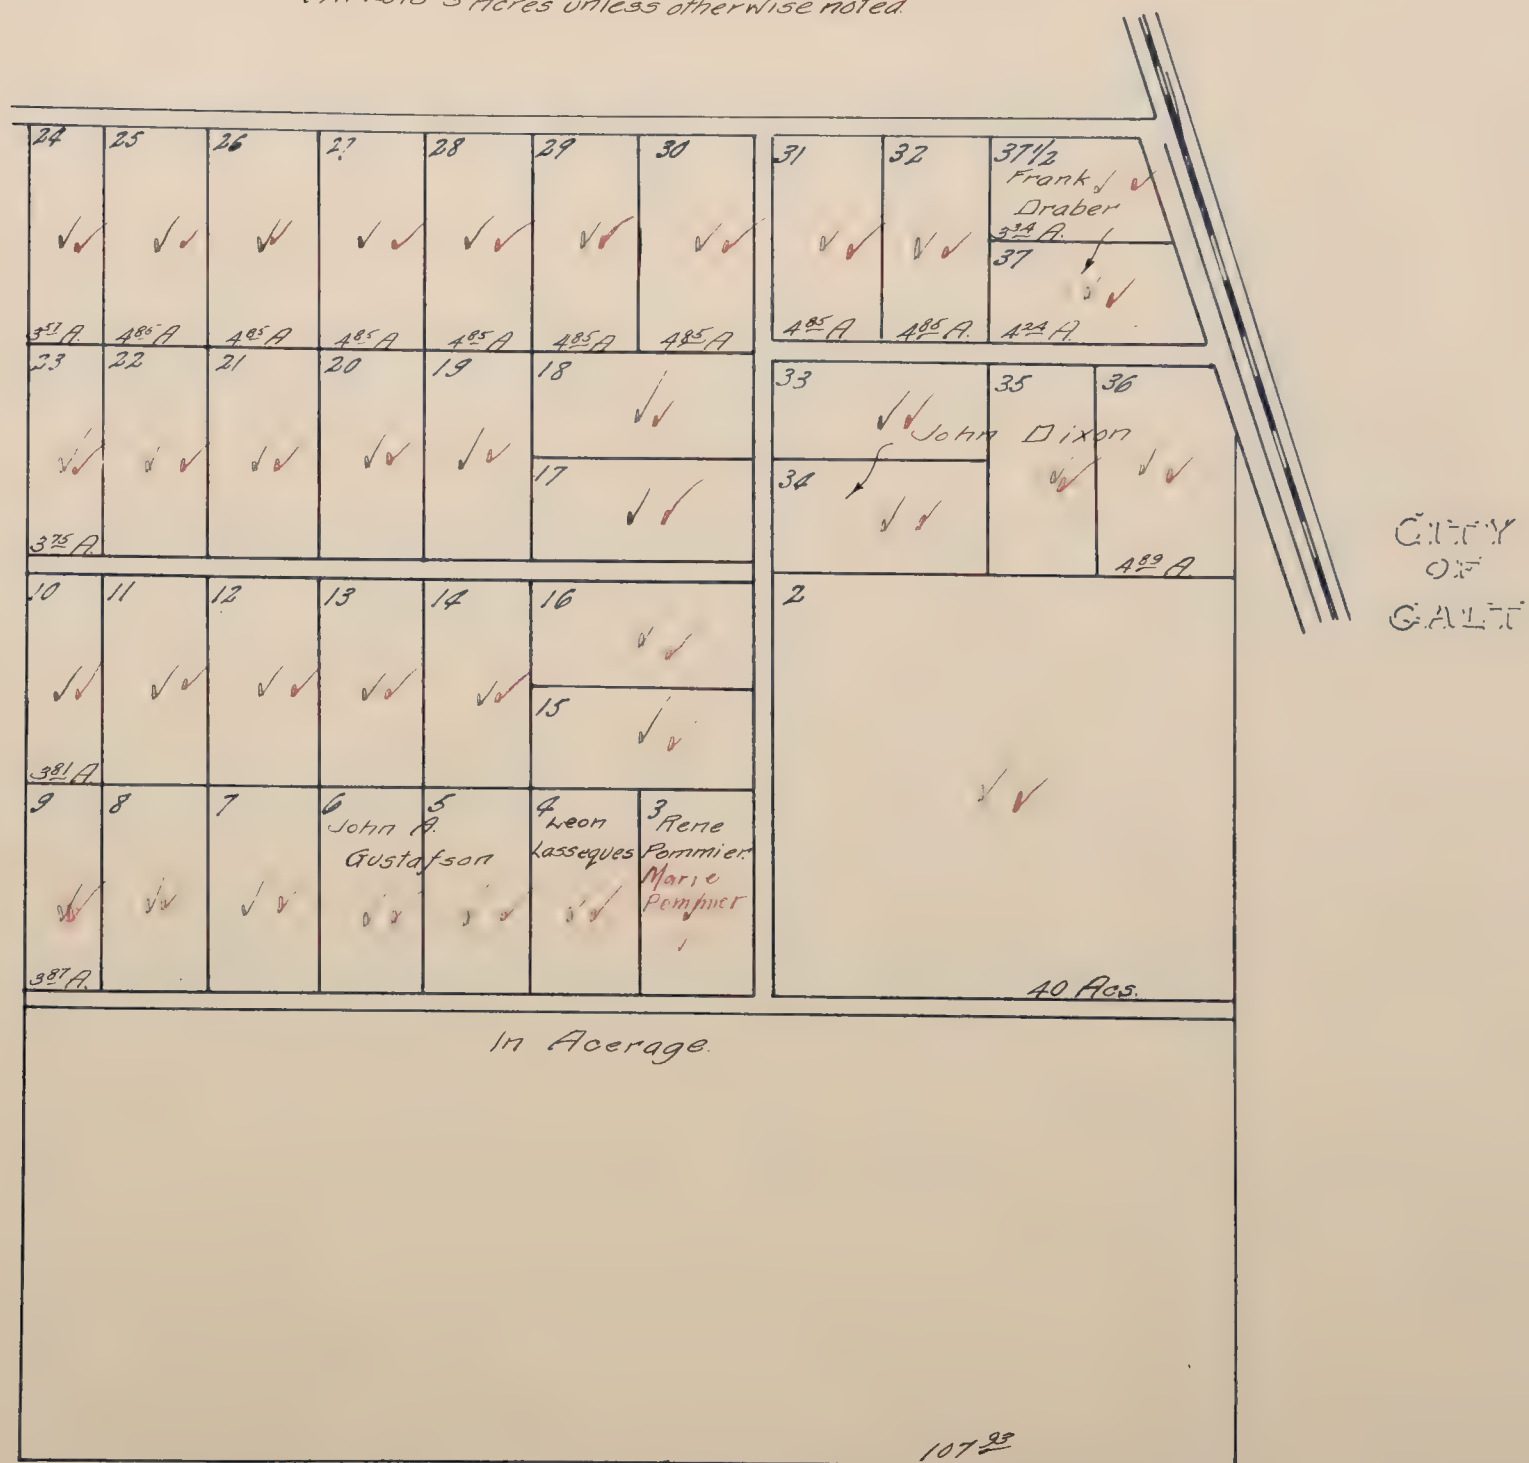

7

7


Galt S.D.

7



Black Ink=1919 Ownership
Red Ink=1920 Ownership

Blanks to Golden Valley Land Co. ✓ ✓
All Lots 10 Acres unless otherwise noted.

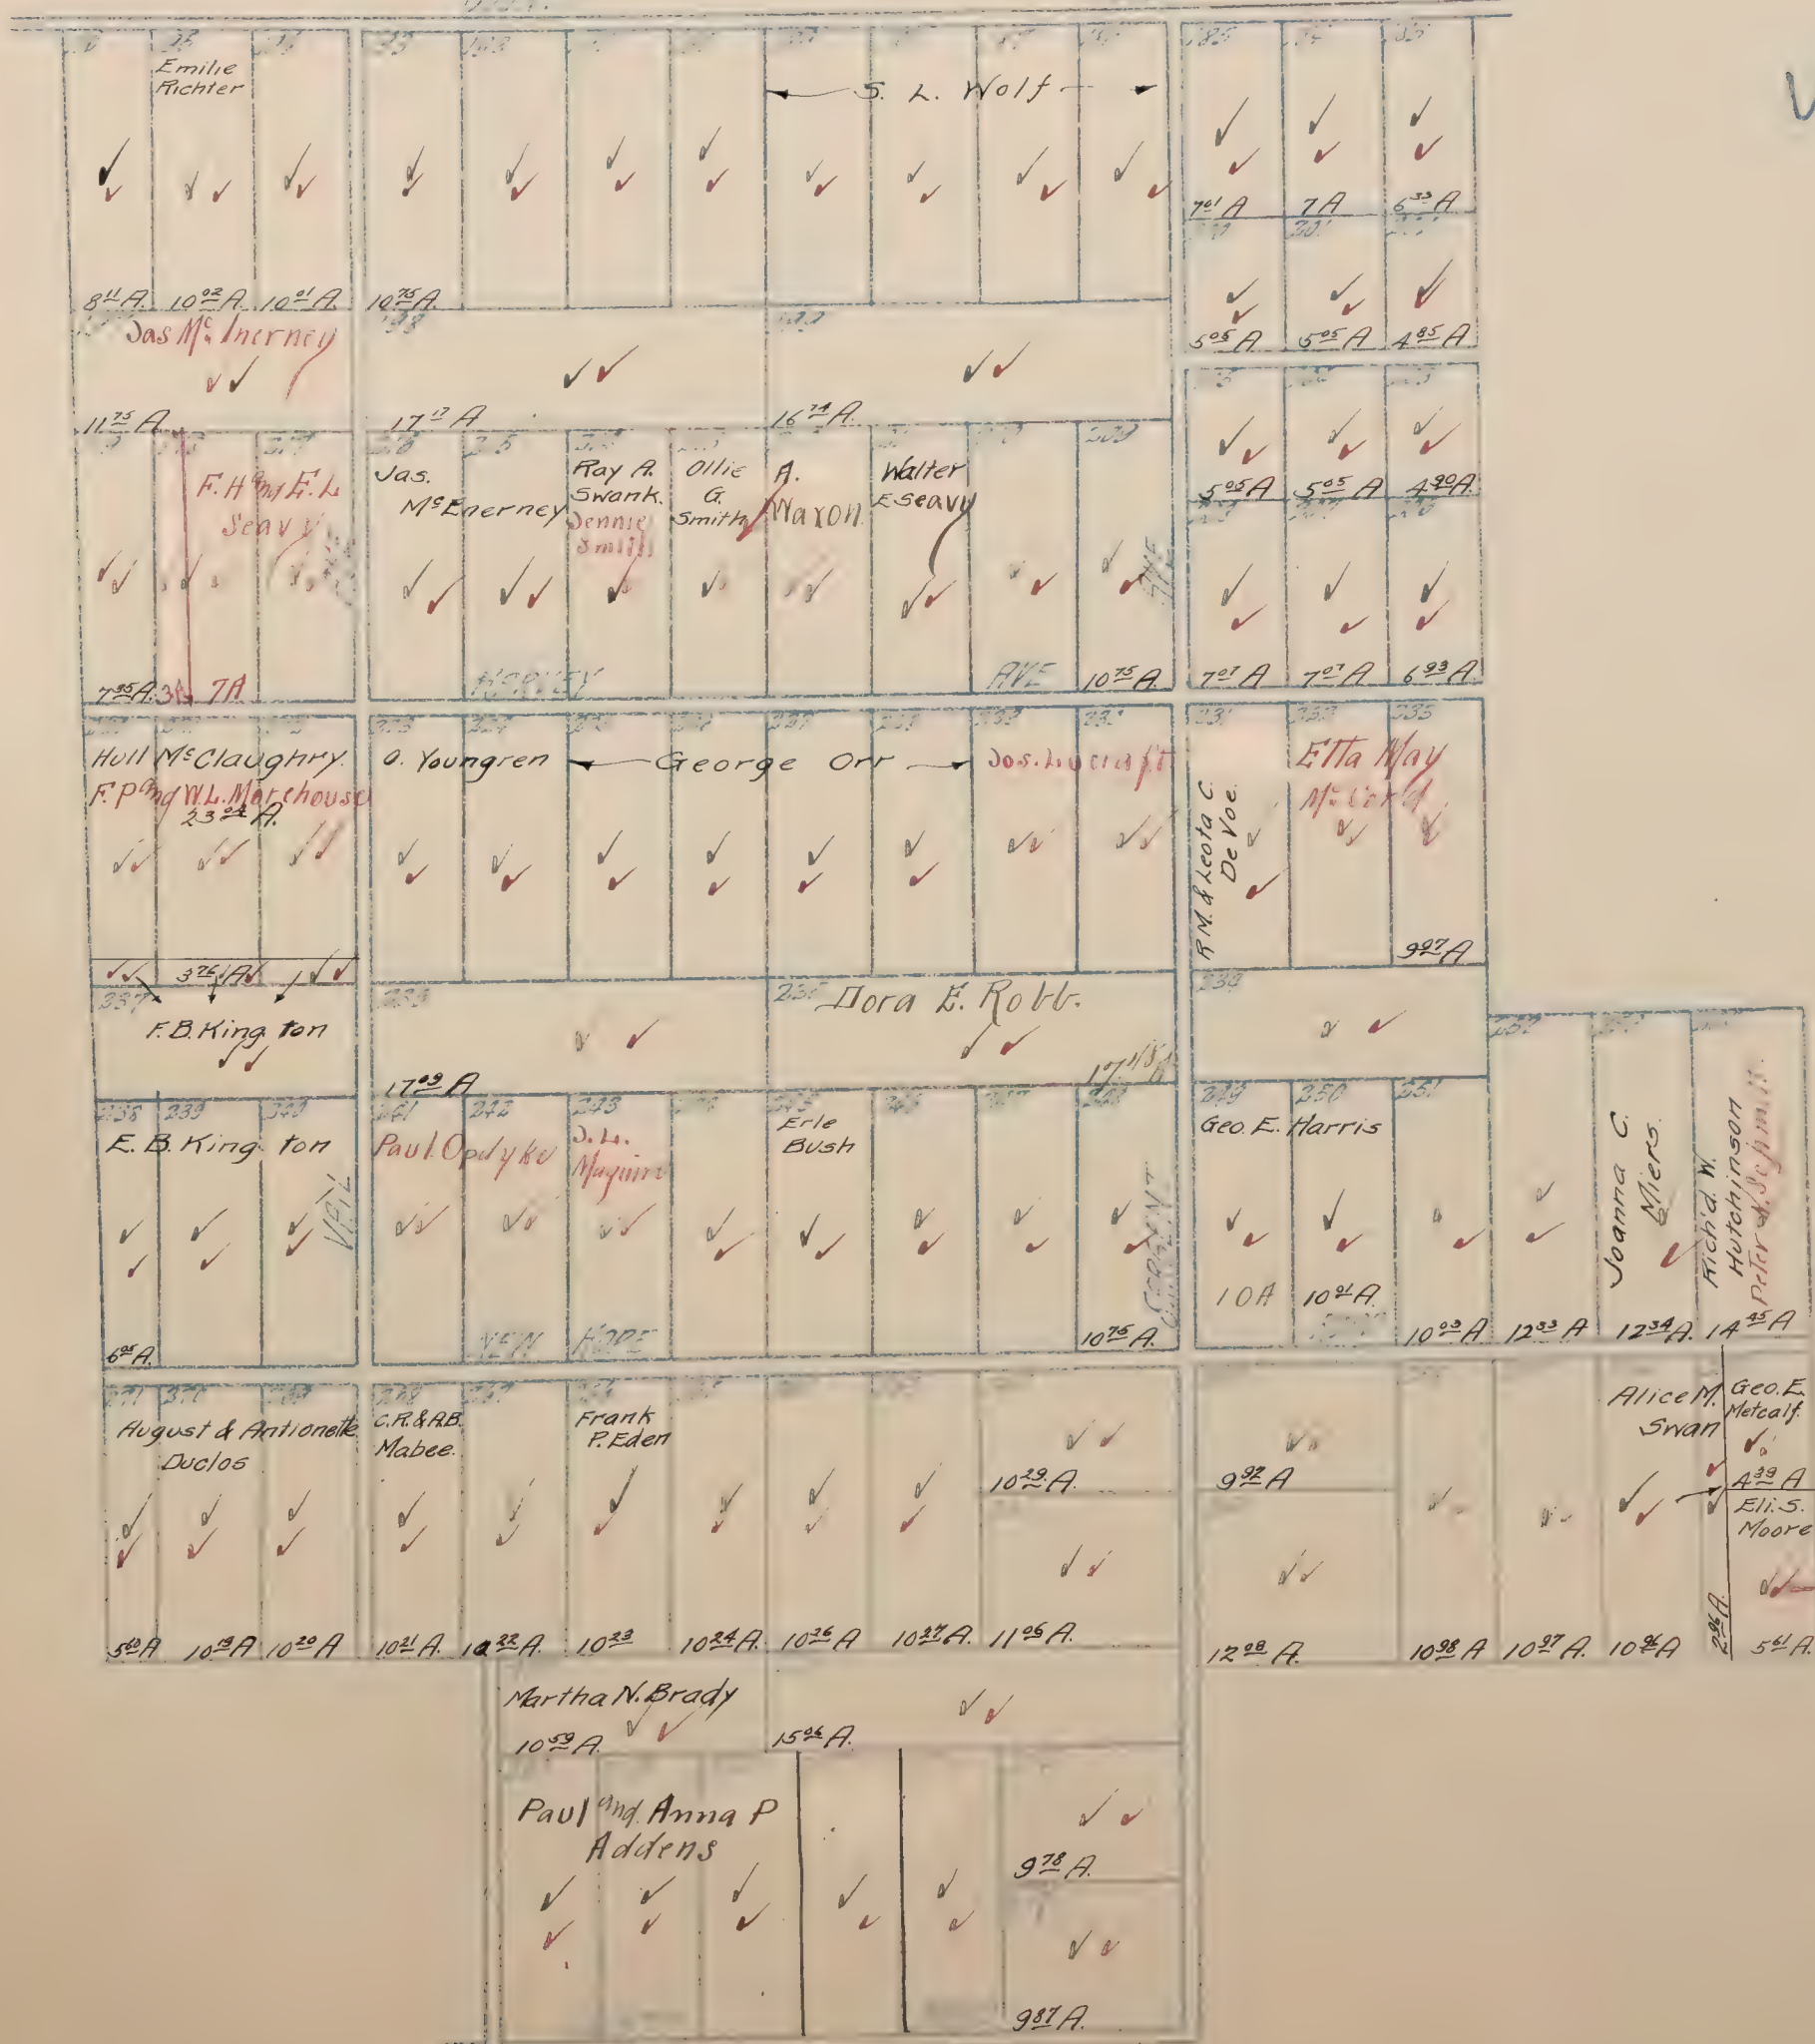

located in
Locs 27-28-33 T&M R.F.
Scale 1" = 260'

Black Ink-1919 Ownership
Red Ink-1920 Ownership

VALLEY OAKS NO.4

located Near
Galt Sacramento County Cal
Scale 1"=15 Chs

Go. V S.D.

All blanks assessed to Harvey Land Co ✓

	296 ✓✓ 40 th A 225	297 ✓✓ 200 th A 224	R.E. Coker C.F. Parker	298 Elsie P North ✓✓ 45 th A 223	
	✓✓ 40 A	✓✓ 40 A		W.J. Anthony J.A. Anthony ✓✓ 45 th A	
	290 ✓✓ 40 A	291 ✓✓ 40 A		292 ✓✓ 45 th A	
	289 ✓✓ 40 A	288 ✓✓ 40 A	287 ✓✓ 20 A	H.P. & Sarah A. Buell D.B. Morgan 25 th A	
Sec. 30	29	40 A	40 A	20 A	25 th A
Sec. 31	32 284 ✓✓ 40 A	285 ✓✓ 40 A	286 ✓✓ 45 th A		
	283 ✓✓ 39 A	284 Louis J. Holmes ✓✓ 39 A	281 ✓✓ 44 th A		

Sec 29 28
Sec 32 33


Mapped.

Black Ink-1919 Ownership
Red Ink-1920 Ownership

VINE STREET ADDITION

LOCATED IN THE
N.W. 1/4 OF SEC. 14, T. 36 N., R. 3 E.,
S. 100' East Line.

Fruit Ridge, S.D.

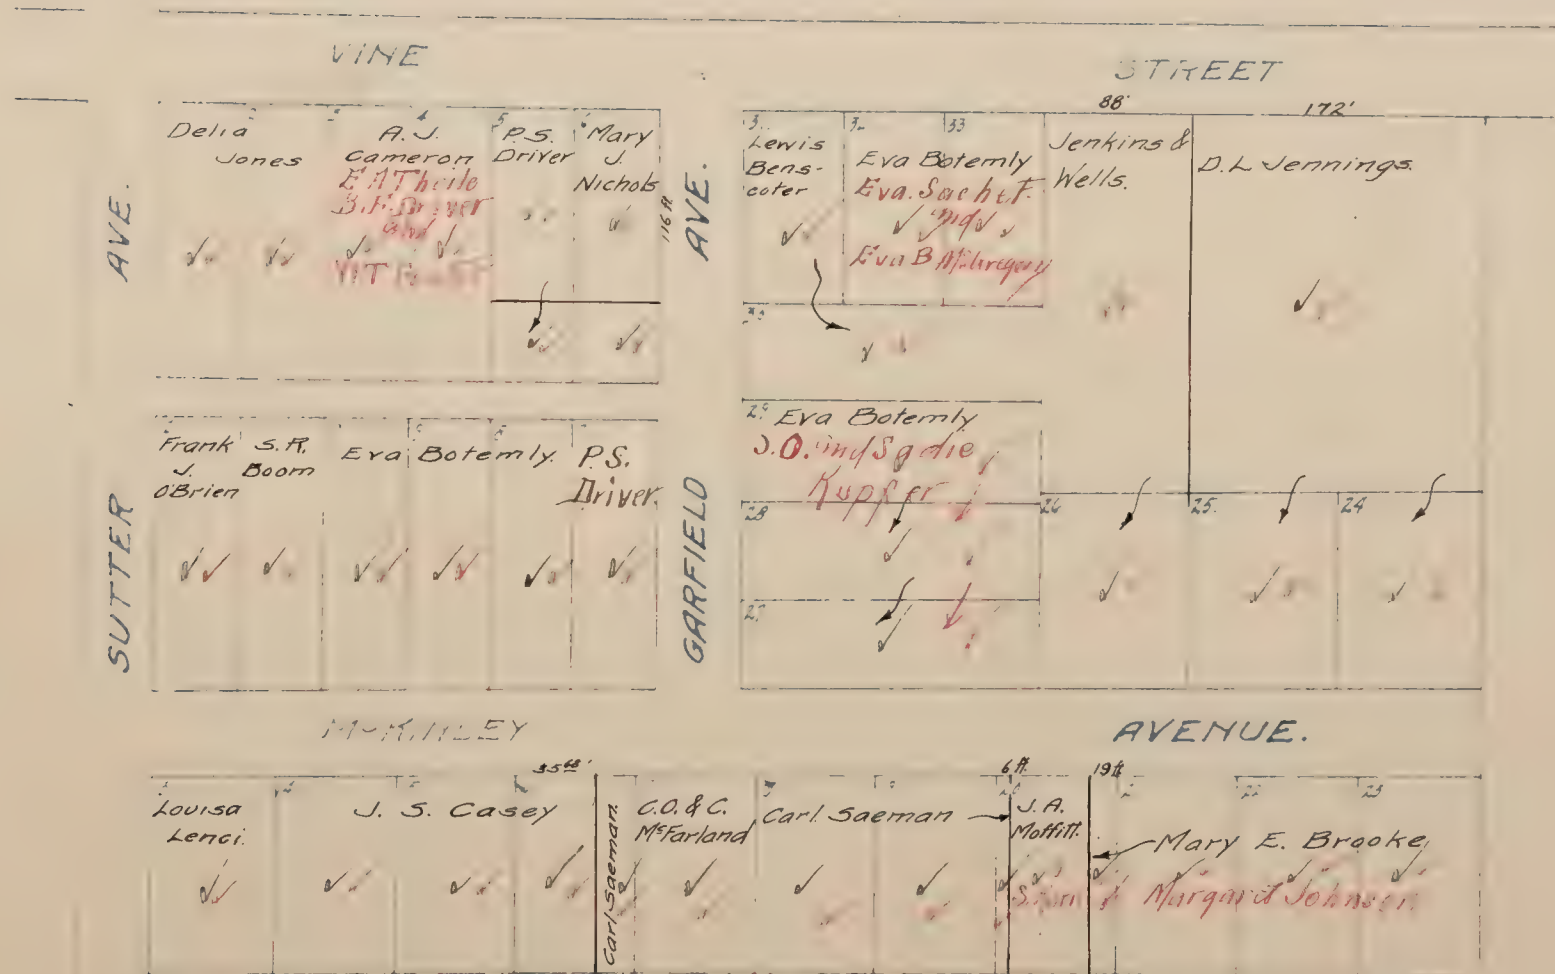

45' 45.7"

Mapped.
VINELAND

located in
Sec. 20 Rancho Del Paso
Scale: 1" = 6 chs.

~~Center S.D.~~
~~Del Norte S.D.~~

Fruitvale S.D.

San Linda S.D.

Blanks to Sacto. Suburban Fruit Lands Co.
All Lots 10 Acres unless otherwise noted.

RIO LINDA

SECTION No. 1

*See
witnessed
of Vineland
1920
witnessed*

1	2	3	4	5	6	7	8
16	15	14	13	12	11	10	9
17	18	19	20	21	22	23	24
32	31	30	29	28	27	26	25
33	34	35	36	37	38	39	40
48	47	46	45	44	43	42	41
49	50	51	52	53	54	55	56
64	63	62	61	60	59	58	57

DEL PASO POULTRY FARMS

VINELAND

AMENDED MAP OF

VINELAND

located in

Sec. 20 Rancho Del Paso

Scale: 1" = 400 ft.

Blanks to ~~San Joaquin~~ Fruit Land Co. ✓

Fruitvale S.D.

~~Center S.D.~~

~~Robin S.D.~~

~~Rio Linda~~

RIO LINDA

SUBDIVISION No 1

~~Rio Linda S.D.~~

~~Roll S.D.~~

~~Center S.D.~~

DEL PASO POULTRY FARMS

Mapped.

Black Ink-1919 Ownership
Red Ink-1920 Ownership

WARING VILLA TRACT

LOCATED IN THE
N. 1/2 SEC. 20 T. 8 N. R. 5 E.

Scale 1 inch = 120 feet.

Waring Villa
GOLDEN S. D.

VINE STREET				STREET			
20 Daniel Cameron	19	12 A. Weister & Sons Co.	11 W. G. Eizinger	10 F. W. Cokley	9 Nellie S. Durlap	2 A. G. Boone	1 Geo. A. Briggs
✓	✓	✓	✓	✓	✓	✓	✓
18	17 Anna M. Schneider	13 Harry S. Rubina	8 Laura C. Wilson	7 Sarah A. King	6 Laura Kernen	3 W. W. Theobald	4 Jas. Davidson
✓	✓	✓	✓	✓	✓	✓	✓
16 Mrs. A. M. Reynolds	15 Laura Kernen	14	5 John & Spiva	4 P. A. Spiva	3 John & Spiva	2 P. A. Spiva	1 P. A. Spiva
✓	✓	✓	✓	✓	✓	✓	✓

Waring Villa


W

Black Ink-1919 Ownership
Red Ink-1920 Ownership
Mapped.

WEEK'S COLONY No 1

BEING THE
N $\frac{1}{2}$ of Sec. 29, T. 7N, R. 6E.
Scale: 400' = 1"

Pleasant Grove S.D.

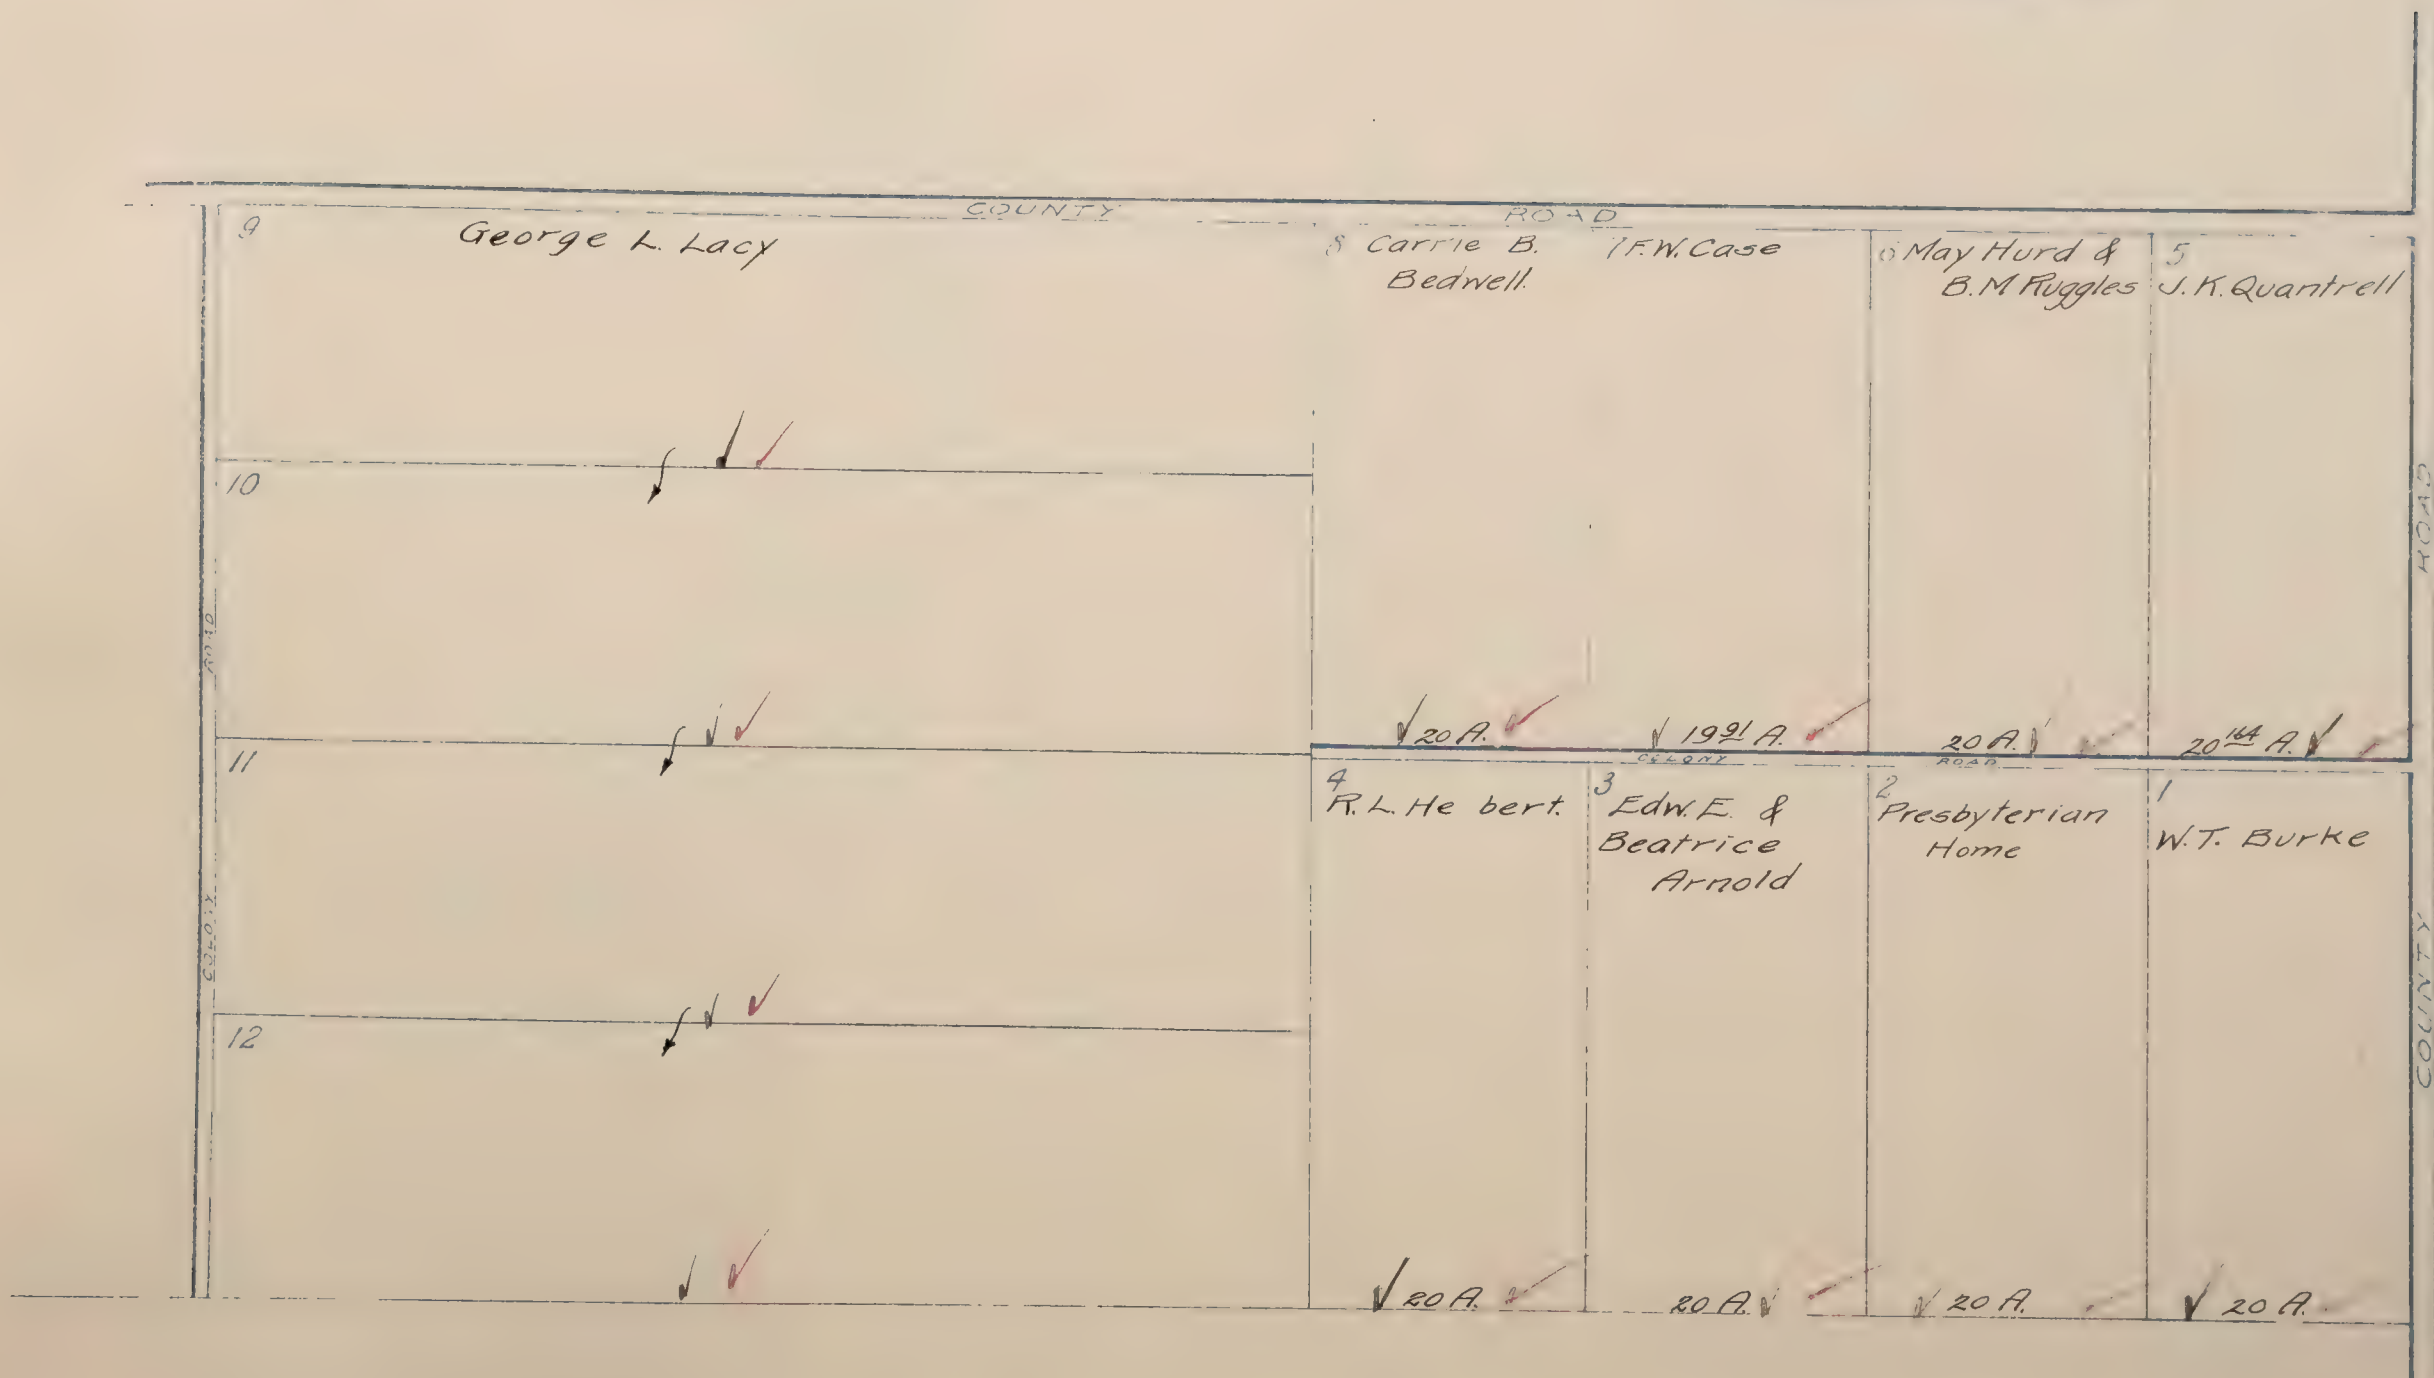

Mapped.

Black Ink-1919 Ownership
Red Ink-1920 Ownership

AMENDED
Plat of

WEST DEL PASO HEIGHTS


LOCATED IN

W 1/2 Sec 12 Rancho Del Paso

Scale: 1 inch = 150 feet.

Blanks to Kesner Land Co. ✓✓

Del Paso Hts. 10.
Oak Grove S.D.

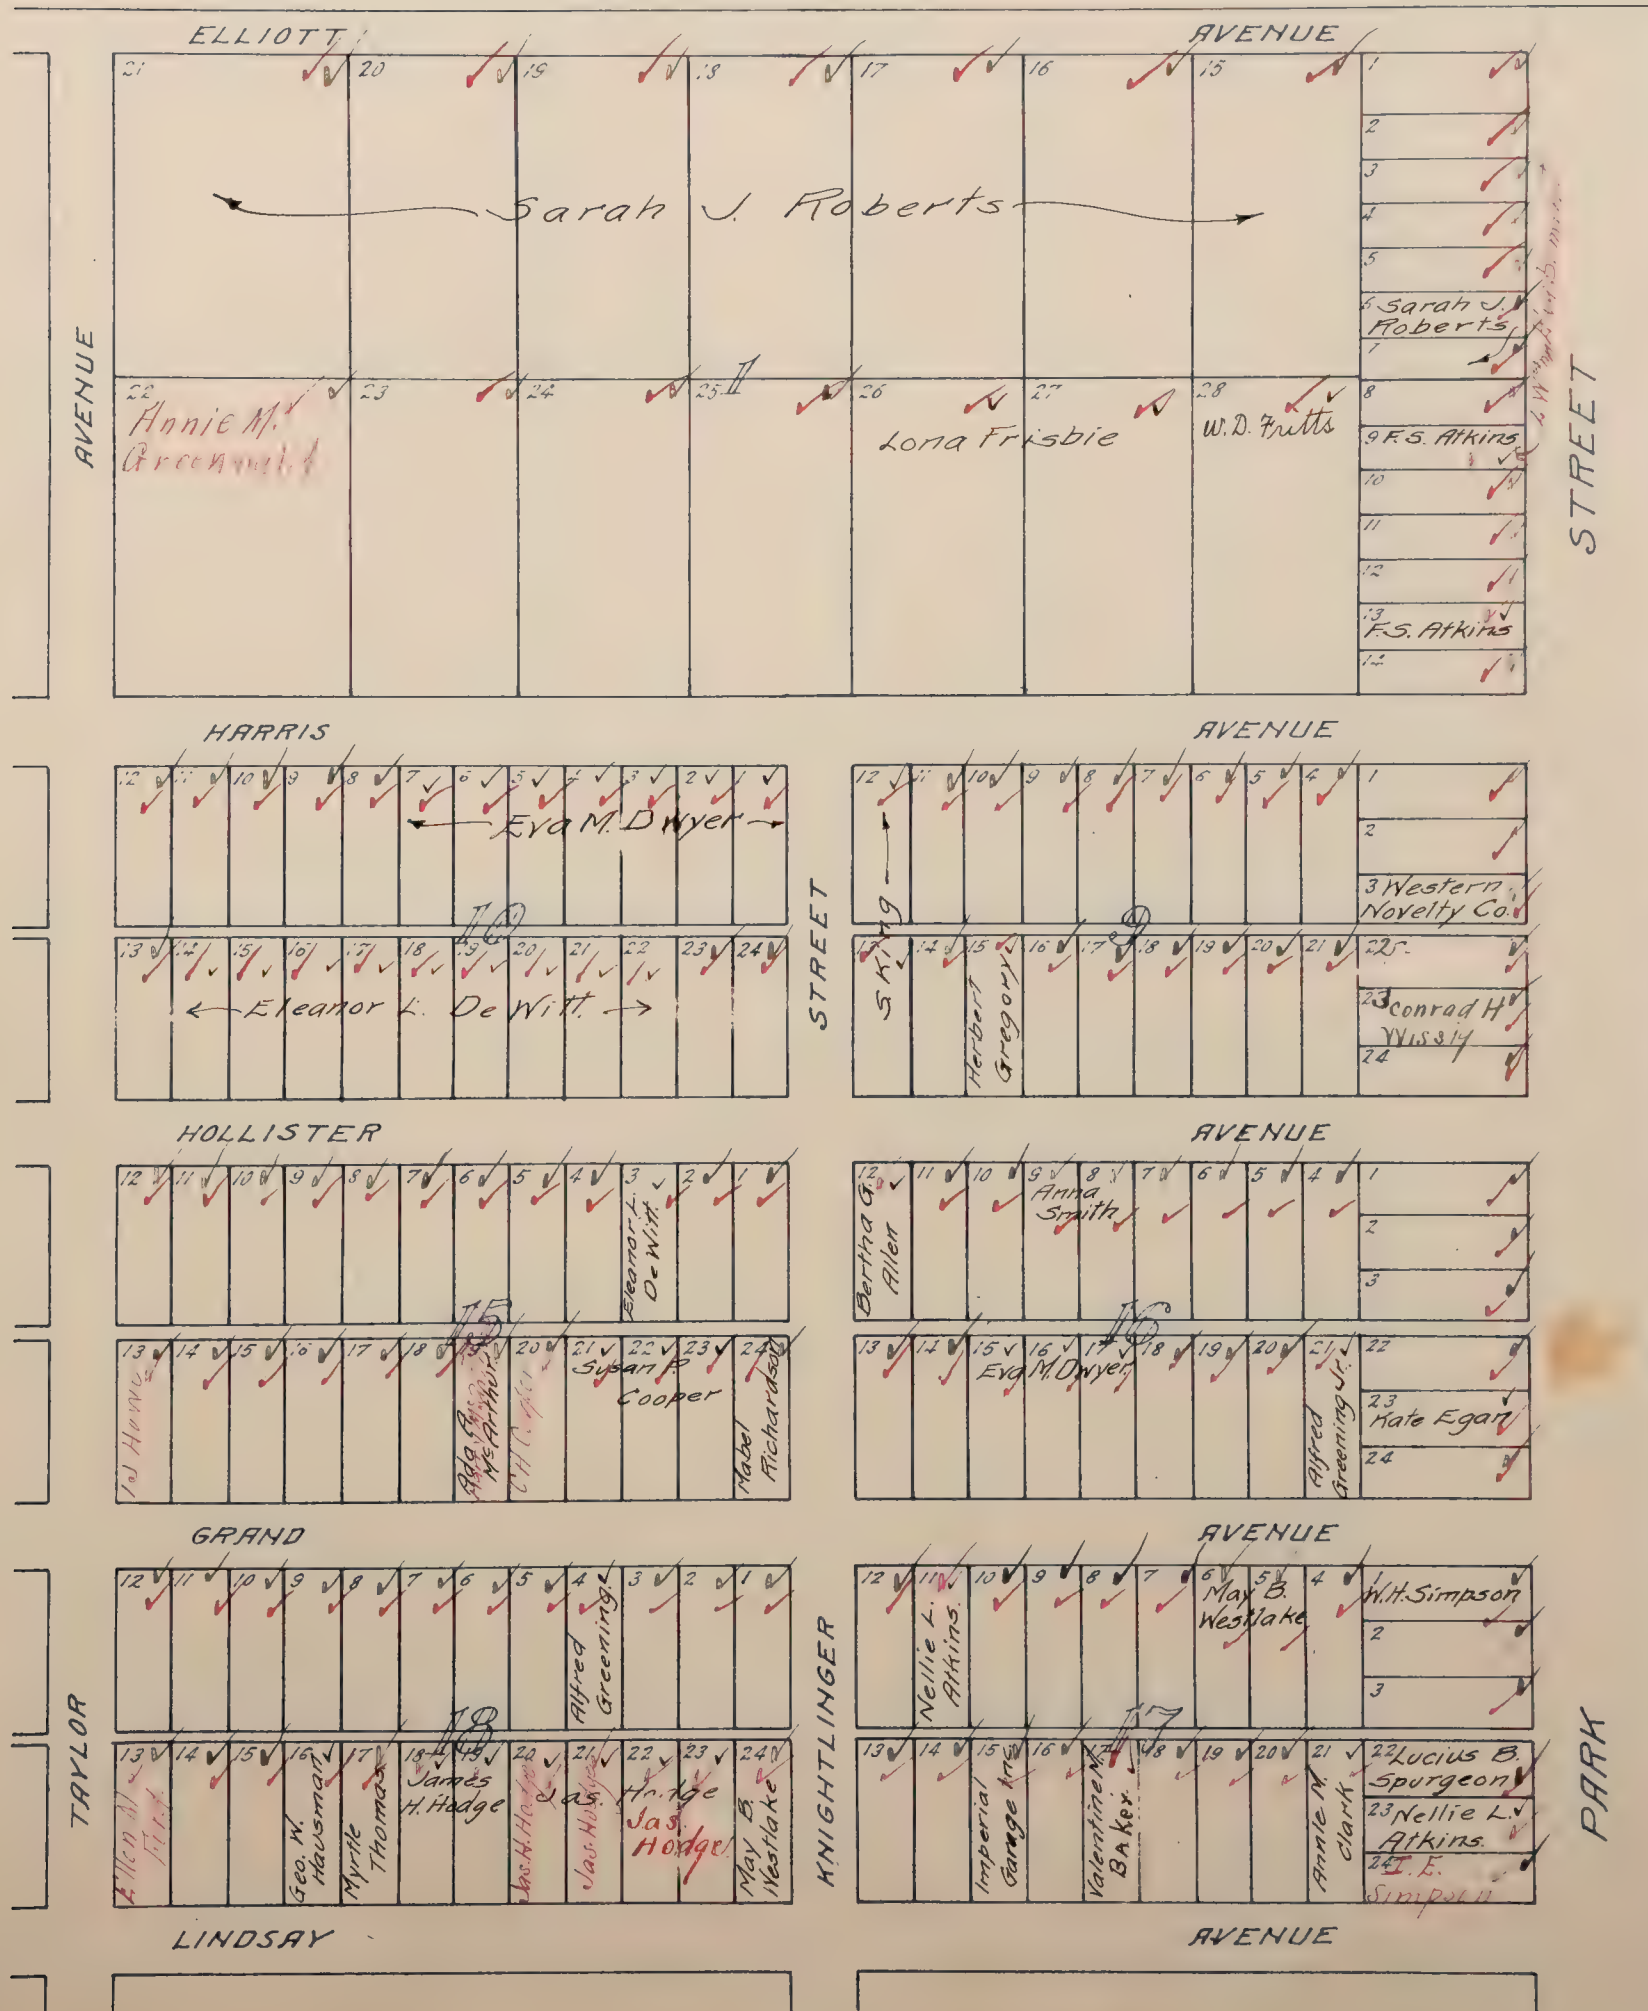

Mapped.

Black Ink-1919 Ownership
Red Ink-1920 Ownership

AMENDED
Plat of

WEST DEL PASO HEIGHTS

LOCATED IN
W 1/2 Sec. 12 Rancho Del Paso
Scale 1 inch = 150 feet

*Del Paso Alt.
Oak Grove S.D.*

Blanks to Kesner Land Co.




Mapped.
AMENDED
Plot of
WEST DEL PASO HEIGHTS
LOCATED IN
W 1/2 Sec. 12 Rancho Del Paso
Scale: 1 inch = 150 feet.

Black Ink-1919 Ownership
Red Ink-1920 Ownership

Blair & Kesner Land Co. ✓

Del Paso Heights
Hemet, Cal. S.D.

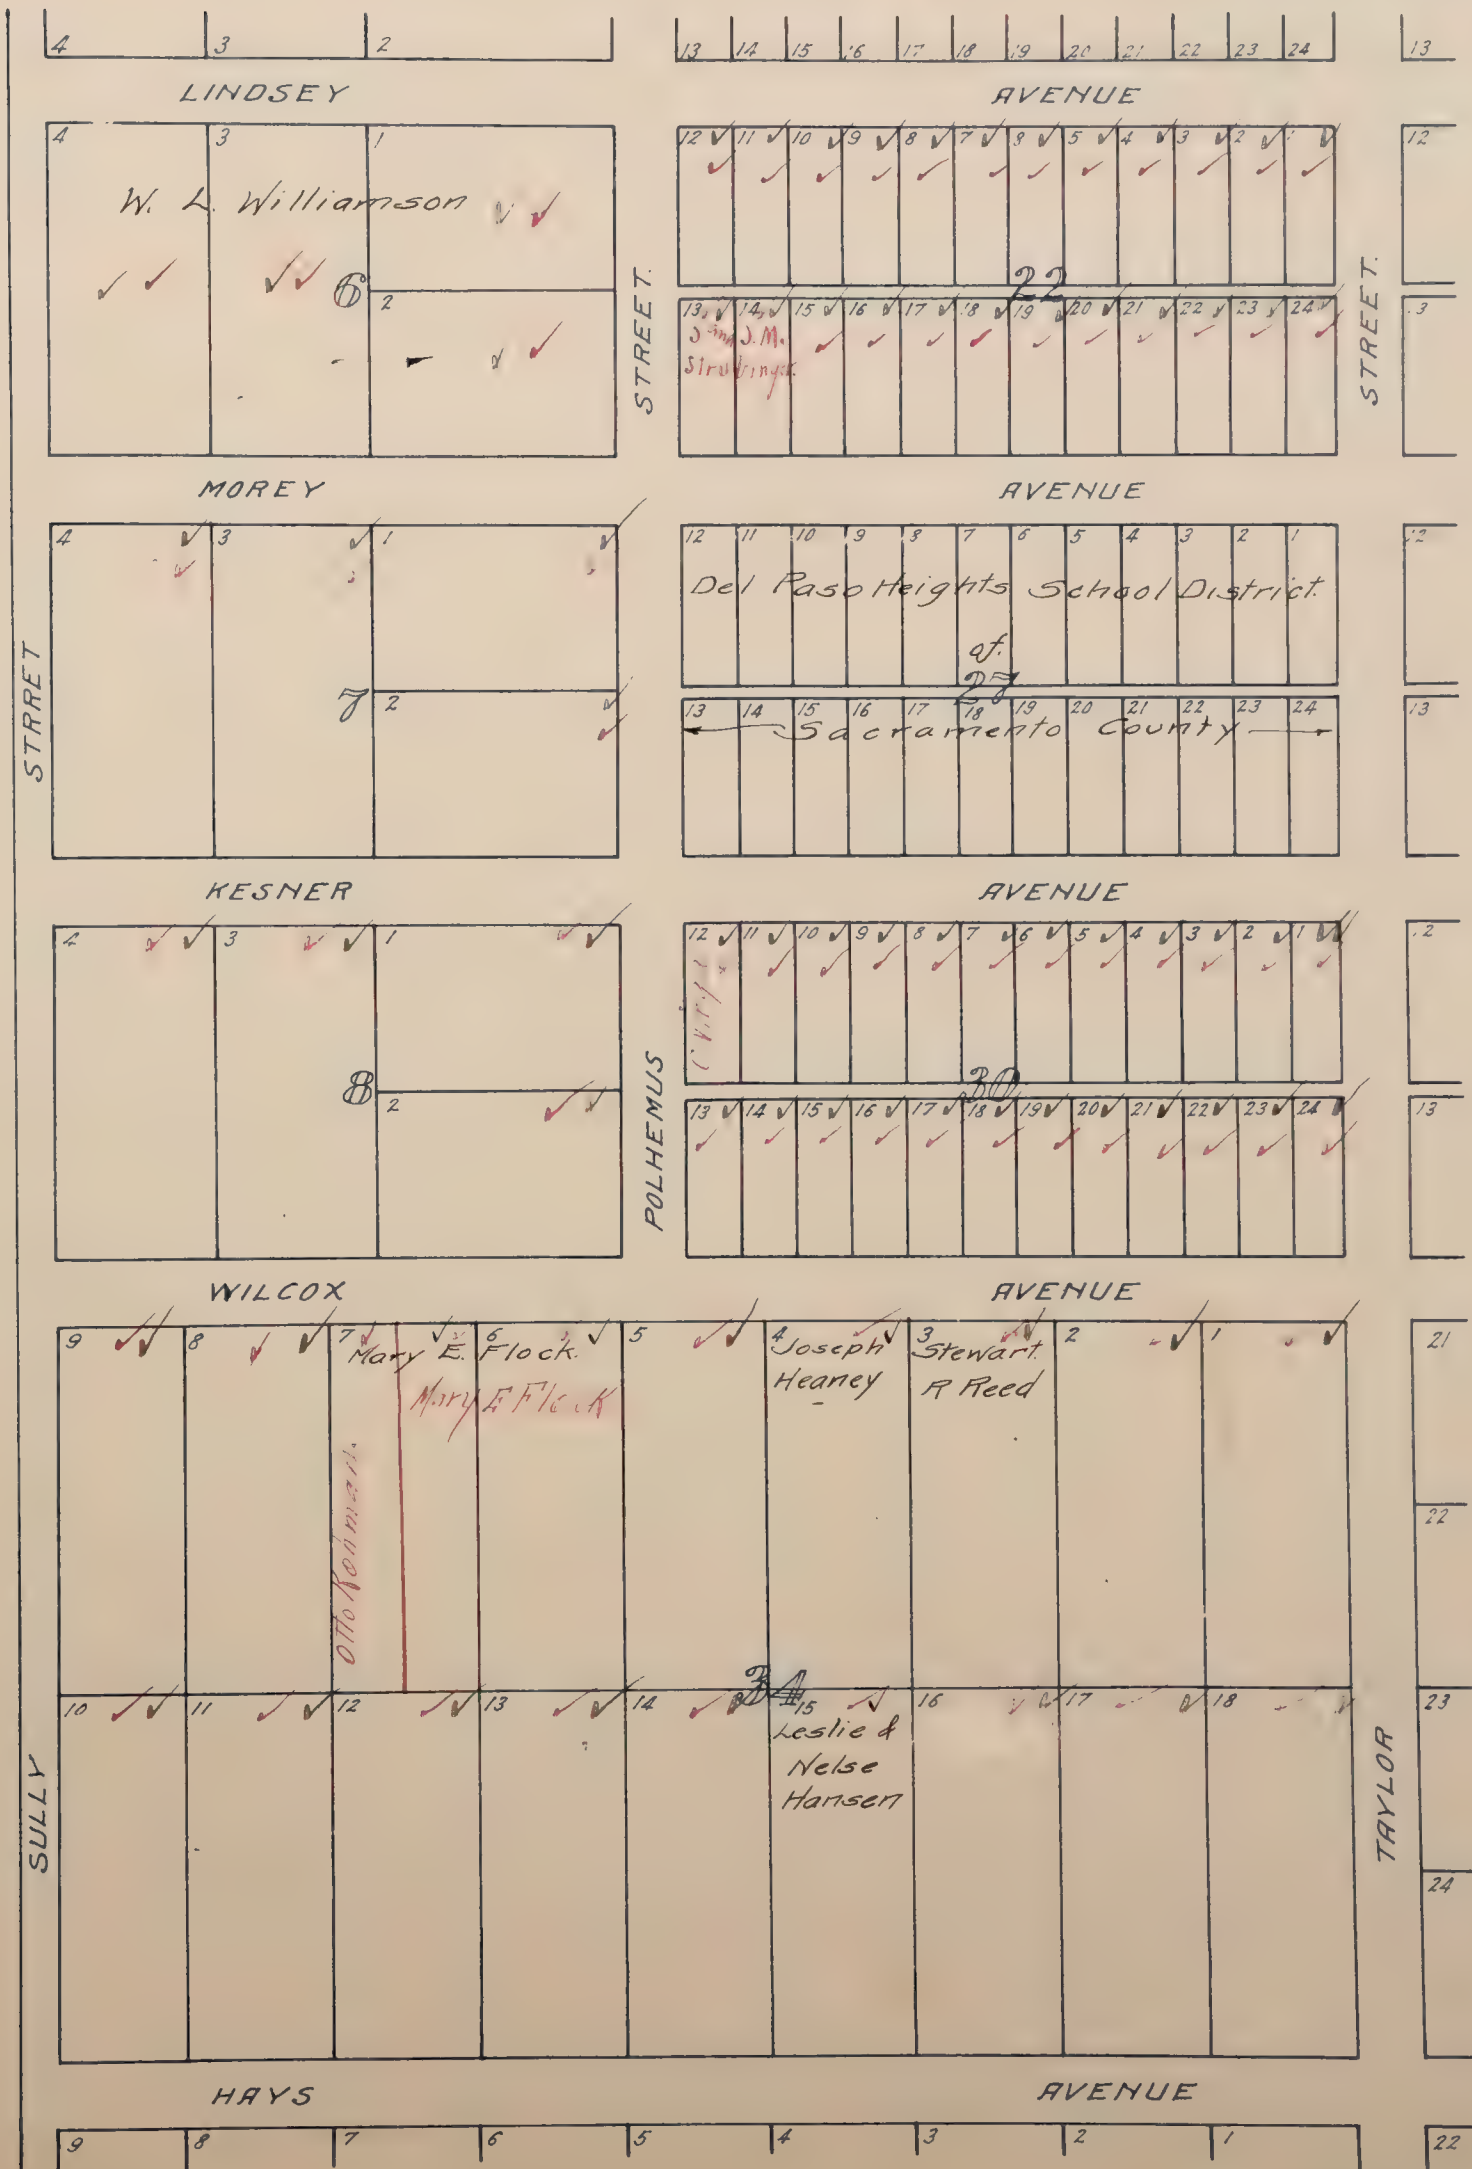

Mapped.

Black Ink-1919 Ownership
Red Ink-1910 Ownership

AMENDED
Plat of

WEST DEL PASO HEIGHTS

LOCATED IN
W 1/2 Sec. 12 Rancho Del Paso

Scale: 1 inch = 150 feet.

Blanks to Kesner Land Co. ✓

*Del Paso Hts.
American S.D.*




AME OF
PL

LOCATED

W 1/2 Sec. 12 Rancho Del Paso
Scale: 1 inch = 10 feet

Del. Russ 115
American 50

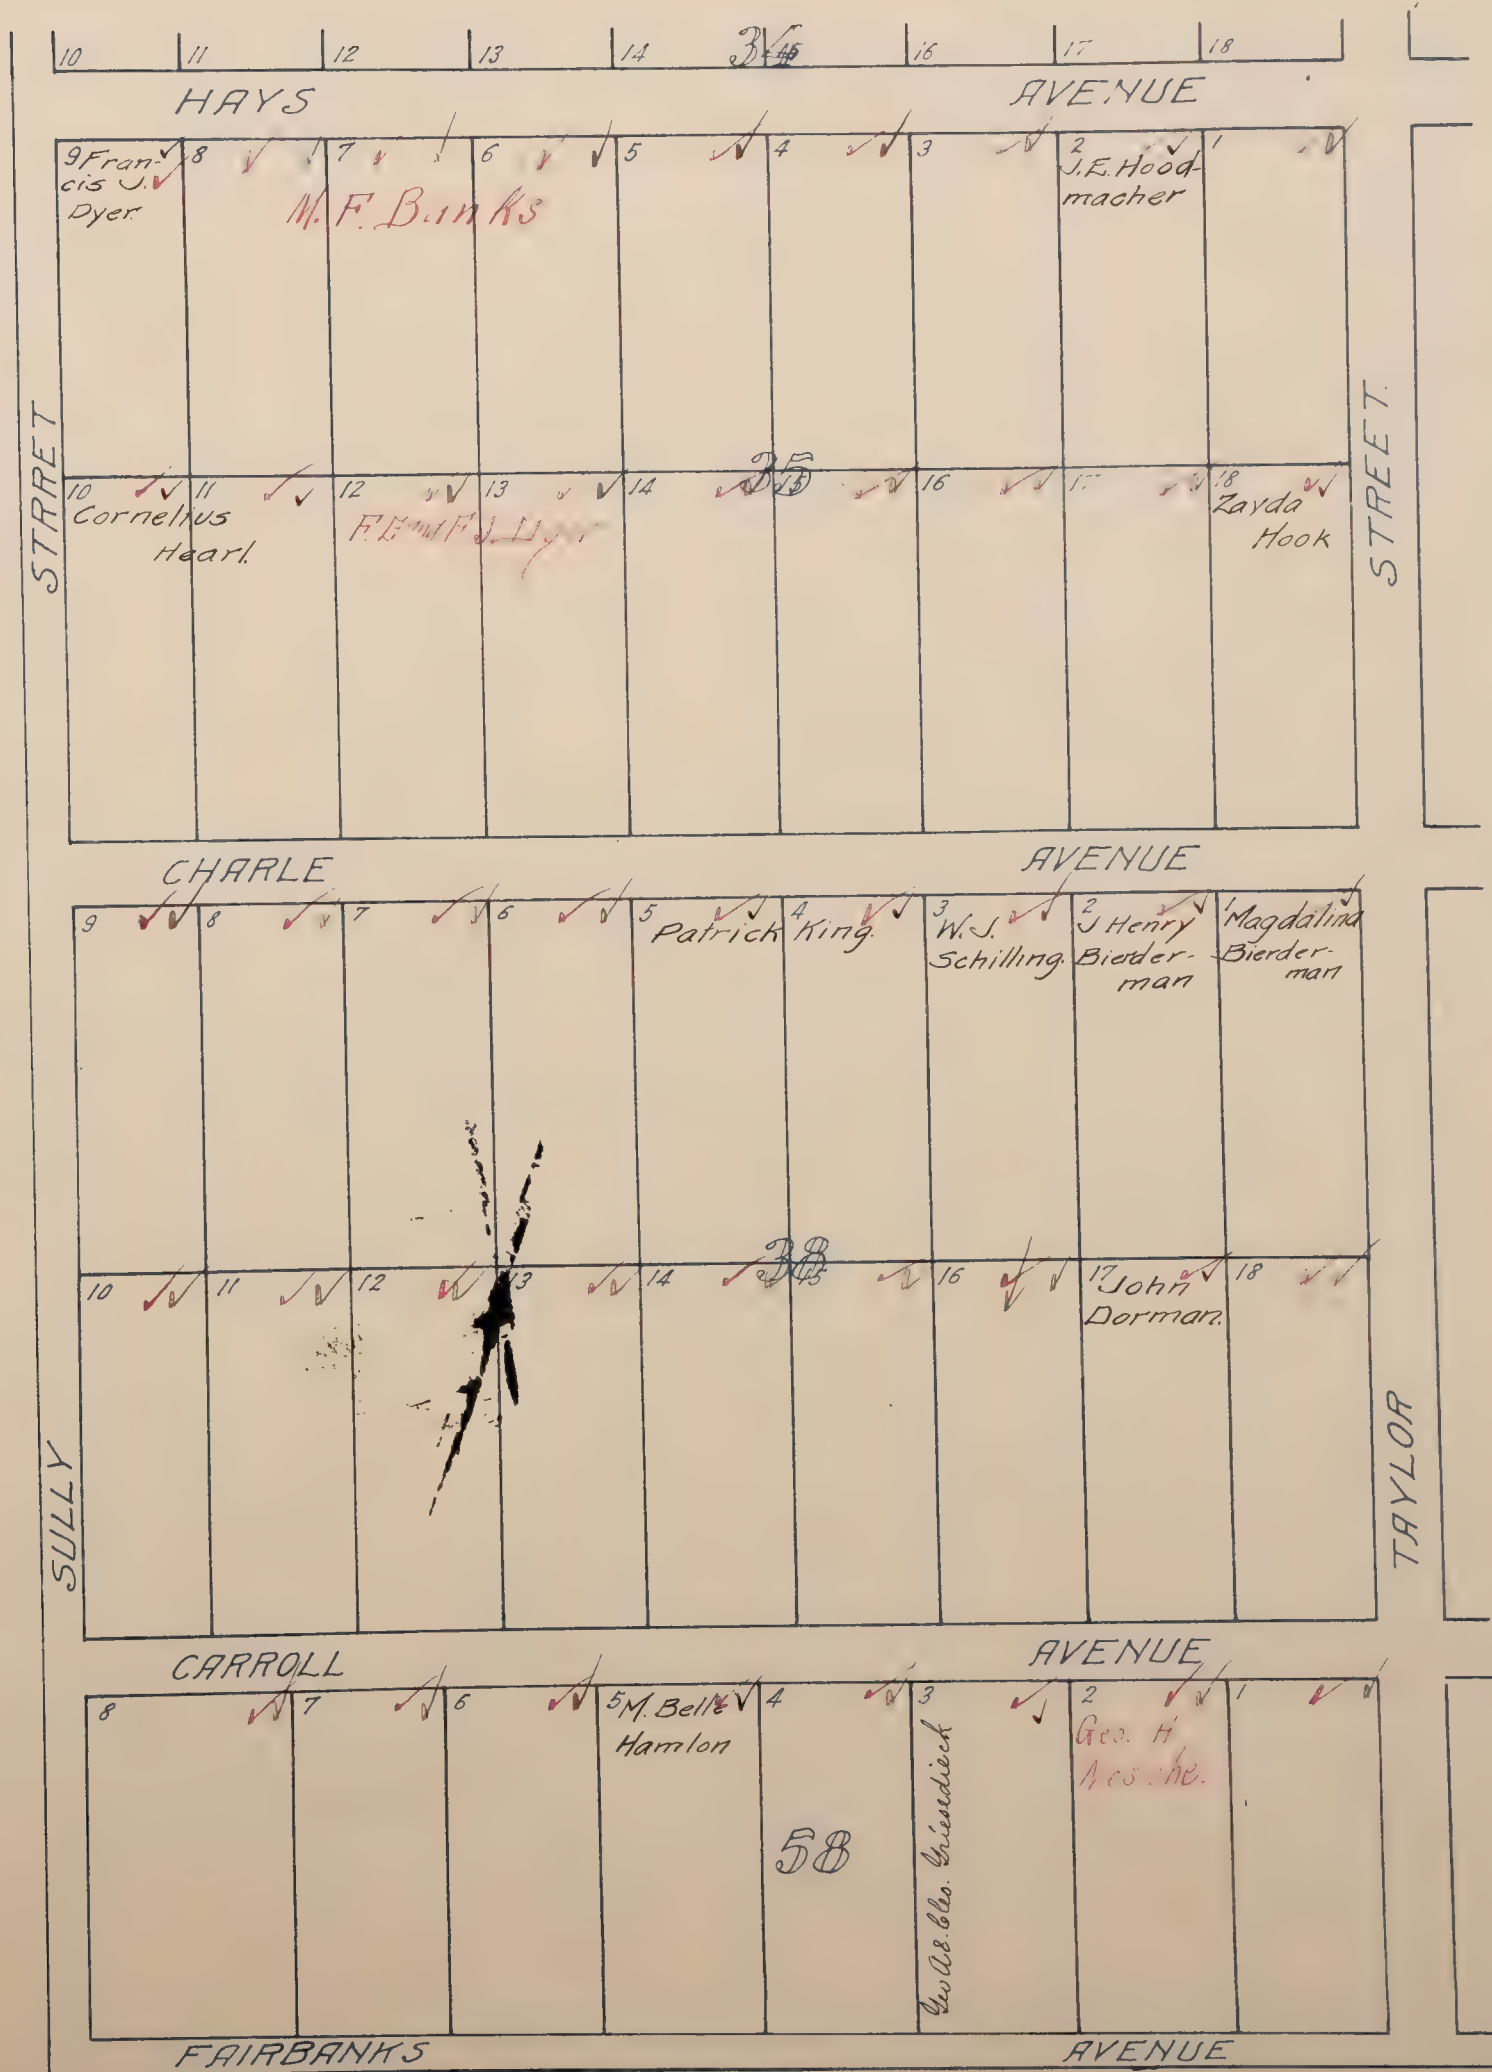

AMENDED
Plat of

WEST DEL PASO HEIGHTS


LOCATED IN

W 1/2 Sec. 12 Rancho Del Paso

Scale 1 inch = 150 feet

Blanks to Kesner Land Co. ✓

Del Rio Hb.
~~American~~ S.D.

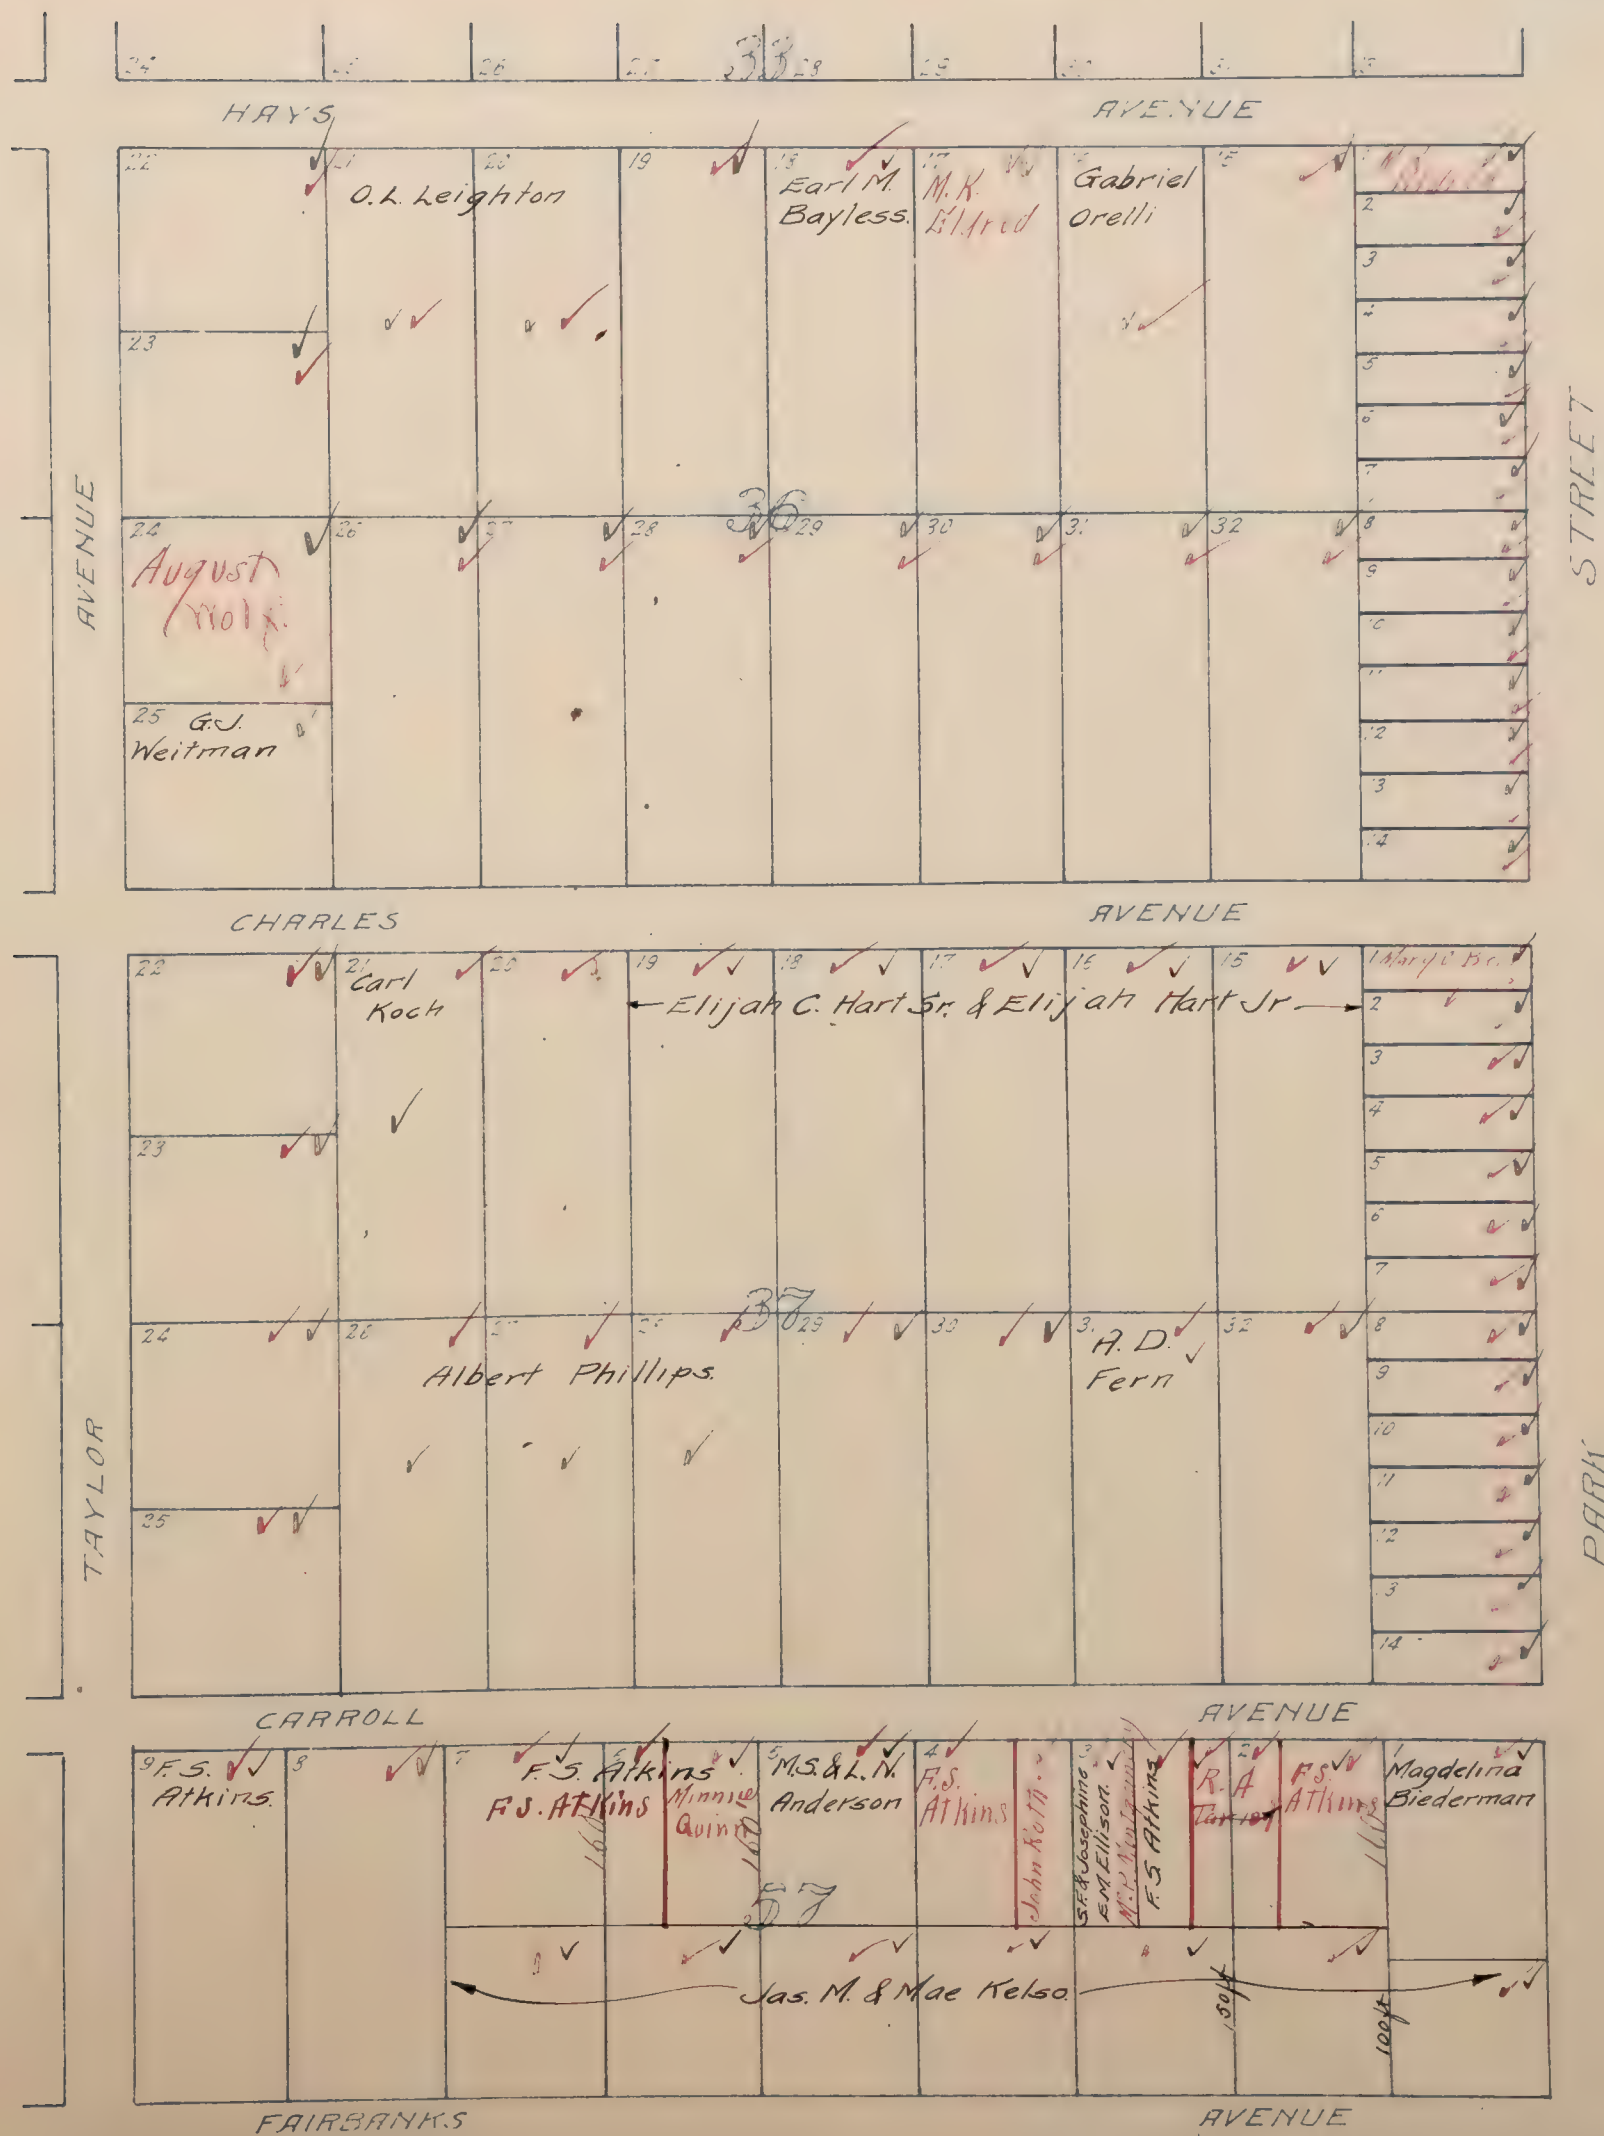

Mapped.

Black Ink-1910 Ownership
Red Ink-1930 Ownership

WESTERN PACIFIC ADDITION

LOCATED IN
SECS 18 & 19 - T.8N.R.5E.
Scale: 80' = 1"

*Palmetto Hts.
Goldberg S.D.*

Outside City

Inside City

Blanks to A. A. Merkley ✓

Alley

WESTERN

W. F. Rogers.	21	20	19	18	17	16	15	14	13	12	11	10	9	8	7	6	5	4	3	2	1
E. J. Campbell	22				Edith G. Ruggles			D. Cippa.	E. M. Kerr.					Sadie H. Paine.							
Margit Donegan.	23																				
Chas. L. Wallace	24																				

JEFFERY

AVENUE

PALMETTO

Victor U. Winfrey	44	43	42	41	40	39	38	37	36	35	34	33	32	31	30	29	28	27	26	25	24
		E. E. Harlan		Merkley, Chittenden & Heller	B. Reas		Geo. J. Talbot.	Addie E. Ross	W. M. Bakulich.	Edw. J. Campbell	E. D. McDonell	Attalia Bieglogni									
Hattie J. Babb	45																				
Lottie Bryant	46																				

Alley

C. E. Smith	71	70	69	68	67	66	65	64	63	62	61	60	59	58	57	56	55	54	53	52	51	50	49	48
		T. & S. A. Martin	James H. Francis	Grace Tillman	W. N. Glasford	John McCarty	Mrs. M. J. Moore	Mary Cox.						B. B. Baker										
L. Danforth	72																							
J. Q. Crabtree	73																							

AVENUE

PACIFIC

AVENUE

AVENUE

Geo. Petrinovich	99	98	97	96	95	94	93	92	91	90	89	88	87	86	85	84	83	82	81	80	79	78	77	76
	✓	Mary H. McDade			Jas. Russell			Eug. C. Louis Crosby Chap- man.		Merkley, Chittenden & Heller	Eug. C. Crosby		E. P. Clark.											
Etta Baker	✓		✓	✓	✓	✓	✓	✓	✓	✓	✓	✓	✓	✓										
	100		101	102	103																			

Alley

Black Ink: 1910 Ownership
Red Ink: 1920 Ownership

WHITAKERS ADD'N.

TO GALT


located in

Sec 26 T.5 N. R. 6 E.

Scale: 1"=100'

Galt S.D.

Blanks to Ray Gower

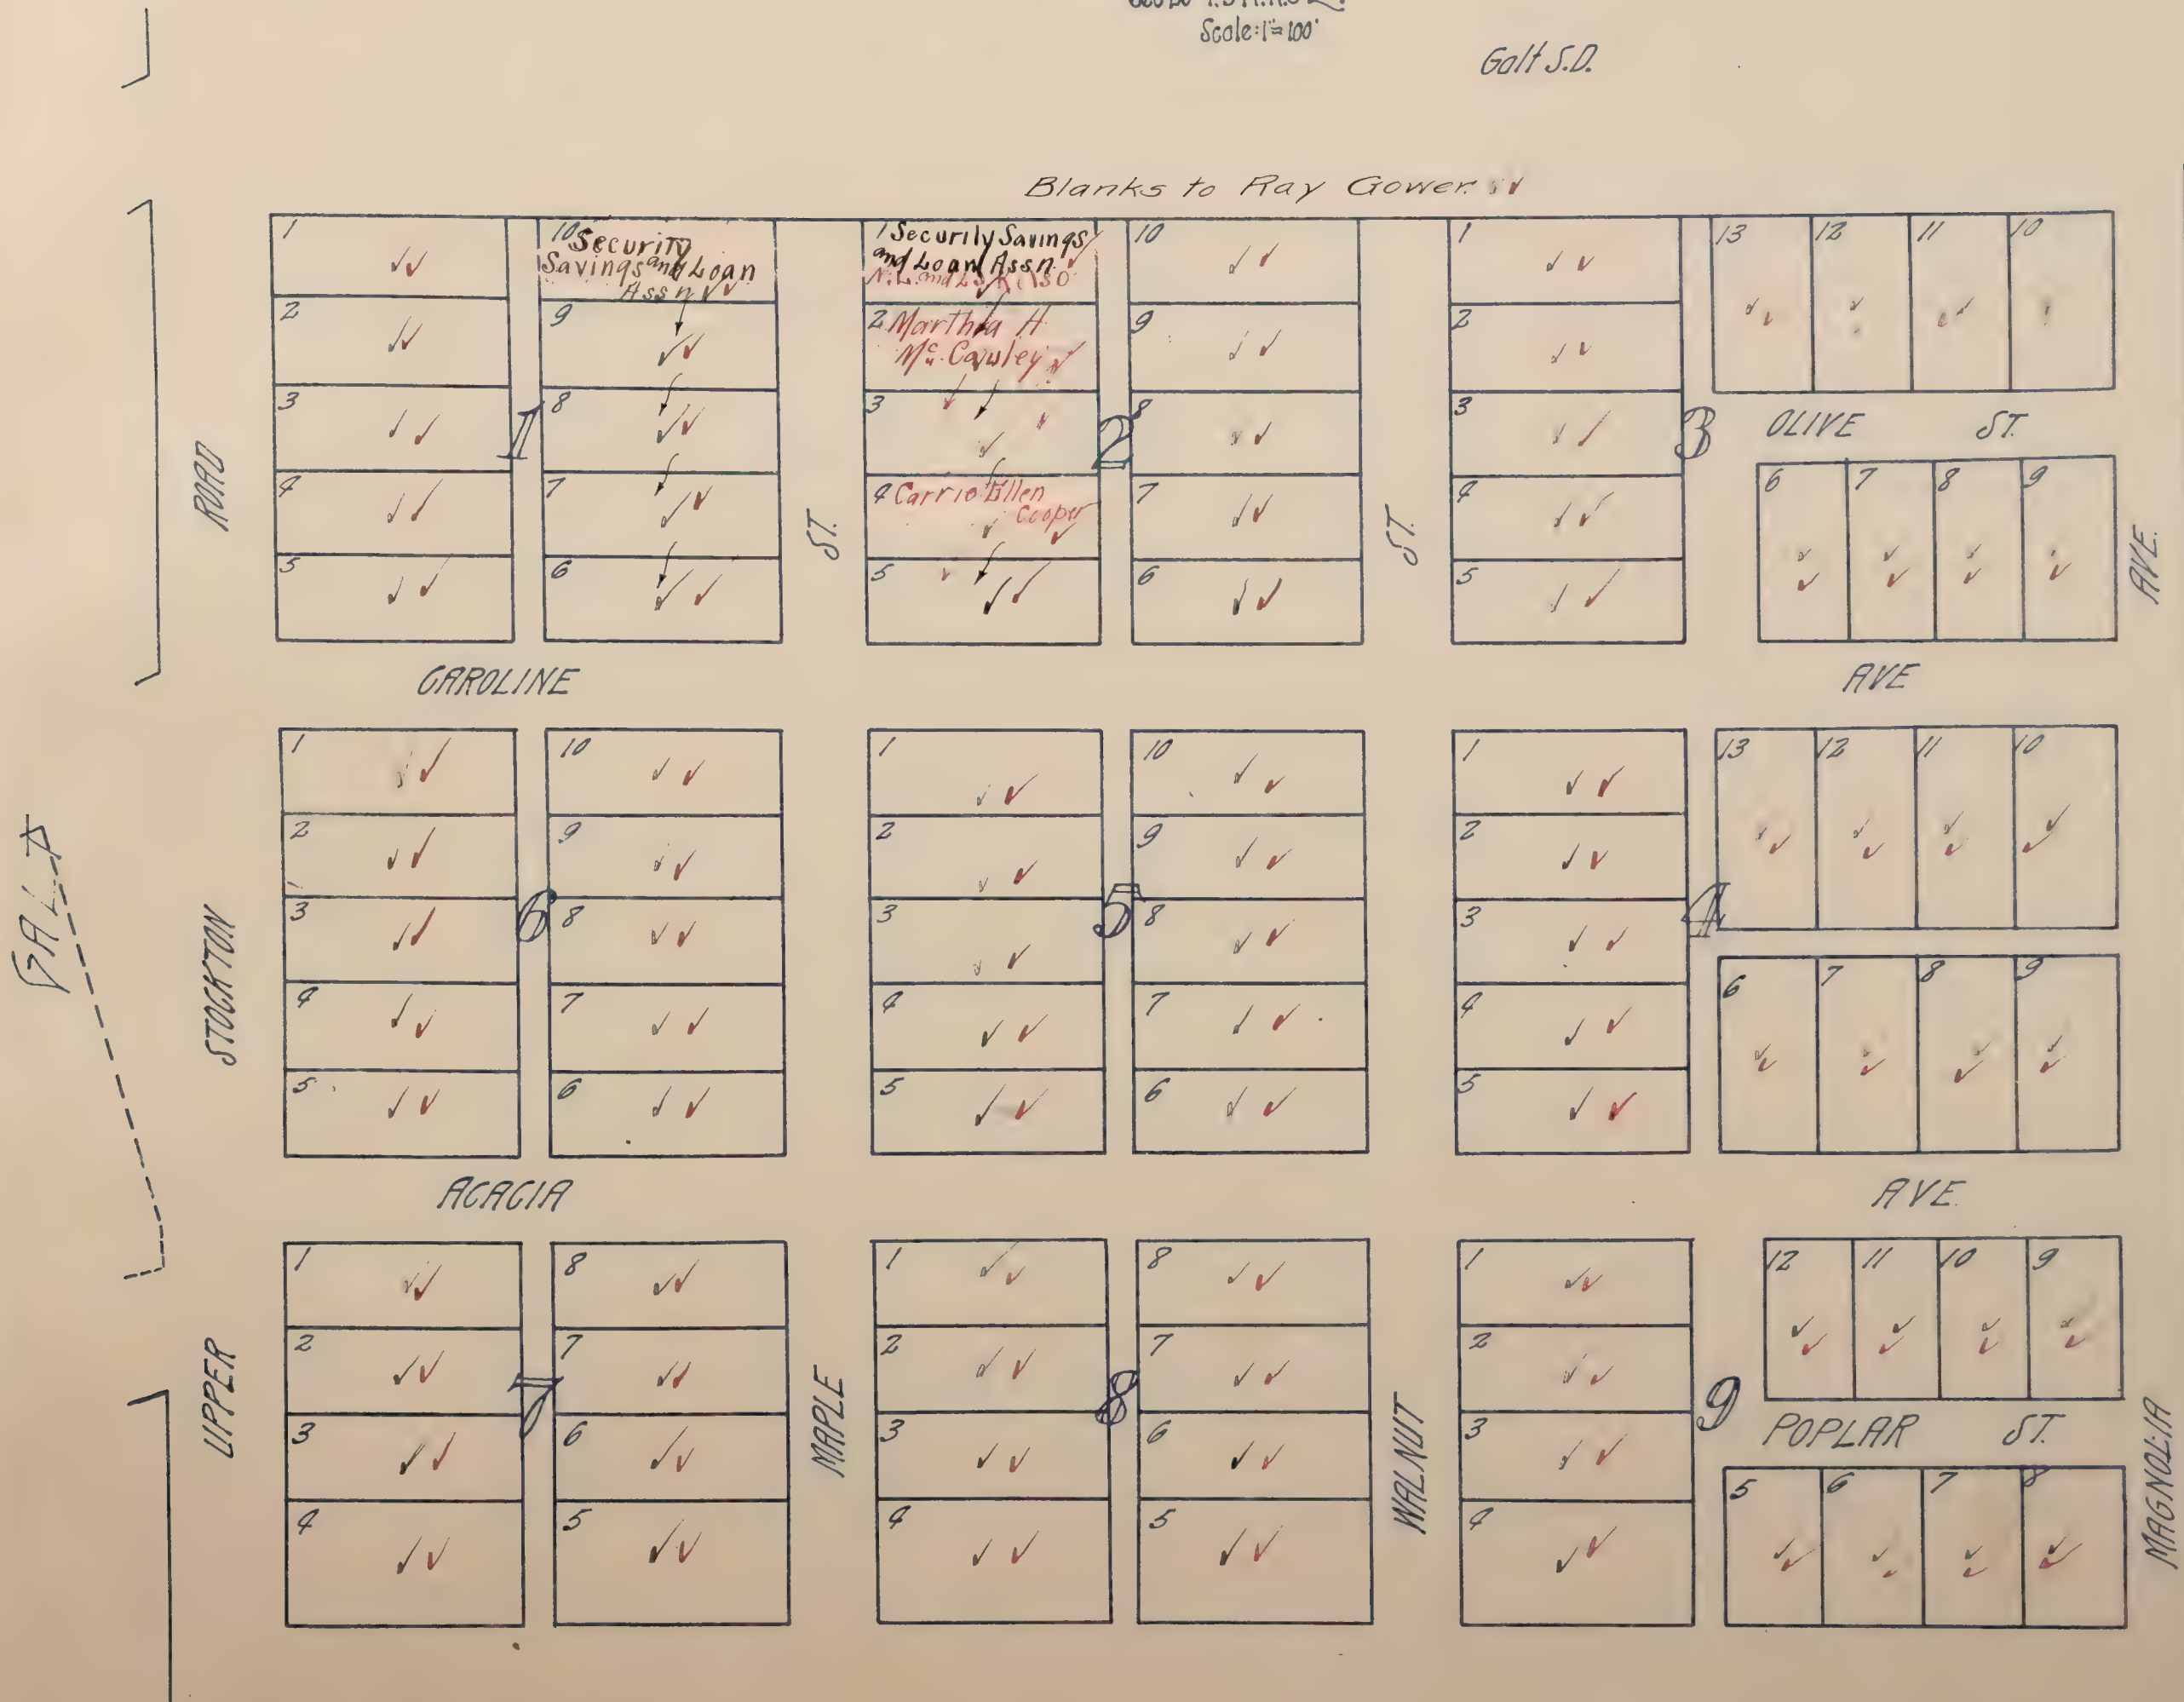


Black Ink-1919 Ownership
Red Ink-1920 Ownership
WHITAKER SUBD. NO. 1
LOCATED IN
Secs. 14, 15, 22 & 23, T5N., R.6E., M.D.B. & M.
Scale: 10 Chs. = 1"

Go. 7 S.D.

Blanks assessed to H. McCloughry. ✓✓

All Lots 20 Acres unless otherwise marked

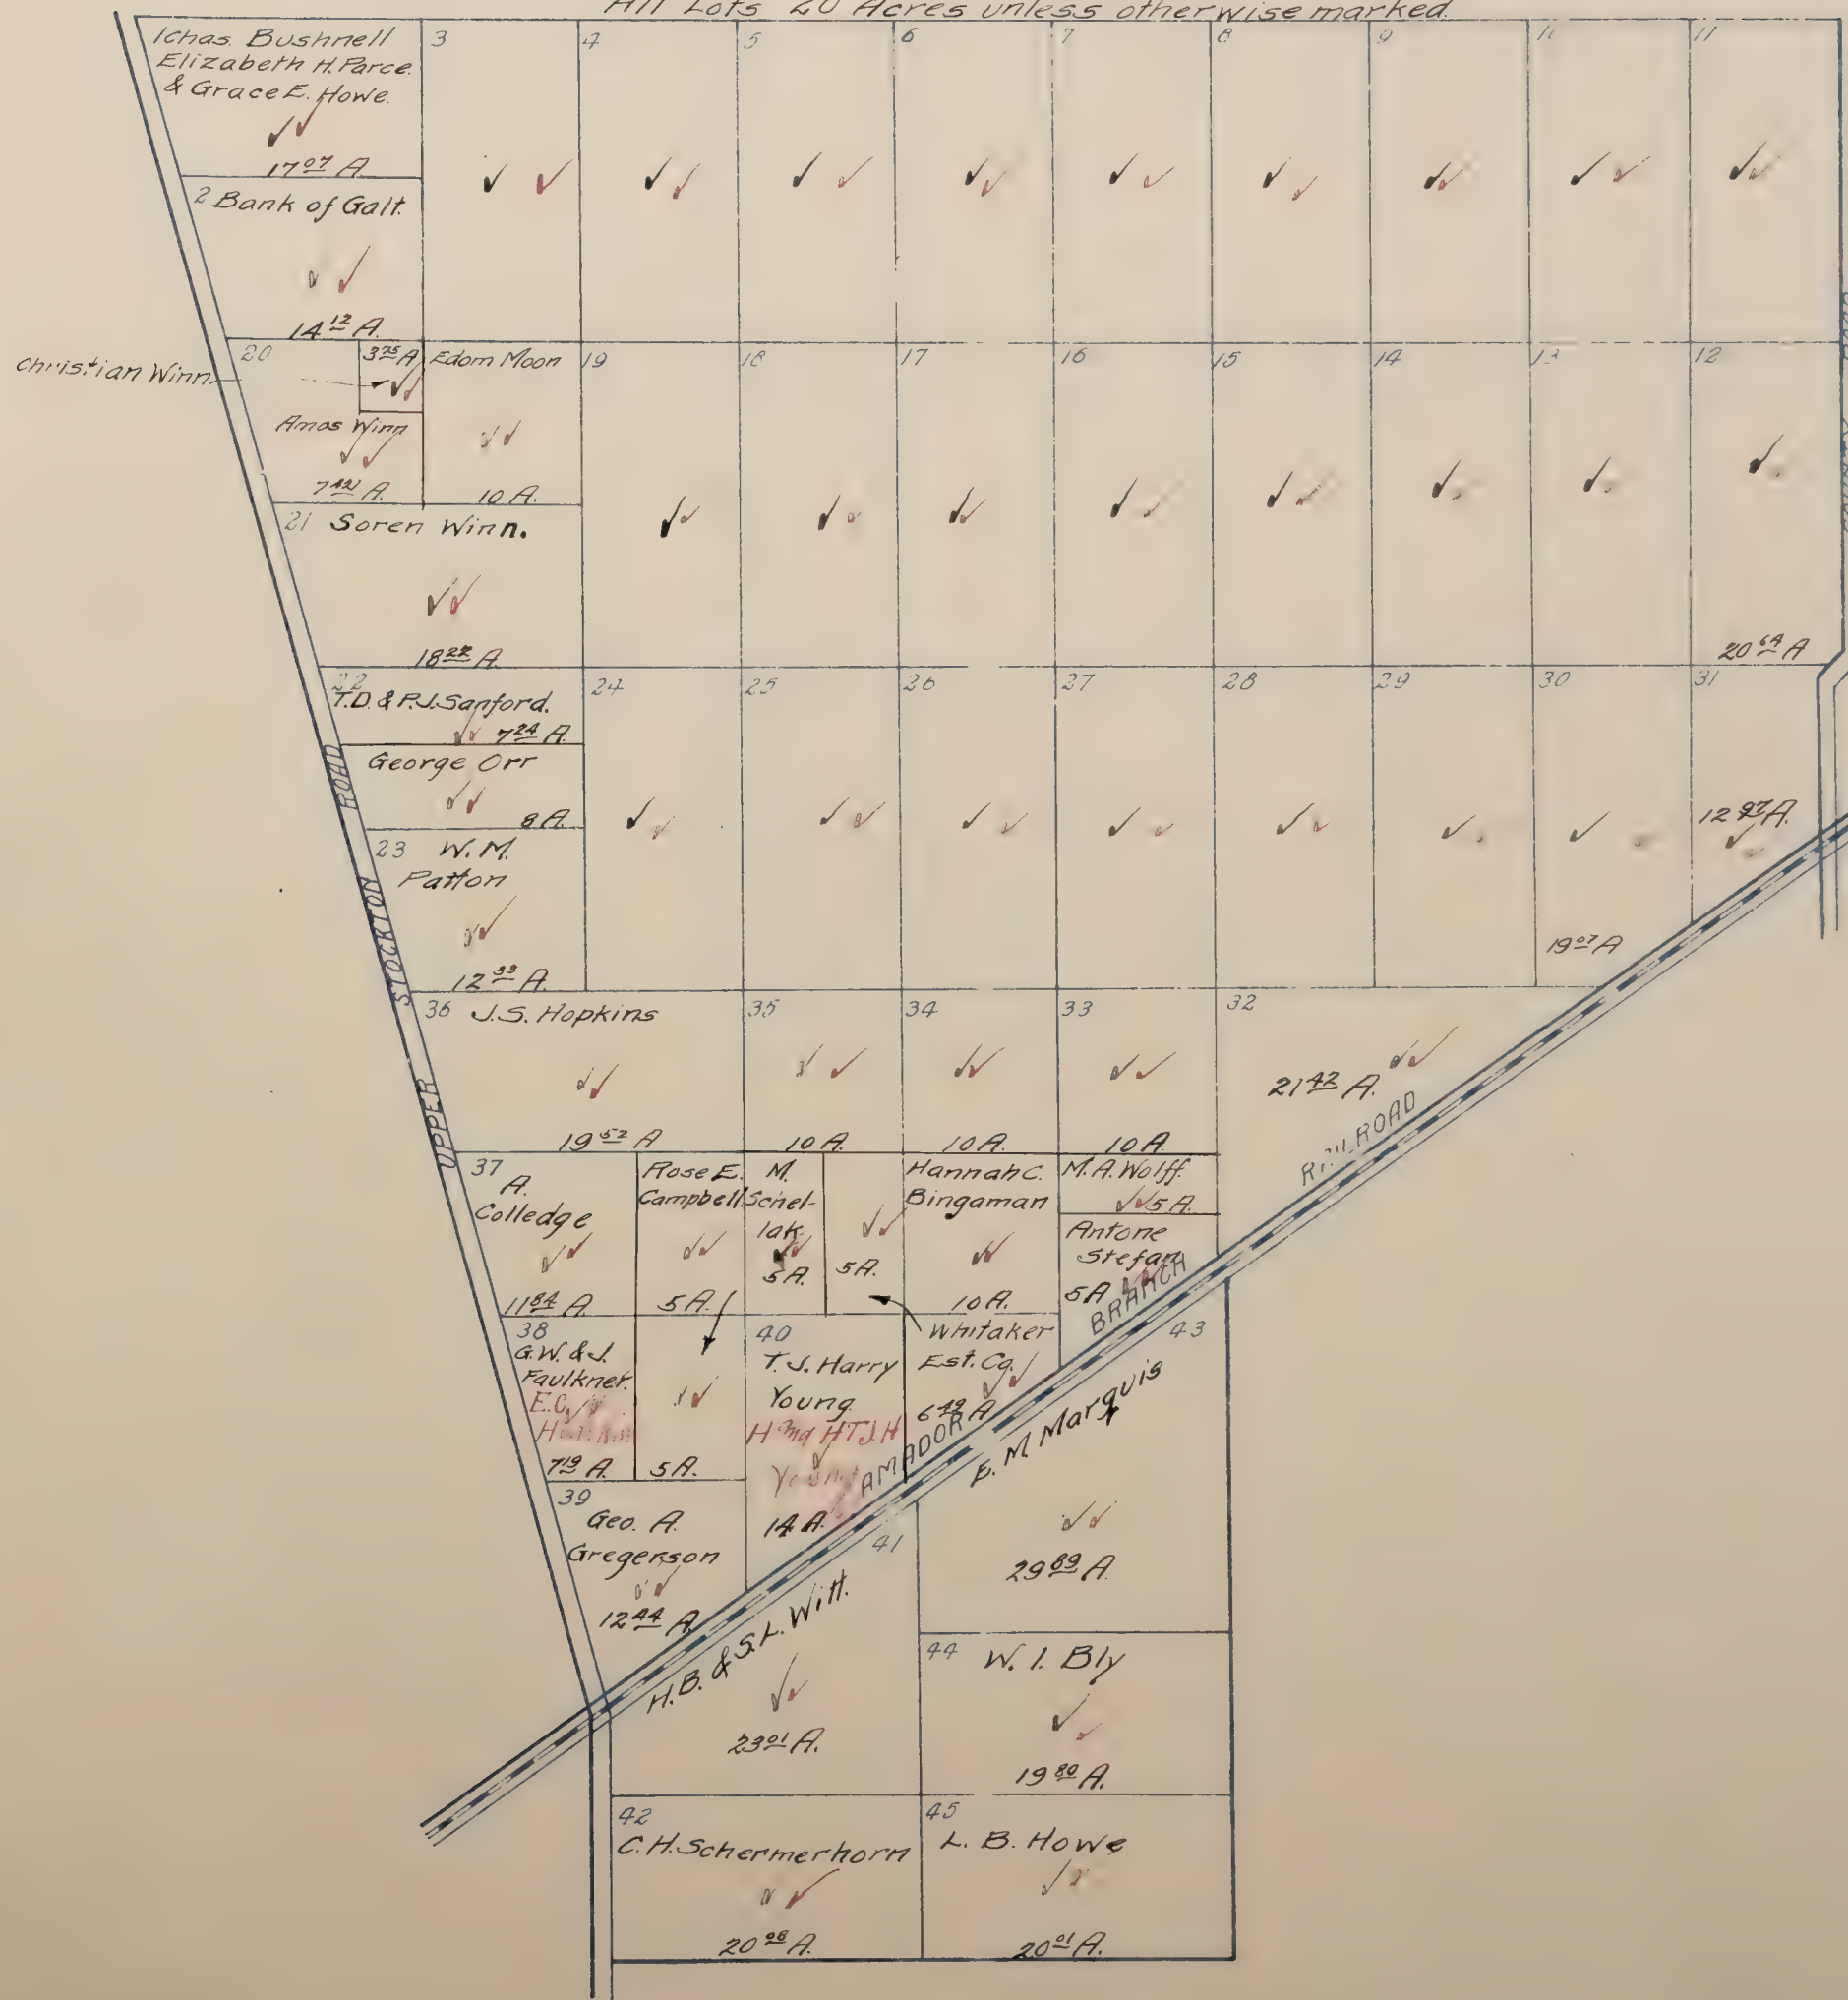

Mapped.


Black Ink-1919 Ownership
Red Ink-1920 Ownership

WILTON

located in
Section 16, Township 45 North, Range 12 East
County of Wilton, North Dakota

Dillard
1919

Blanks to the Cosumnes Co. ✓✓

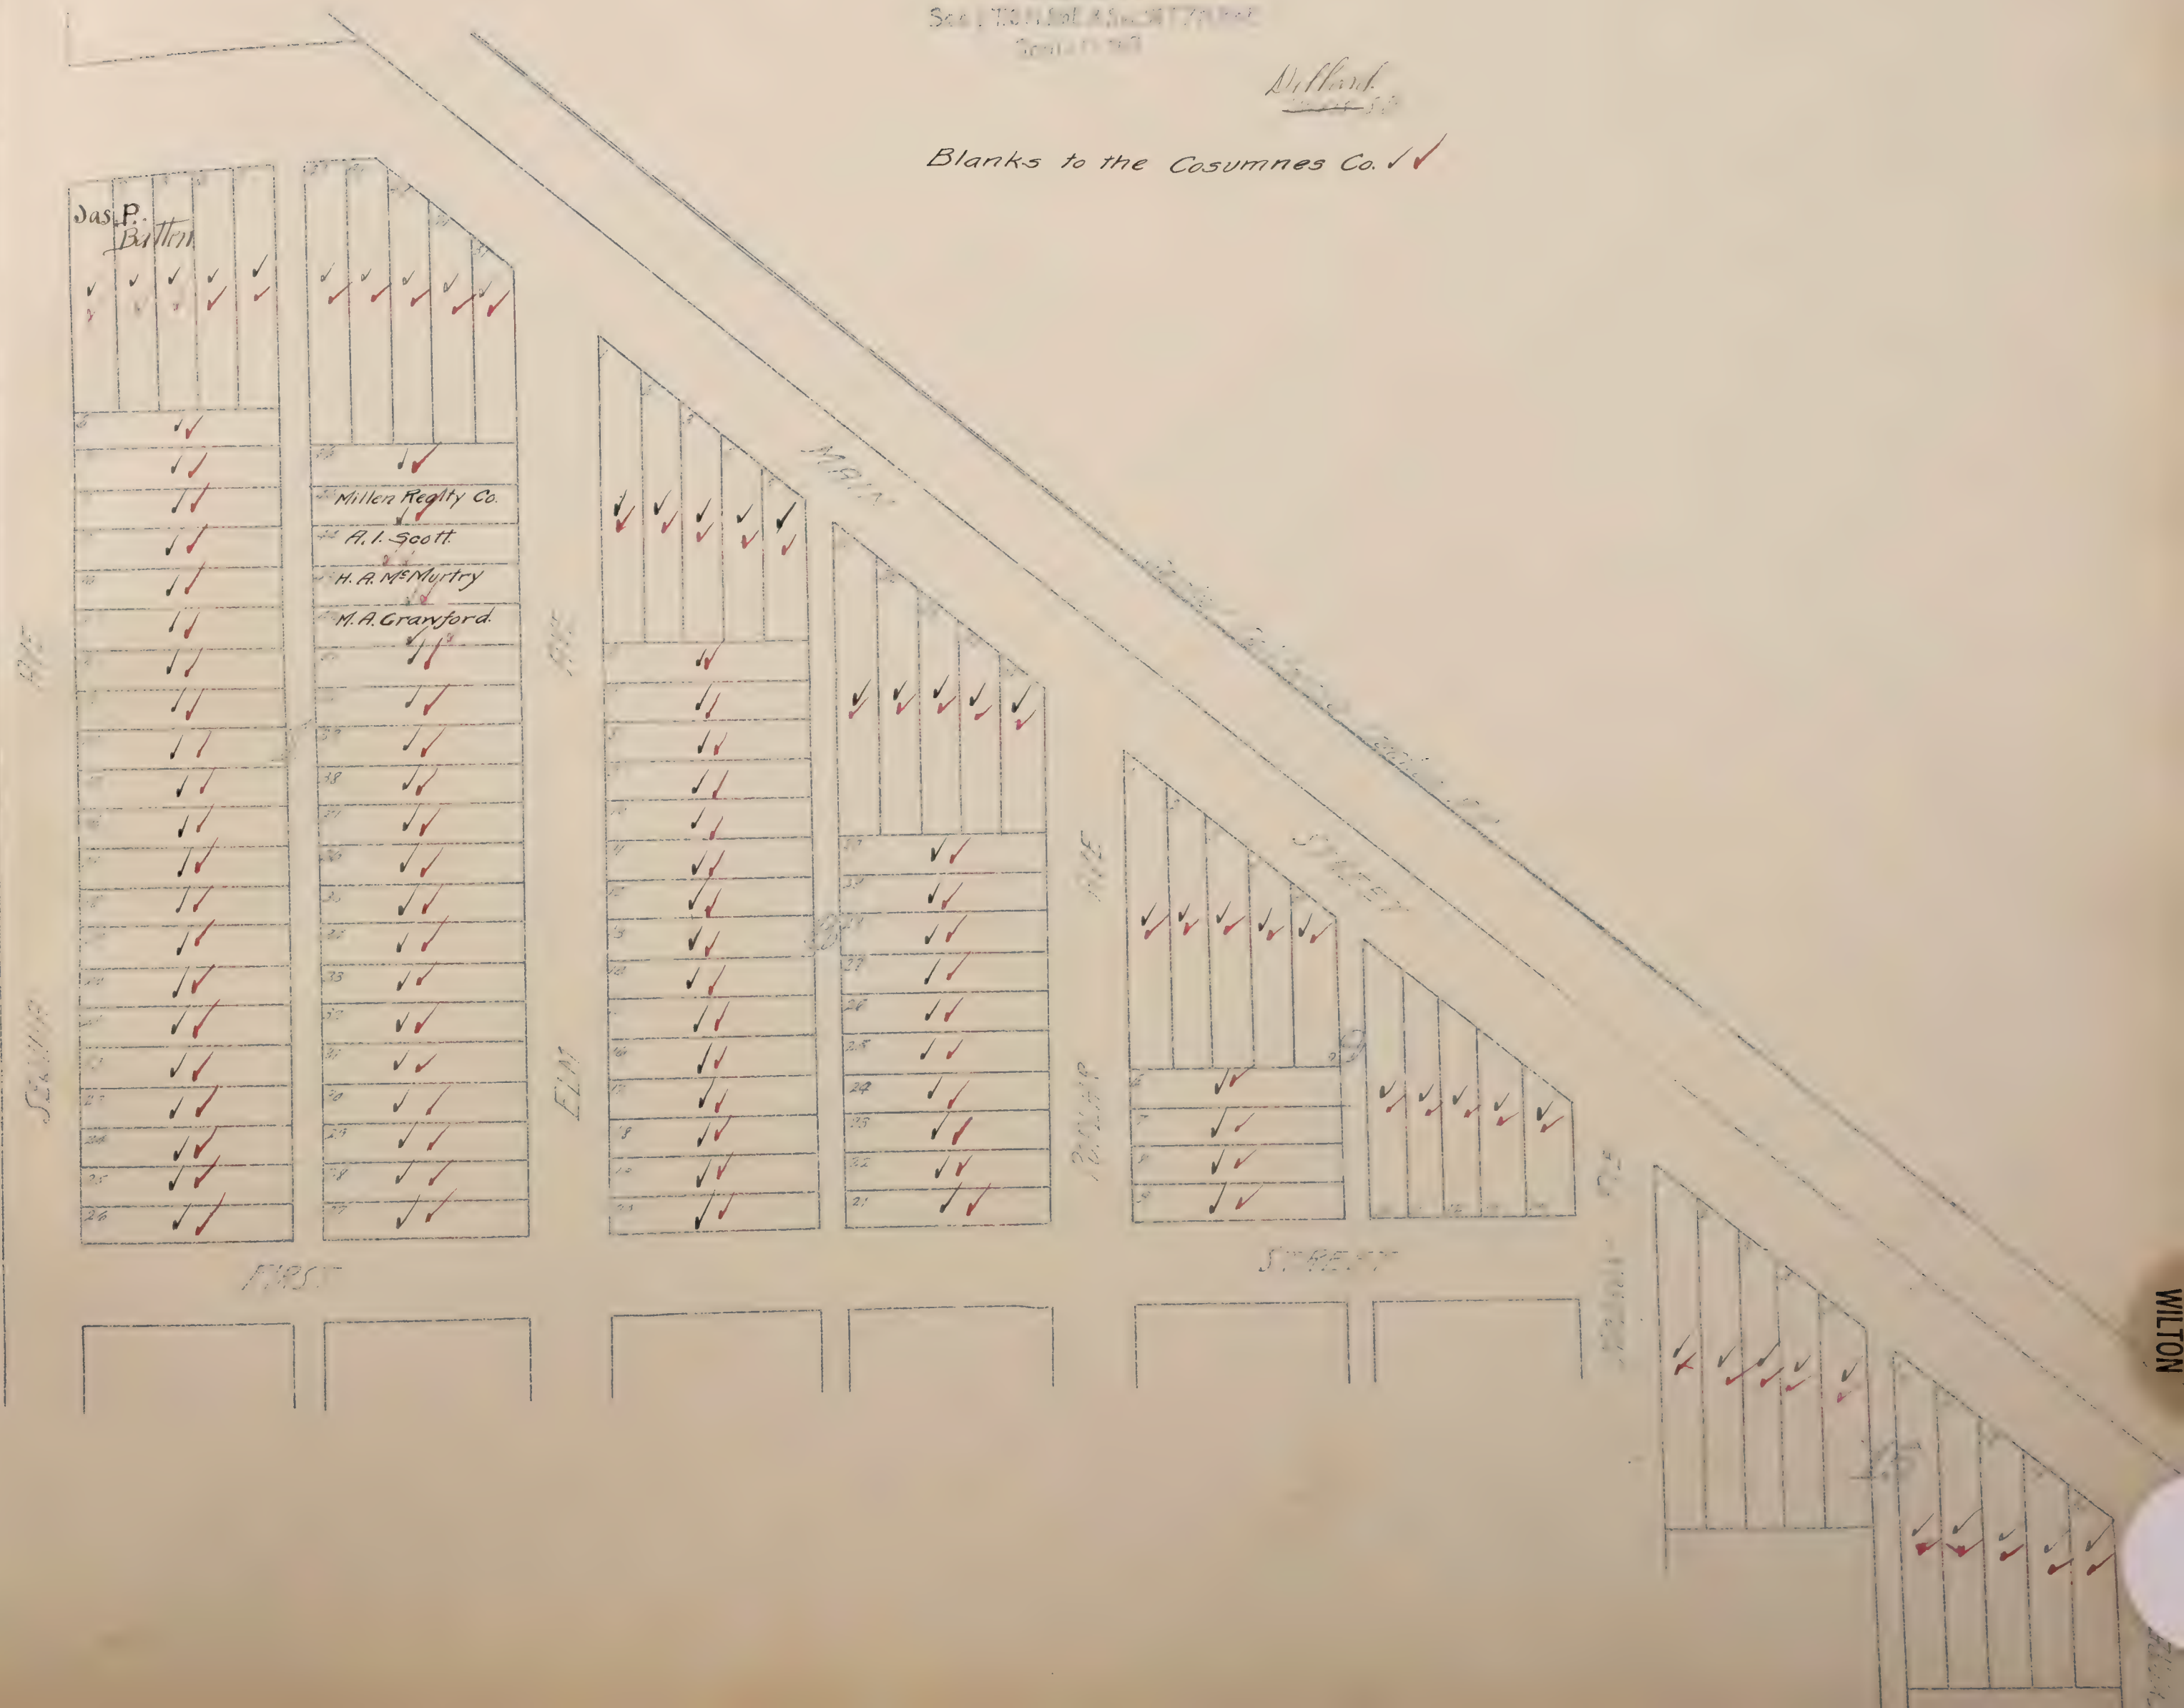

Mapped.


Black Ink-1919 Ownership
Red Ink-1920 Ownership

WILTON

located in
Sec 1 T.6N.R.6E. & Sec 36 T.7N.R.6E
Scale 1" = 150 ft

*Difficult
Davis SD.*

Blanks to the Cosumnes Co. ✓✓

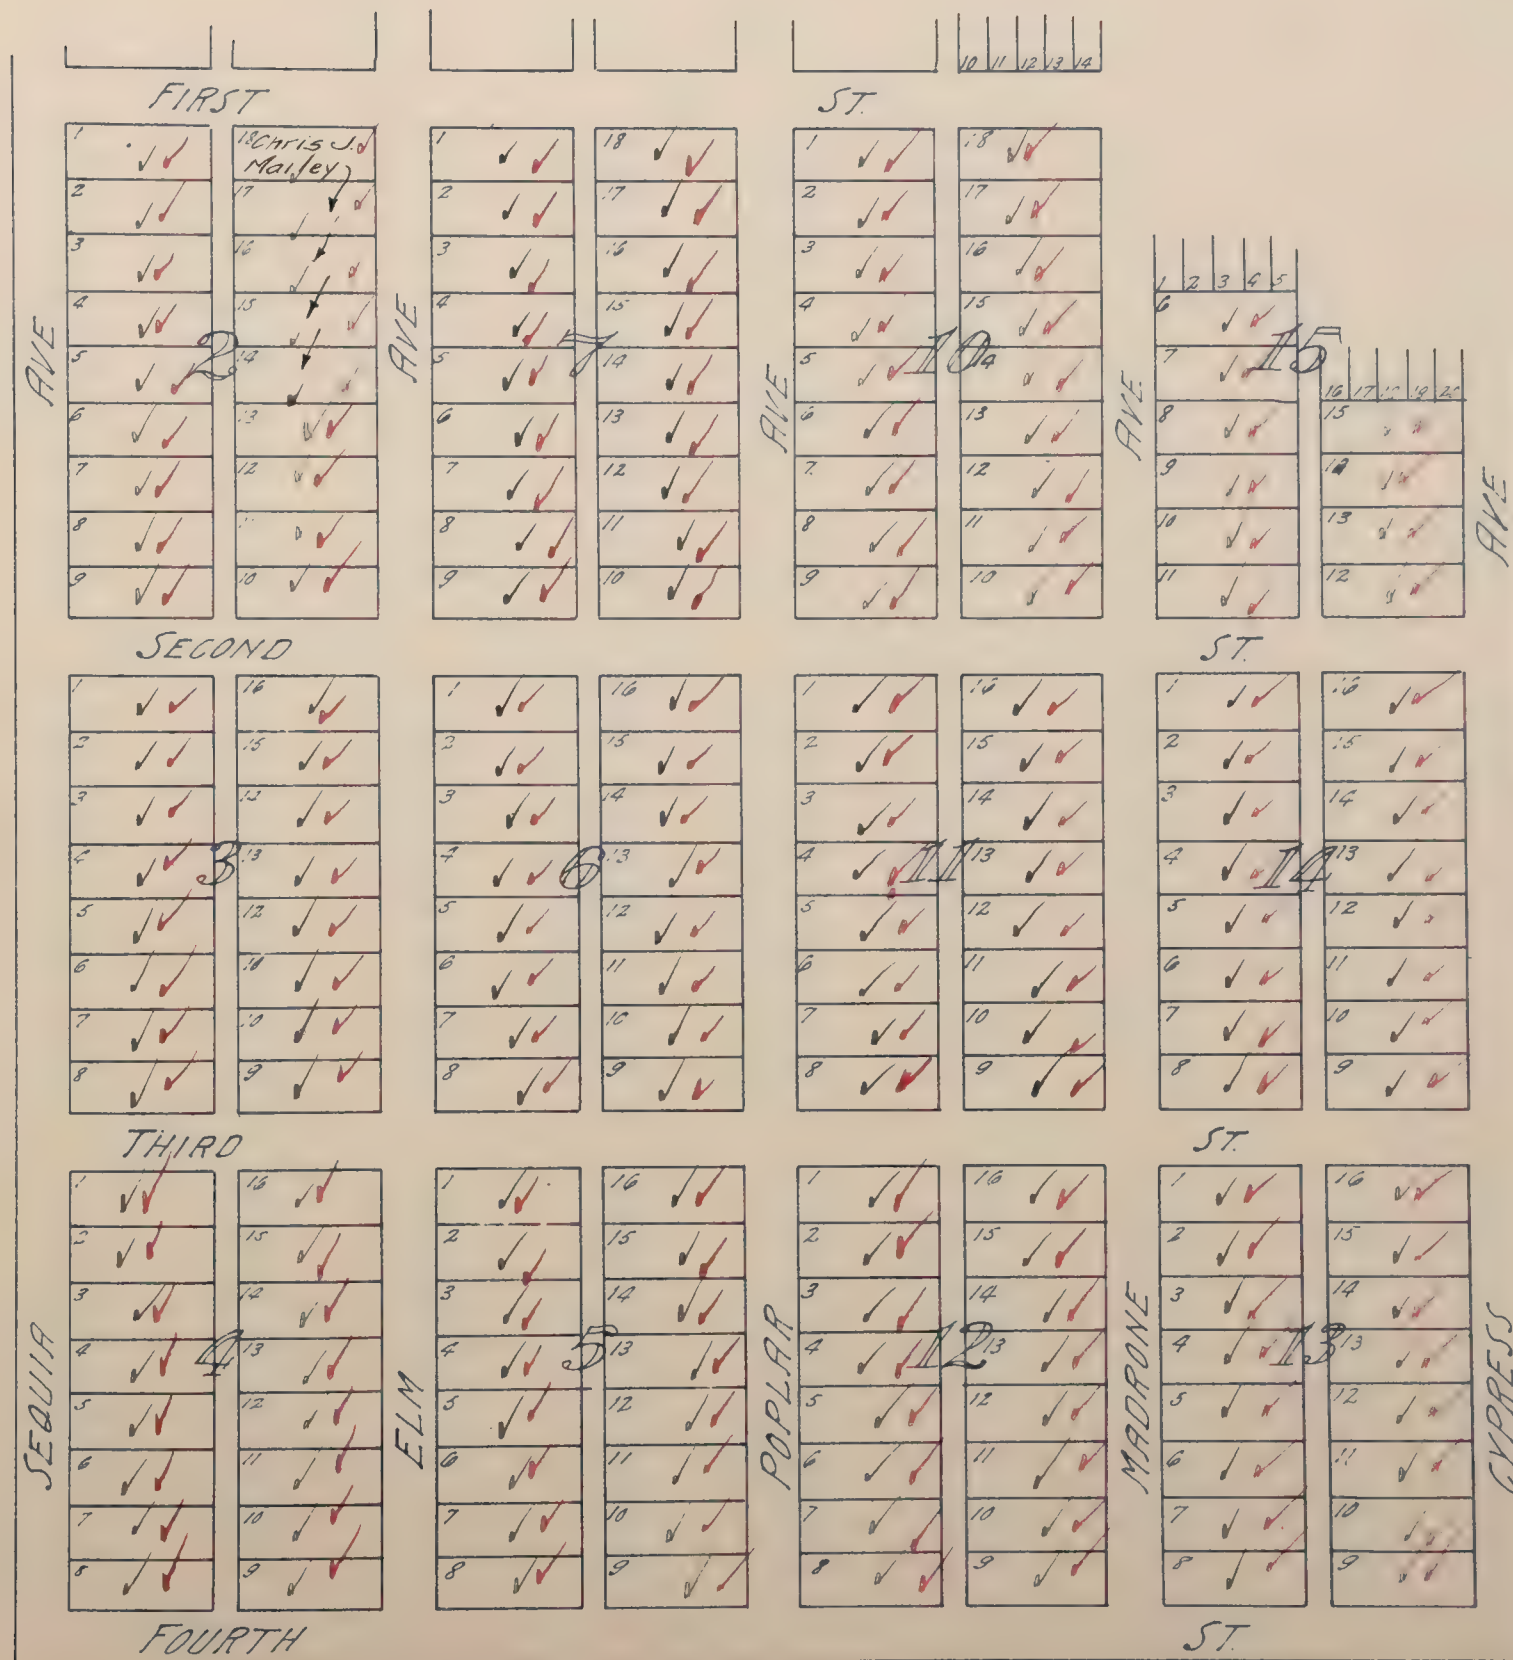

Enterprise S.D.

Pres. S.D.



Black Ink-1919 Ownership
Red Ink-1920 Ownership

WRIGHT & KIMBROUGH N°2

SECTION 31 T. 8 N. R. 6 E.

Scale 6 chains = 1 inch.

Enterprise S.D.

Annie McCartney ✓ 6 A.	P. A. Creason ✓✓ 4 A.	Emma Simmons ✓ 2 A.	Fred Bank ✓✓ Elvira Tennison 8 A.	Giannotti Gervisao ✓ 10 A.	Geo. Mischler Paul Jean ✓✓ 2 A.
Peter Sharow ✓✓ 20 A.			John De Schroeder ✓✓ 2 A.		
Margaret A. M. Talbot Christian Wiese ✓✓ 14 A.	10 A.	10 A.	Paul Jean ✓✓ 10 A.	Horner K. Wissler ✓✓ 2 A.	

WRIGHT AND KIMBROUGH COLONIES

S.W 1/4 SEC. 6 T.7 N. R. 6 E.

Scale, 8 chains = 1 inch

Black Ink-1919 Ownership

Red Ink=1920 Ownership

No 5

ENTERPRISE S. D

Jno Morris. ^{6.1}	Perle F. ^{6.1} Clark	W ^{7.1} Flomer. ^{6.1}	Ida Barker. ^{6.1}
✓	✓	✓	✓
10 A	10 A	10 A	10 A
D.W. Fidenoot ^{6.1}	A.L. ^{6.1} Weidemann	Jas. N. ^{6.1} Bostick	Mary E. ^{6.1} Robinson. Mary E. Cov ^{6.1}
✓	✓	✓	✓
10 A	10 A	10 A	10 A
Jas. H. Seare ^{6.1}		A. C. Duncan ^{6.1} 10 A.	L. C. Reese ^{6.1}
✓	✓	✓	✓
✓	✓	✓	✓
10 A	10 A	10 A	10 A

Black Ink-1919 Ownership
 1900 Ink-1919 Ownership

JACKSON S. D.

SEC. 12 T. 7 N.R. 5 E.

Scale 6 chains=1 inch

No 6

86	85	84	83	82	81	80	79
	Mary Davis.	Wm Meyer	Flora M. Taylor	J. Tootell.	H. H. Carlisle	H. H. and A. C. Carlisle.	
	✓✓	✓✓	✓✓	✓✓	✓✓	✓✓	✓✓
	10 A.	10 A.	10 A.	10 A.	10 A.	10 A.	11 A.
87	86	85	84	83	82	81	80
	John A. Serpa	Flora M. Taylor	D. Reese	Geo. W. Carlisle	Western Loan Co.	Lillian E. Casselman	
	✓✓	✓✓	✓✓	✓✓	✓✓	✓✓	✓✓
	183 A.	10 A.	10 A.	10 A.	9 A.	10 A.	10 A.
101	100	99	98	97	96	95	94
	H. L. and O. E. Hendricks.	Elizabeth O'Neill	G. E. and G. Carlisle	C. B. Perdy	Winifred M. Byrne		
	✓✓	✓✓	✓✓	✓✓	✓✓	✓✓	✓✓
	123 A.	10 A.	10 A.	10 A.	10 A.	10 A.	10 A.
102	101	100	99	98	97	96	95
	A. W. Stowell.	Foy L. Brooke	Rose Kell.	G. E. and G. Carlisle			
	✓✓	✓✓	✓✓	✓✓	✓✓	✓✓	✓✓
	124 A.	10 A.		10 A.	10 A.	10 A.	10 A.

Mapped.

Black Ink-1919 Ownership
Red Ink-1920 Ownership

WRIGHT AND KIMBROUGH COLONY No 7

SEC'S 18 & 19 T. 7 N. R. 6 E.


Scale, 8 chains = 1 inch.

JACKSON S. D.

Geo. H. Chappell. ✓✓ 10 A John Cepit ¹⁰⁹ ✓✓ 10 A	Thos. F. ¹¹⁰ Connelly ✓✓ 20 A	F. G. Swear- inger. ✓✓ 10 A	D. E. ¹¹¹ Andrews. ✓✓ 10 A	Egerton R. Clark ✓✓ 10 A	112 ✓✓ 10 A
John W. Engle ¹¹⁶ ✓✓ 10 A	W. C. Delfs. ¹¹⁵ ✓✓ 10 A	Annie M. Francias. ✓✓ 10 A	Thos Jelfs. ¹¹³ ✓✓ 10 A	Edw. F. ¹¹⁷ Kappler. C. M. H. C. Erikson. ✓✓ 10 A	Paul Chovet. ¹¹⁸ ✓✓ 5 A
Edw. F. ¹¹⁷ Kappler. C. M. H. C. Erikson. ✓✓ 10 A	✓✓ 10 A	Mary E. Peasley. ¹¹⁹ ✓✓ 5 A	120 ✓✓ 10 A	Fred A. Kappler. C. M. H. C. Erikson. ✓✓ 10 A	Helen C. De Groff. ¹²³ ✓✓ 10 A
✓✓ 10 A	✓✓ 10 A	Chas. J. Merseraux. ¹²¹ ✓✓ 10 A	Gustave Kappler. ✓✓ 10 A	Gustav Maslich. ¹²⁶ T. Charles ¹²⁴ W. W. Wright. ✓✓ 10 A	W. W. Wright. ✓✓ 10 A
✓✓ 10 A	J. Melvin Brown. ¹³¹ ✓✓ 20 A	Chas. Servas. ¹³⁰ ✓✓ 10 A	Ed. A. Jones. ¹³³ ✓✓ 10 A	✓✓ 10 A	✓✓ 20 A

~~Rock Grove S.D.~~

Blanks to T. Wah Hing.

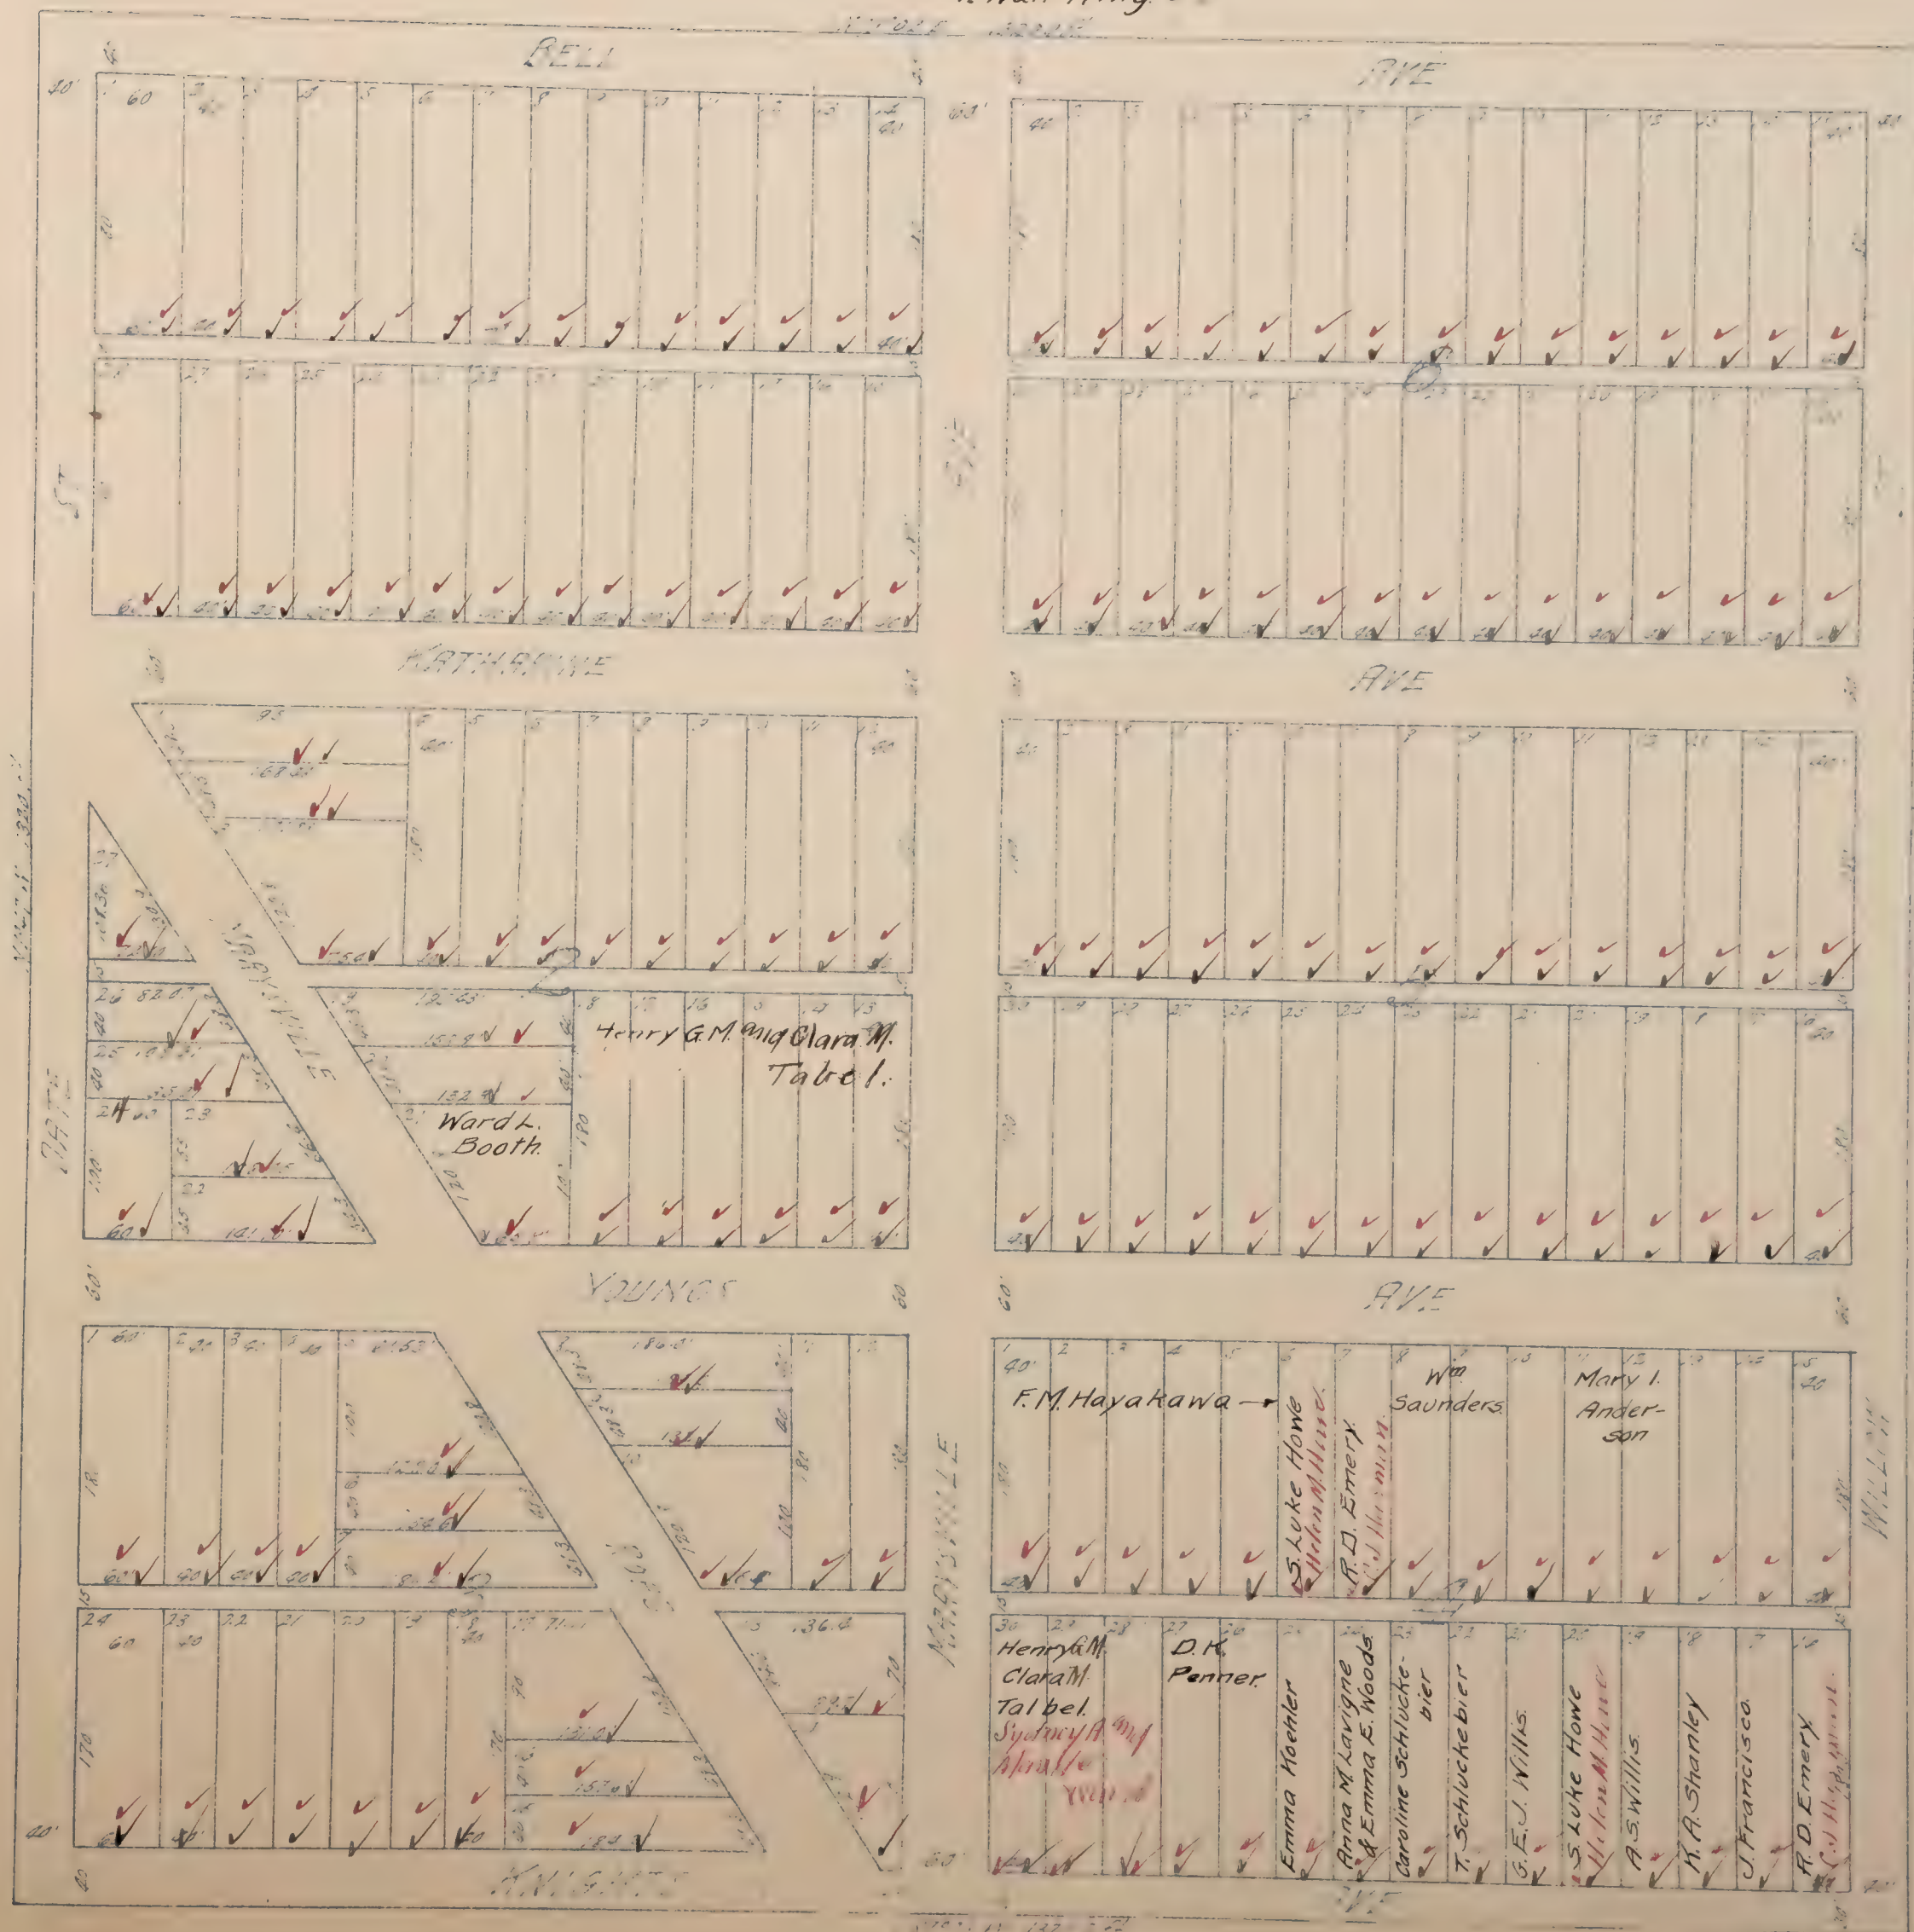

Mapped.

Black Ink-1919 Ownership
Red Ink-1920 Ownership

ZETZ SUBDIVISION

FRAC'L. PART OF LOT 20, LOUISIANA TRACT

Scale: 1 inch = 80 feet

Blanks assessed to { S. Stone ✓
Calif Natl Bank ✓

Fruit Ridge S.D.

NATOMA AVE.	
27	✓
26	✓
25	✓
LAUREL AVE.	

